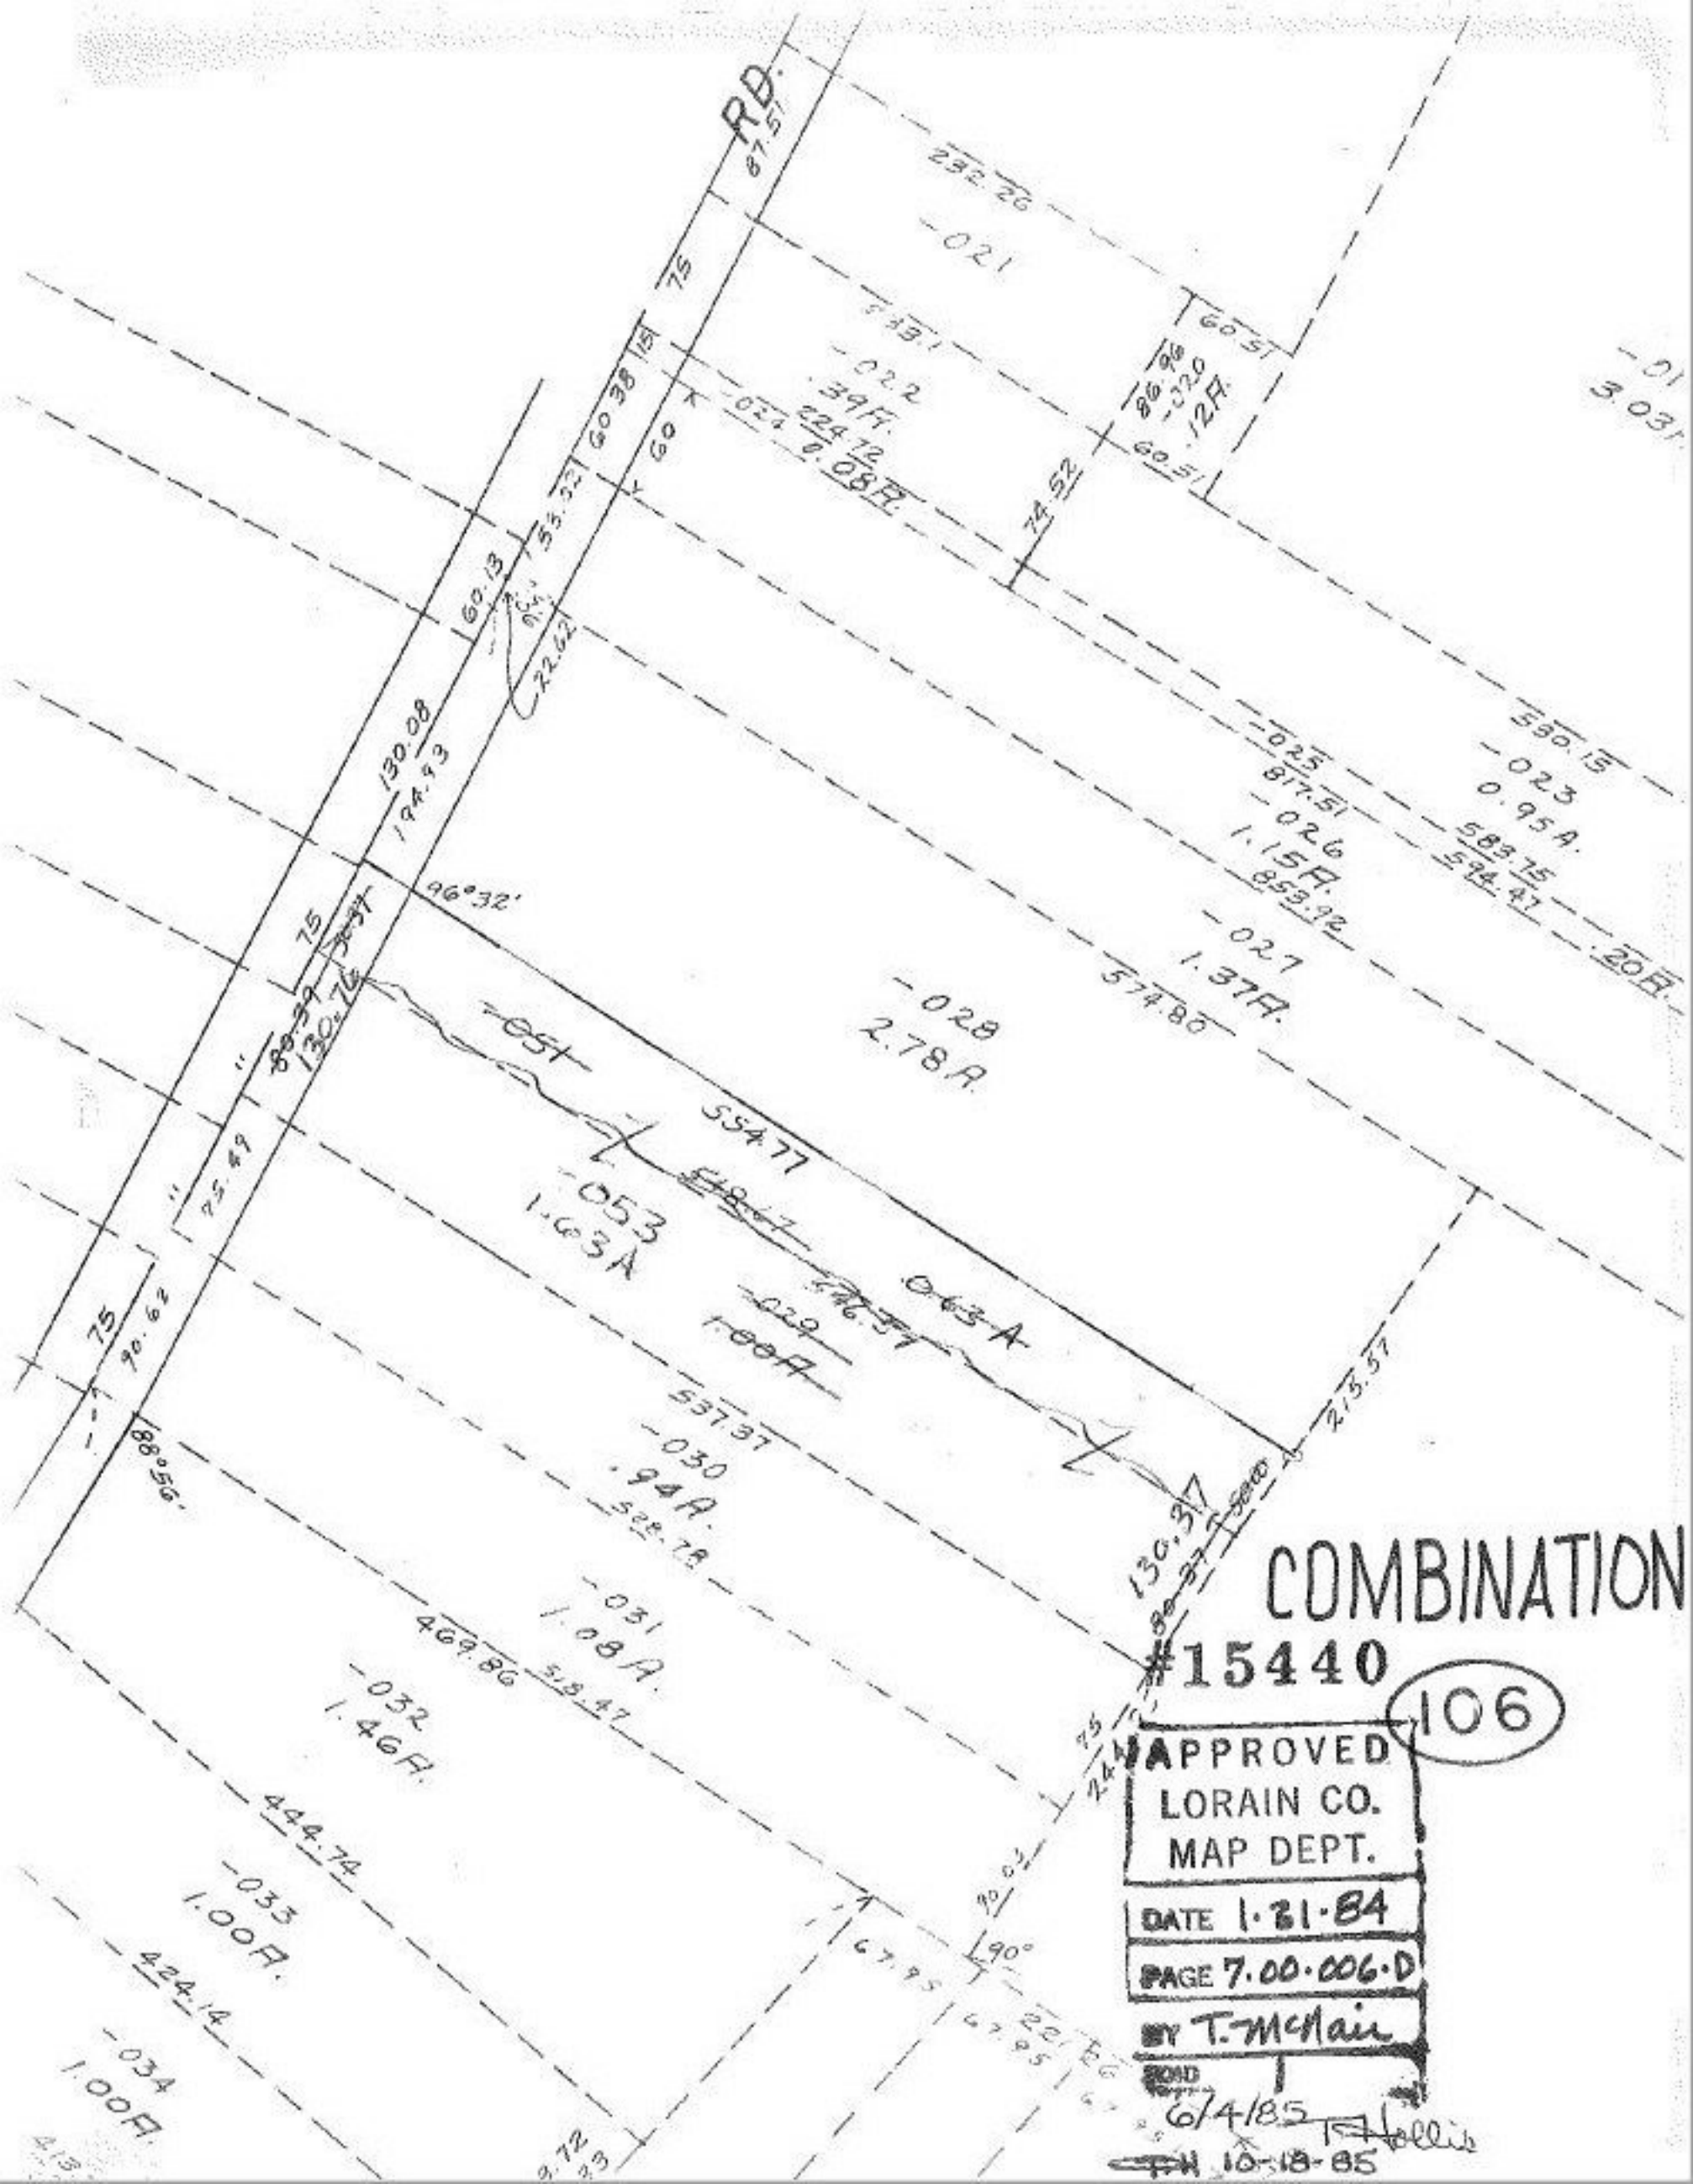
RD.
87.51
232.26
-021
-022
.39A.
224.72
0.08A.
60.51
86.96
-020
.12A.
74.52
60.38
60.13
22.62
130.08
194.93
96°32'
-025
817.51
-026
1.15A.
853.92
-027
1.37A.
574.80
-028
2.78A.
530.15
-023
0.95A.
583.75
594.47
.20A.
-051
554.77
-053
1.63A
-029
1.00A
-063A
537.37
-030
.94A.
528.78
-031
1.08A.
469.86
-032
1.46A.
444.74
-033
1.00A.
424.14
-034
1.00A.
88°56'
90°
215.57
130.37
COMBINATION
#15440
106
APPROVED
LORAIN CO.
MAP DEPT.
DATE 1-31-84
PAGE 7.00.006.D
BY T. McNair
6/4/85
10-18-85