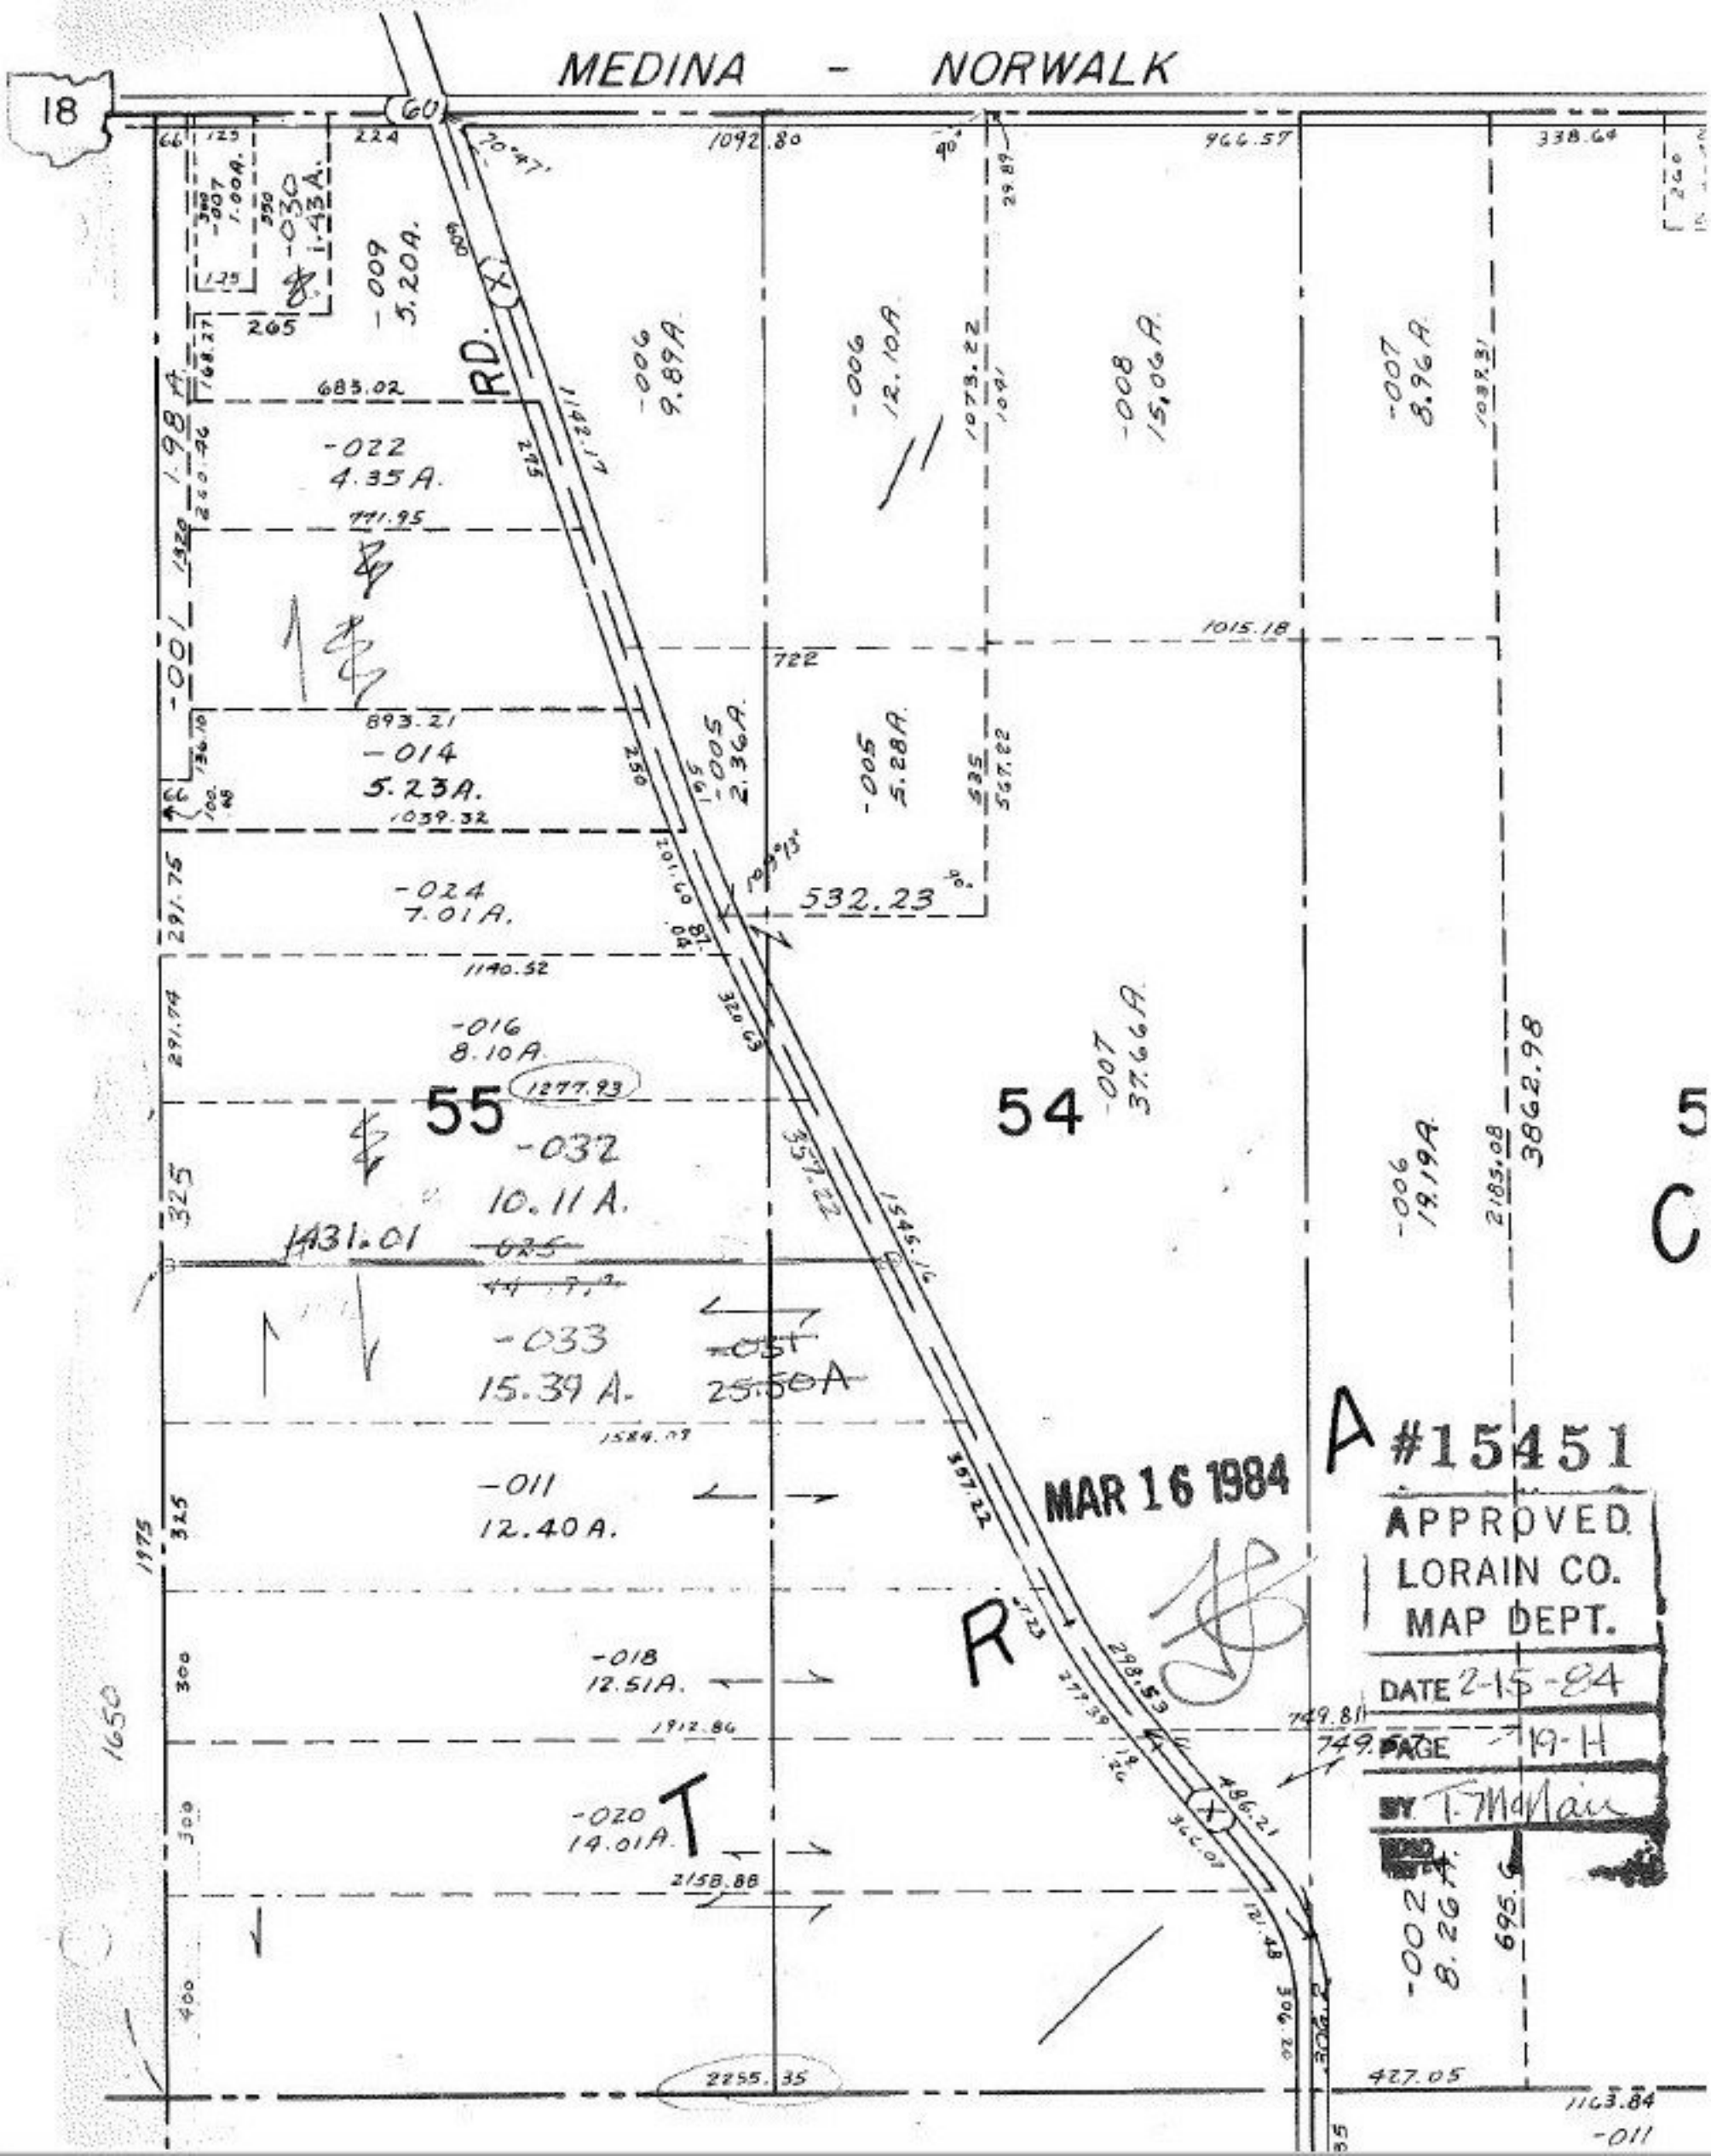

18
MEDINA - NORWALK
60
RD.
55
54
5
C
A
R
T
-009 5.20A.
-006 9.89A.
-006 12.10A.
-008 15.06A.
-007 8.96A.
-022 4.35A.
-014 5.23A.
-005 2.36A.
-005 5.28A.
-024 7.01A.
-016 8.10A.
-032 10.11A.
-033 15.39A.
-011 12.40A.
-018 12.51A.
-020 14.01A.
-007 37.66A.
-006 19.19A.
-002 8.26A.
-030 1.43A.
-001 1.98A.
1431.01
1277.93
532.23
1092.80
966.57
338.64
683.02
771.95
893.21
1039.32
1140.52
1015.18
722
1073.22
1039.31
3862.98
2185.08
1584.09
1912.86
2158.88
2255.35
427.05
1163.84
749.81
749.57
695.6
1650
1975
MAR 16 1984
#15451
APPROVED
LORAIN CO.
MAP DEPT.
DATE 2-15-84
PAGE 19-H
BY T. McNair