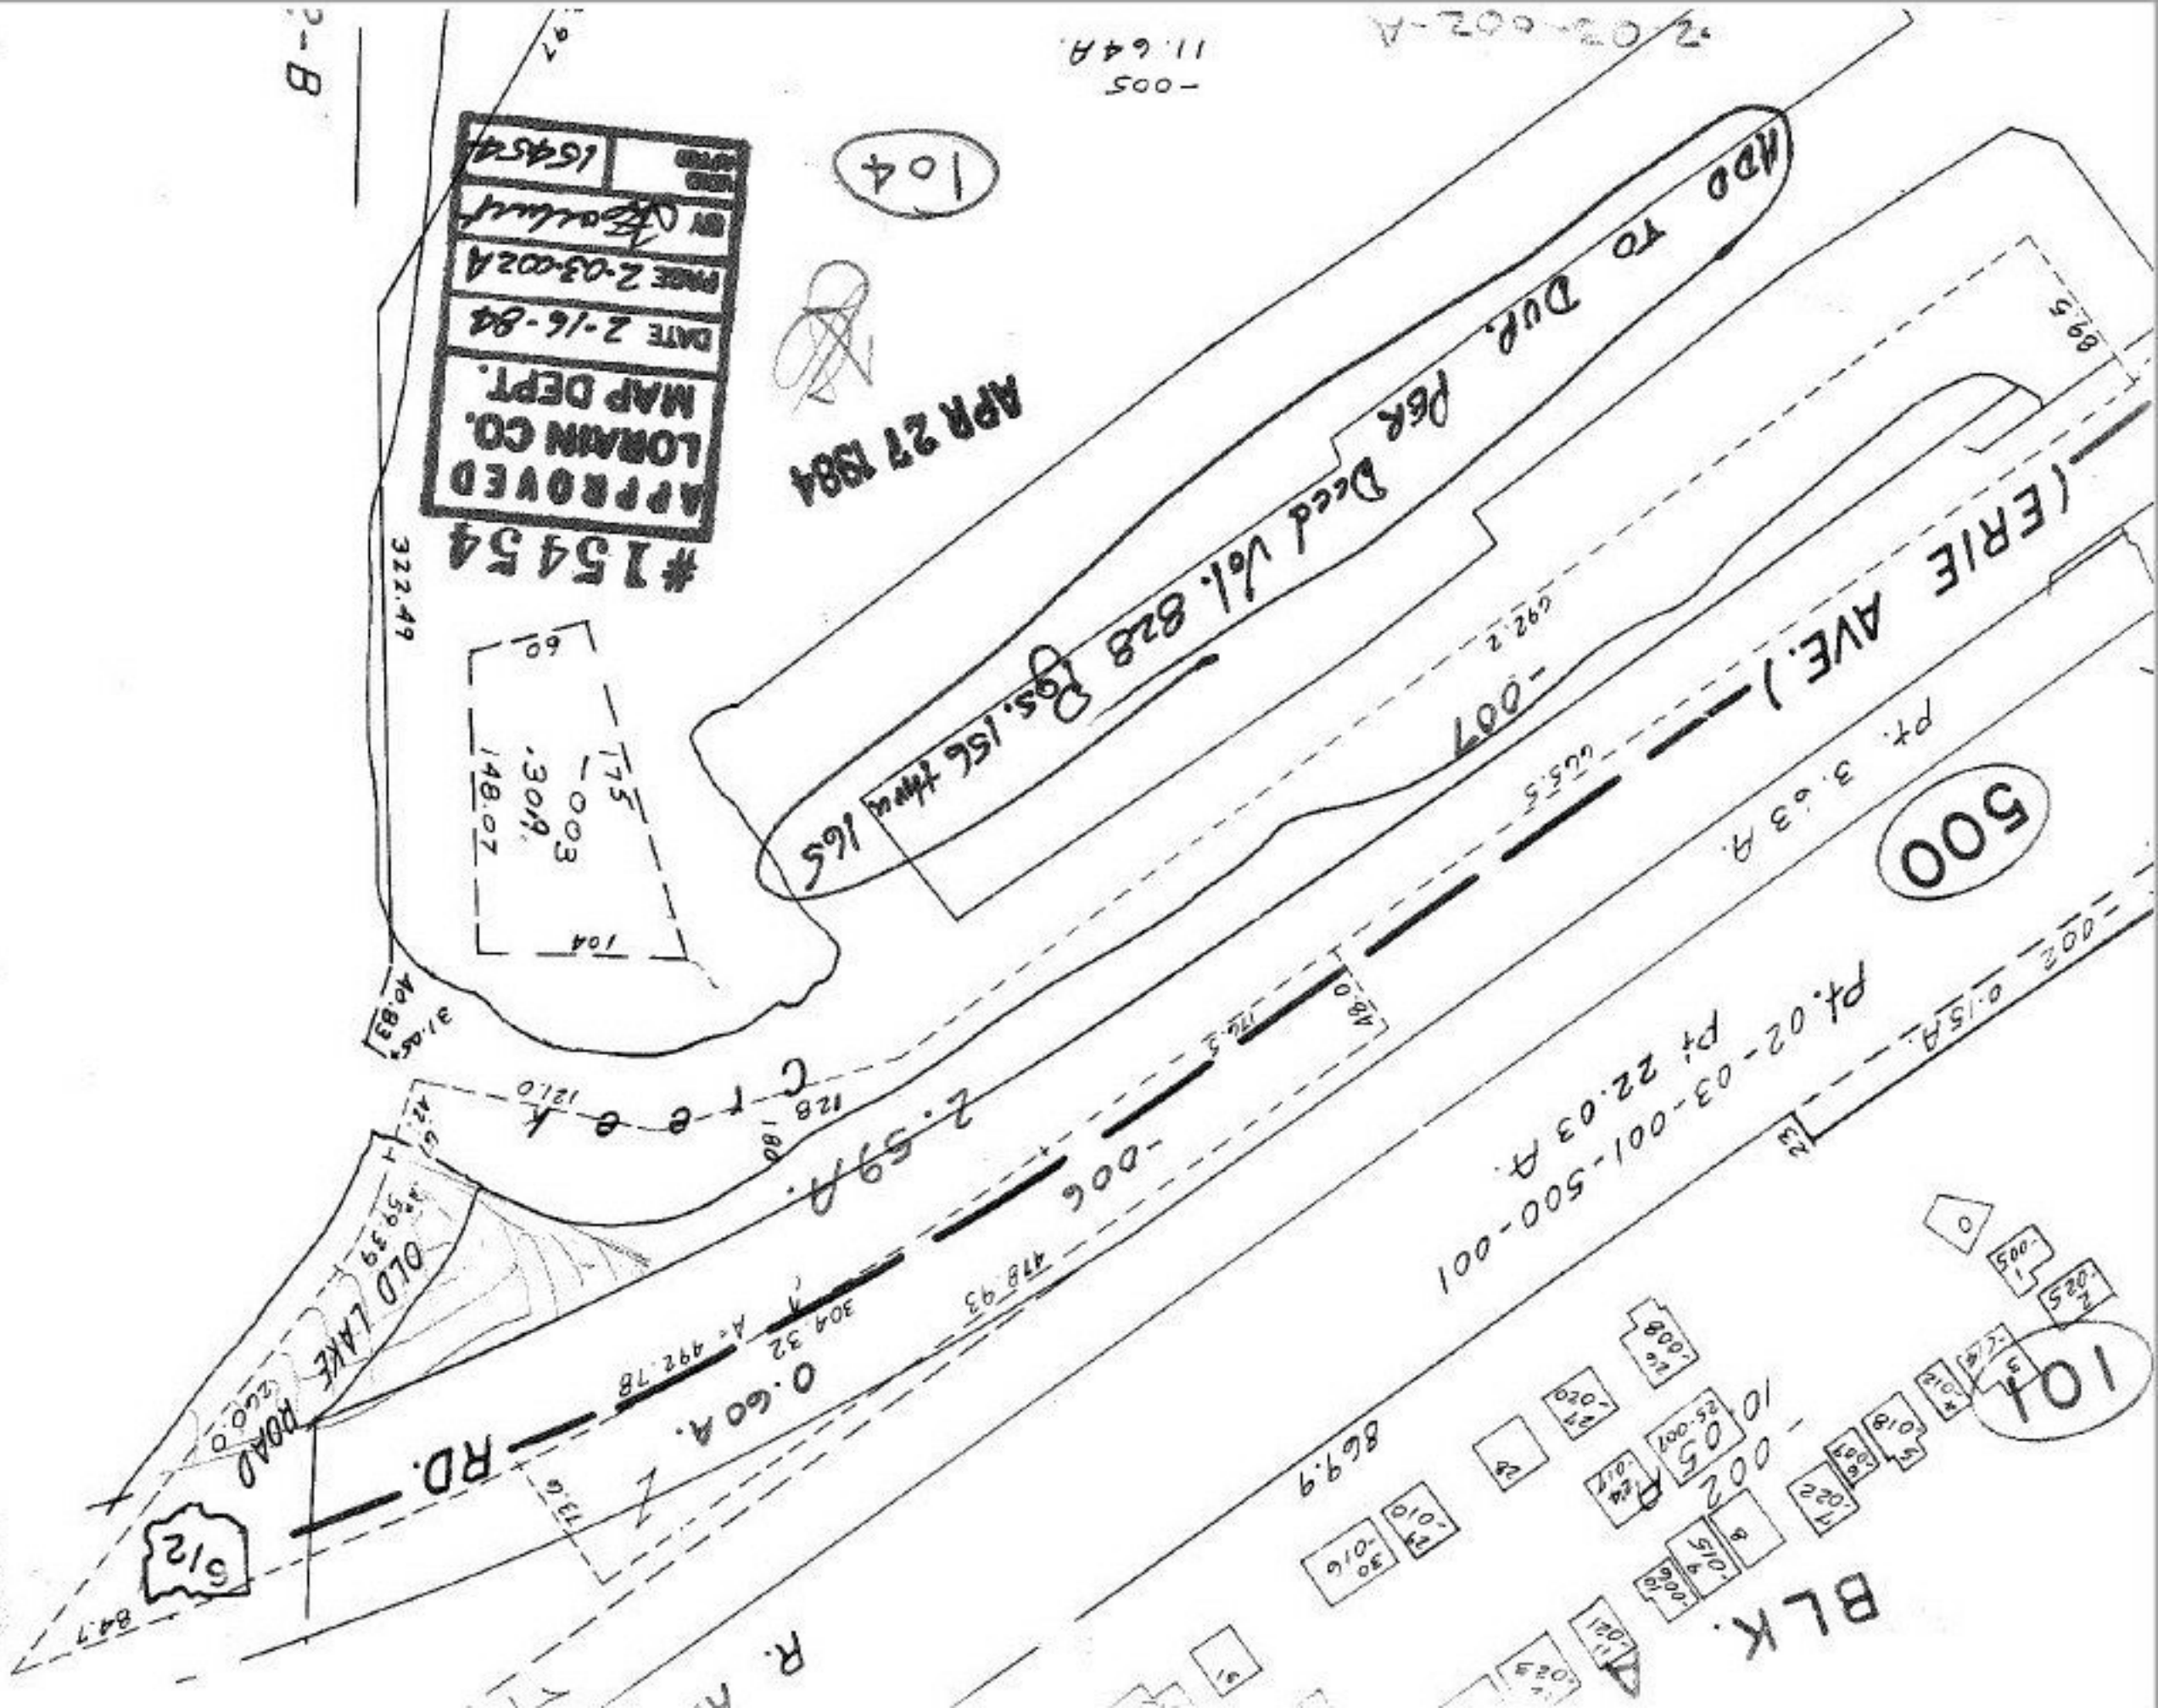

#15454
APPROVED
LORAIN CO.
MAP DEPT.
DATE 2-16-84
PAGE 2-03-002A
BY
NEED APPROV
15454
APR 27 1984
ADD TO DUP. PER Deed Vol. 828 Pgs. 156 thru 165
(ERIE AVE.)
Pt. 3.63 A.
500
Pt. 02-03-001-500-001
Pt 22.03 A.
002 0.15 A.
101
BLK.
Creek
2.59 A.
0.60 A.
RD.
OLD LAKE ROAD
104
322.49