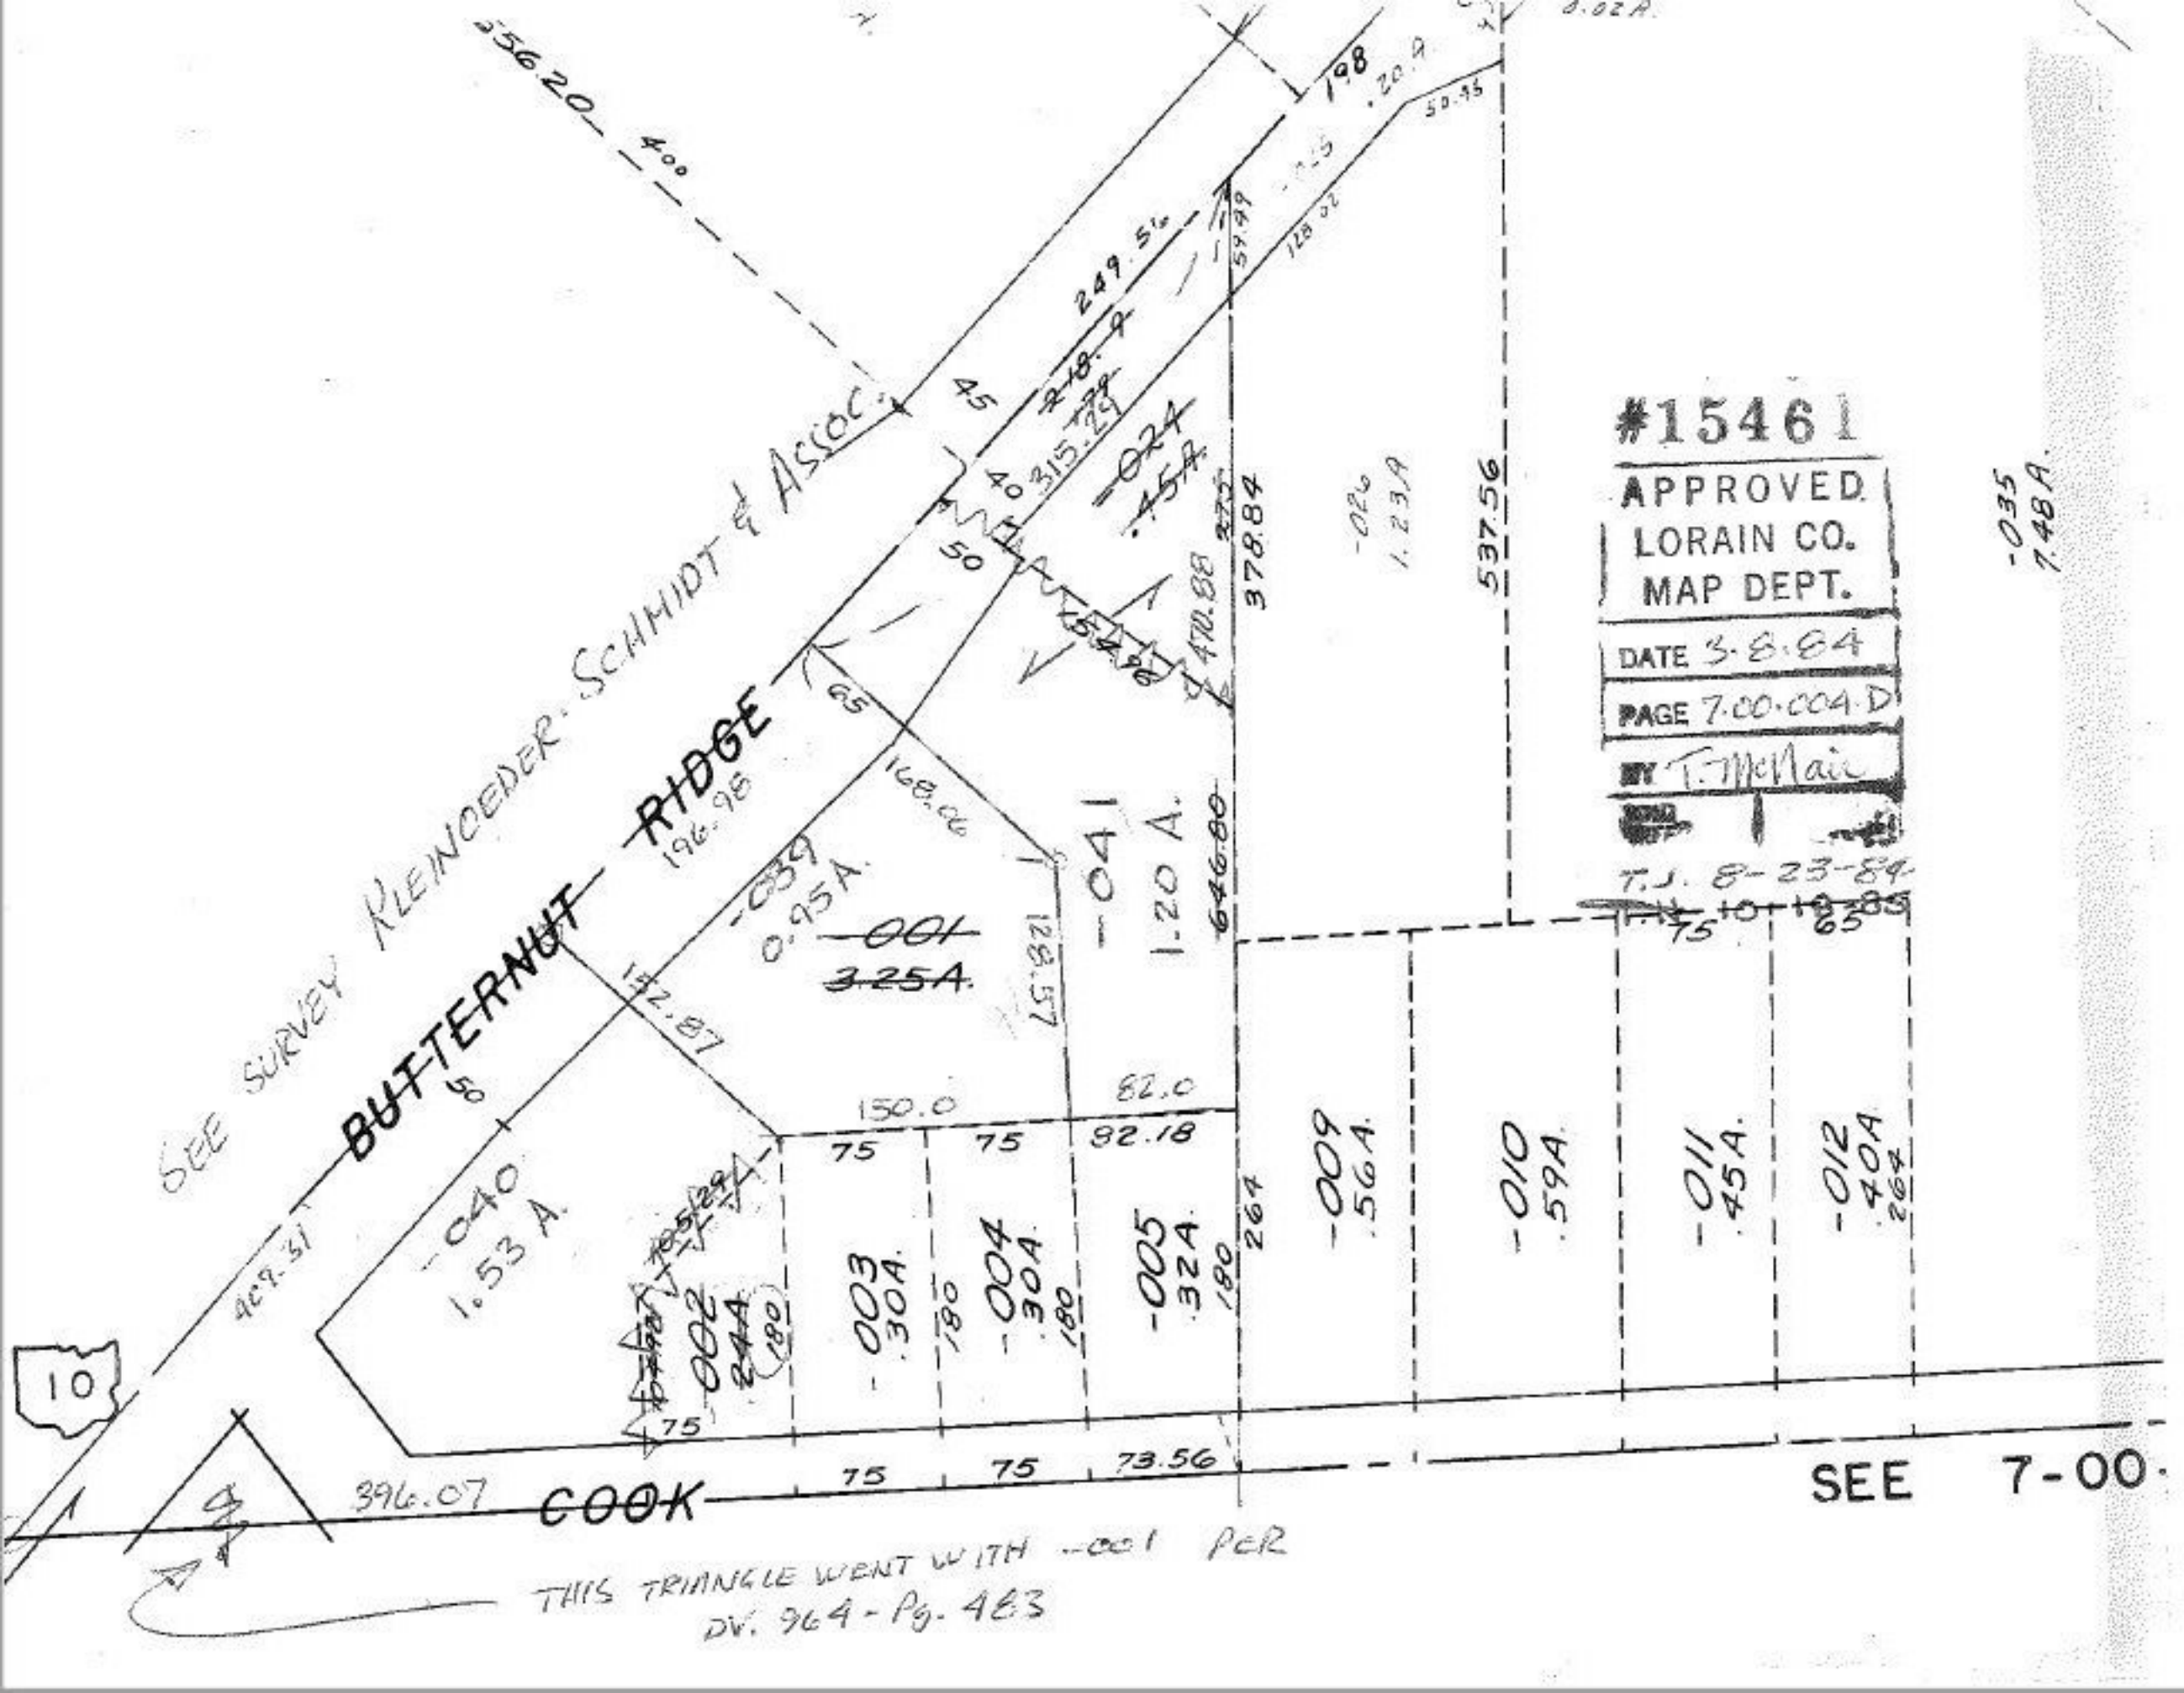

#15461
APPROVED
LORAIN CO.
MAP DEPT.
DATE 3-8-84
PAGE 7-00-004-D
BY T. McNair
T.J. 8-23-84
SEE SURVEY KLEINOEDER-SCHMIDT & ASSOC.
BUTTERNUT RIDGE
COOK
SEE 7-00-
THIS TRIANGLE WENT WITH -001 PER DV. 964-Pg. 483
-040 1.53 A.
-039 0.95 A.
-001 3.25 A.
-041 1.20 A.
-024 .45 A.
-002 .24 A.
-003 .30 A.
-004 .30 A.
-005 .32 A.
-009 .56 A.
-010 .59 A.
-011 .45 A.
-012 .40 A.
-026 1.23 A.
-035 7.48 A.
537.56
378.84
470.88
646.80
128.57
150.0
82.0
82.18
73.56
396.07
409.31
152.87
168.06
196.98
249.56
315.29
198
10