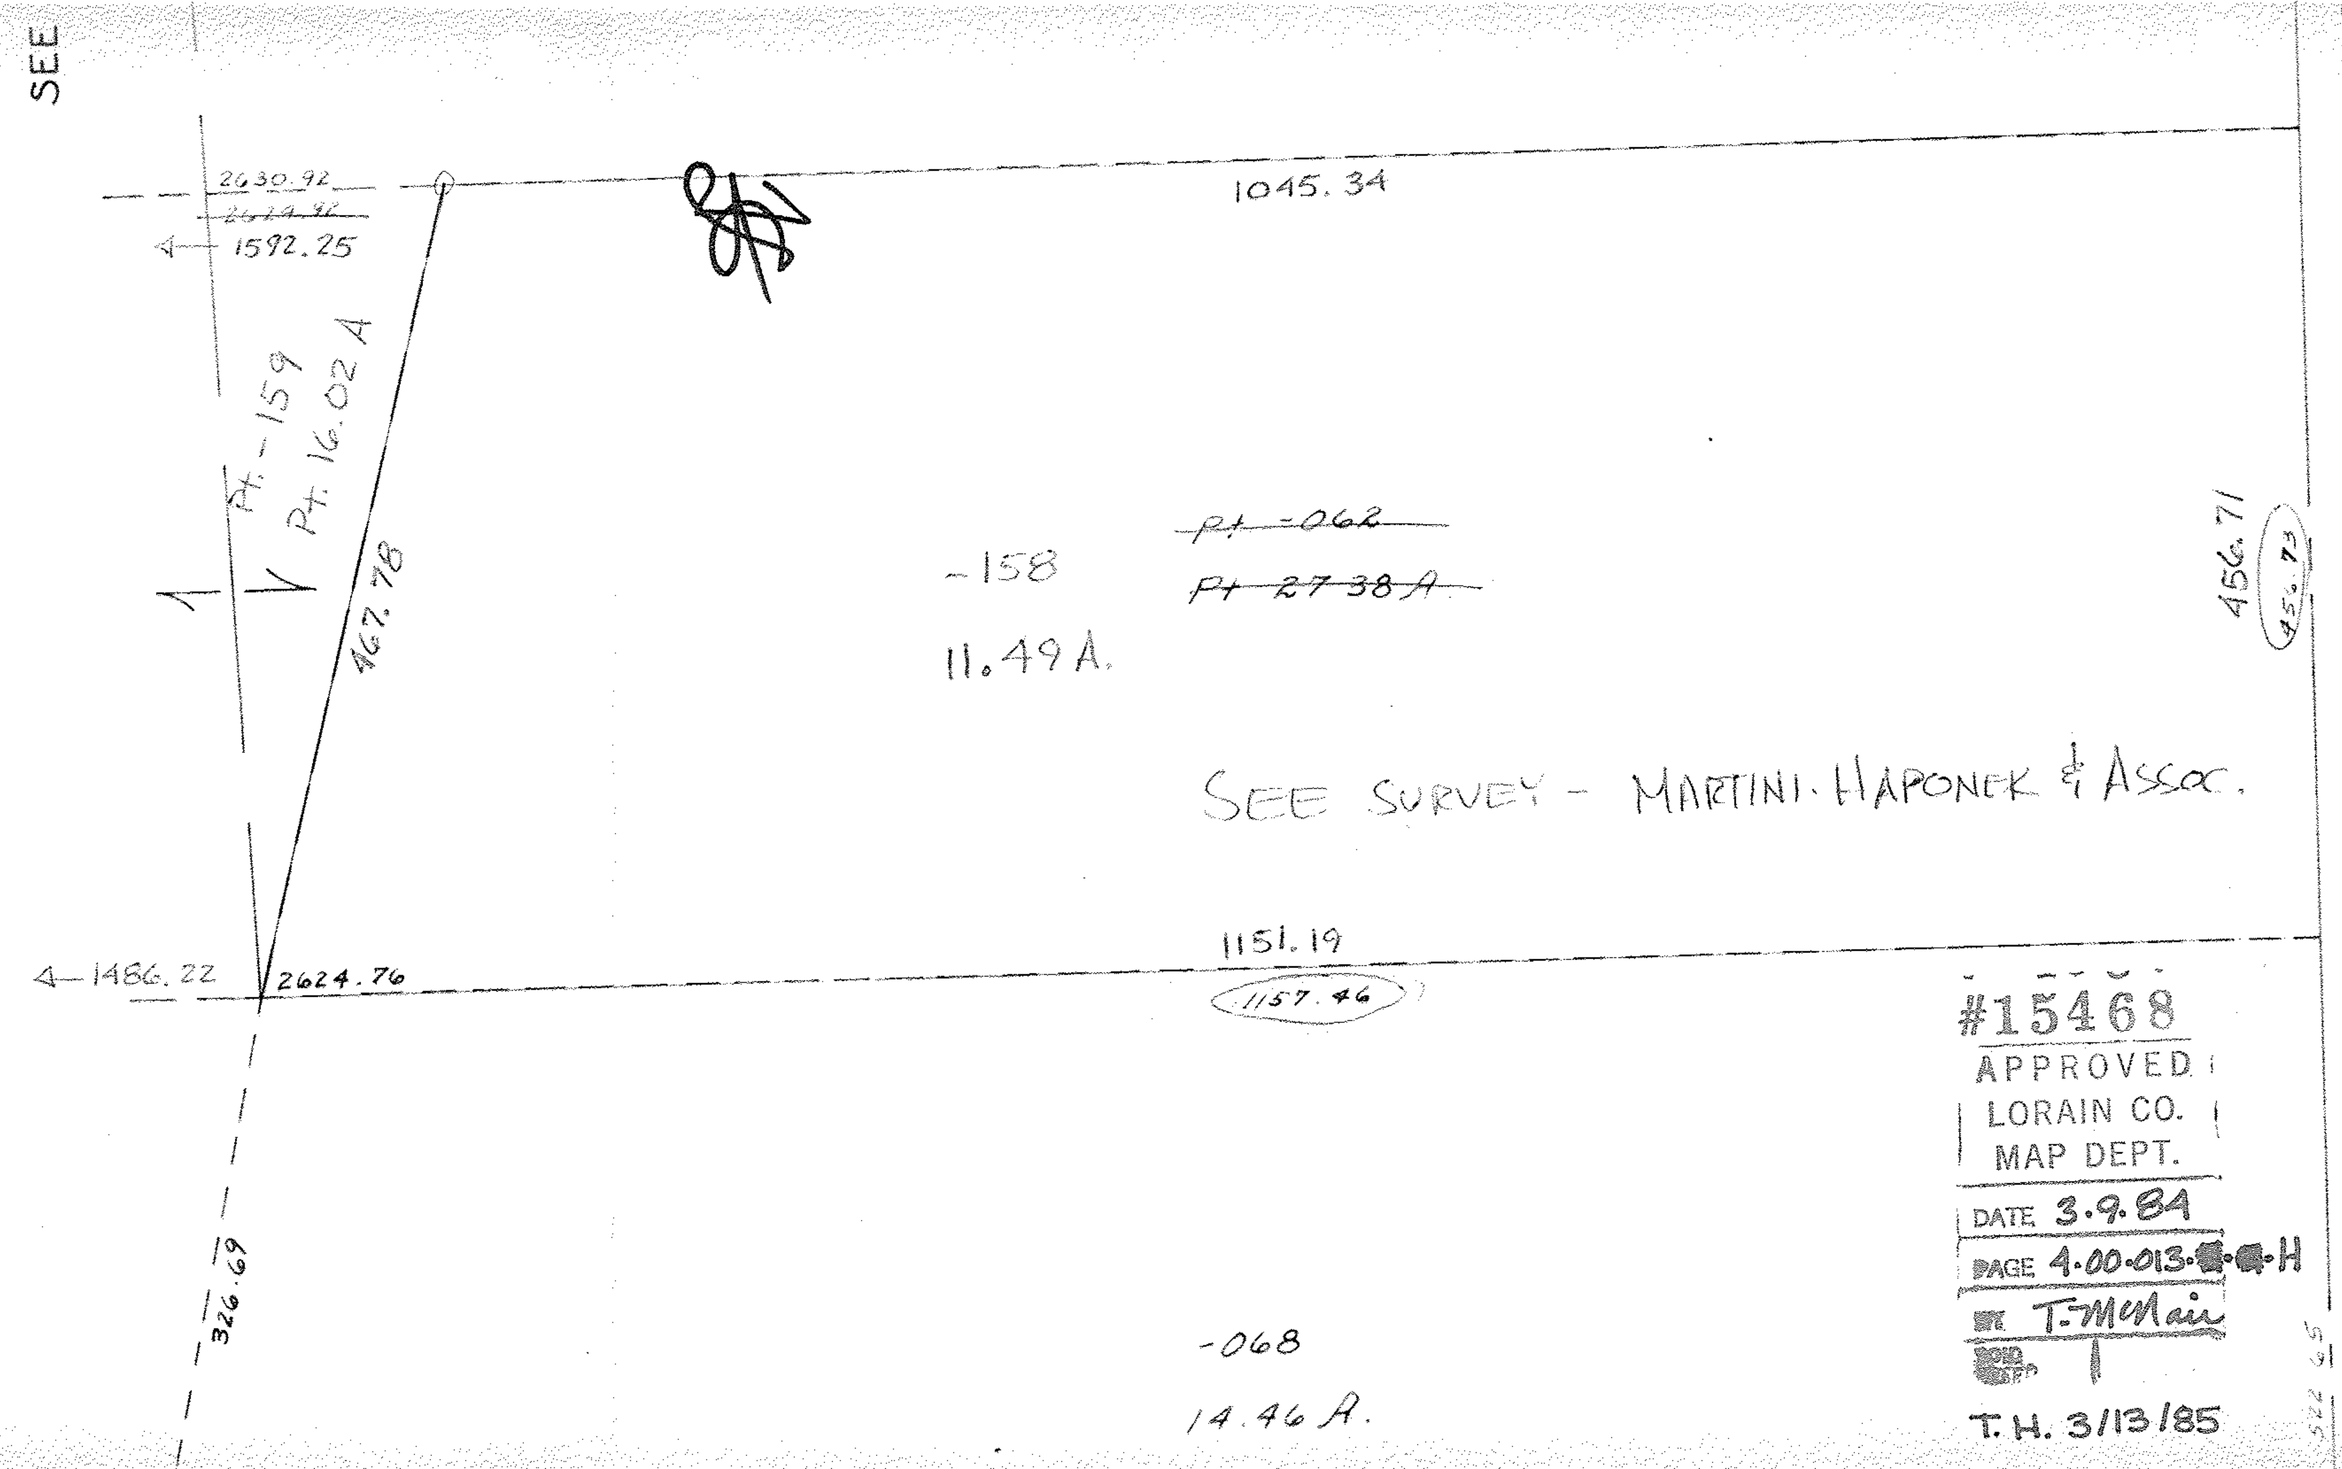
SEE
SEE 4-00
2630.92
2624.92
1592.25
1045.34
Pt. -159
Pt. 16.02 A
467.78
-158
11.49 A.
~~Pt -062~~
~~Pt 27.38 A~~
456.71
456.73
SEE SURVEY - MARTINI. HAPONEK & ASSOC.
1486.22
2624.76
1151.19
1157.46
326.69
-068
14.46 A.
#15468
APPROVED
LORAIN CO.
MAP DEPT.
DATE 3.9.84
PAGE 4.00.013.[illegible].H
BY T. McNair
T.H. 3/13/85