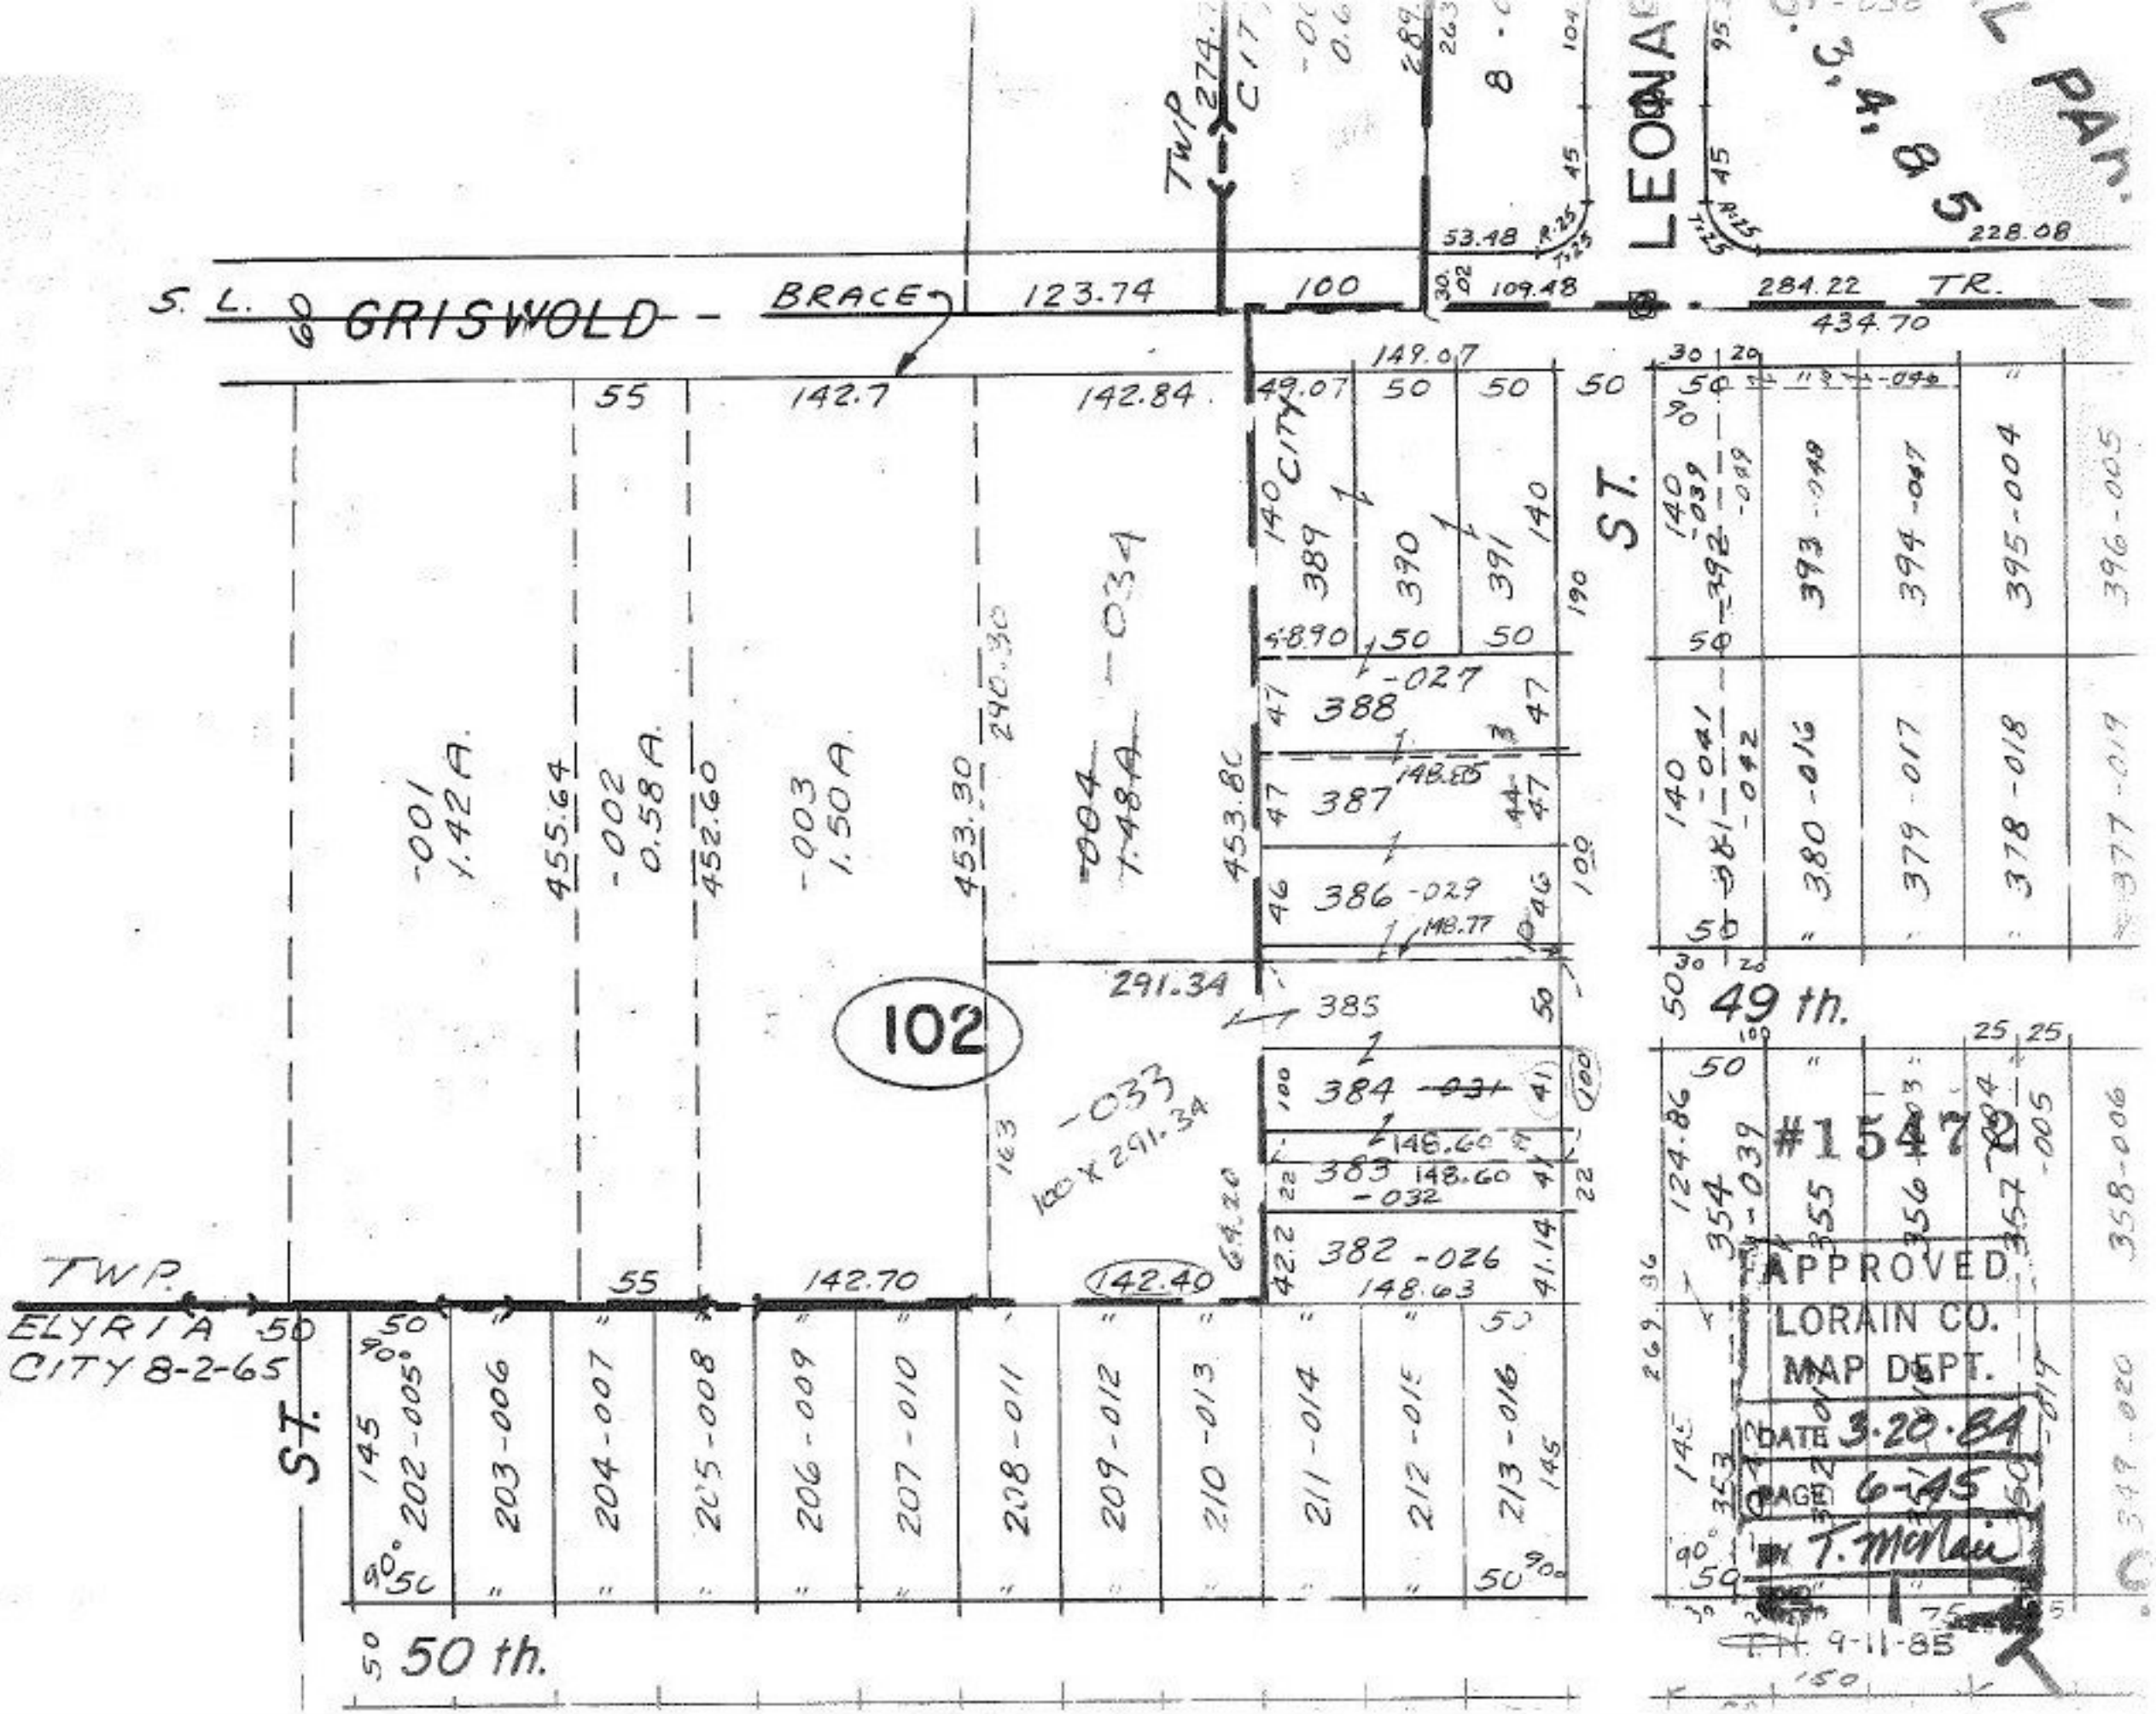

S. L. GRISWOLD
BRACE
123.74
100
109.48
284.22
TR.
434.70
228.08
53.48
LEONA
TWP
CITY
142.7
142.84
149.07
49.07
50
55
-001
1.42 A.
455.64
-002
0.58 A.
452.60
-003
1.50 A.
453.30
290.30
-004
1.48 A.
-034
453.80
291.34
102
-033
100 x 291.34
163
64.20
142.70
142.40
TWP.
ELYRIA
CITY 8-2-65
ST.
50 th.
49 th.
388
387
386
385
384
383
382
389
390
391
-027
148.85
148.77
148.60
148.63
-032
-031
-039
-042
-041
-049
-048
-047
-046
393
394
395
396
380
379
378
377
354
355
356
357
358
202-005
203-006
204-007
205-008
206-009
207-010
208-011
209-012
210-013
211-014
212-015
213-016
#15472
APPROVED
LORAIN CO.
MAP DEPT.
DATE 3-20-84
PAGE 6-45
BY T. McNair
9-11-85