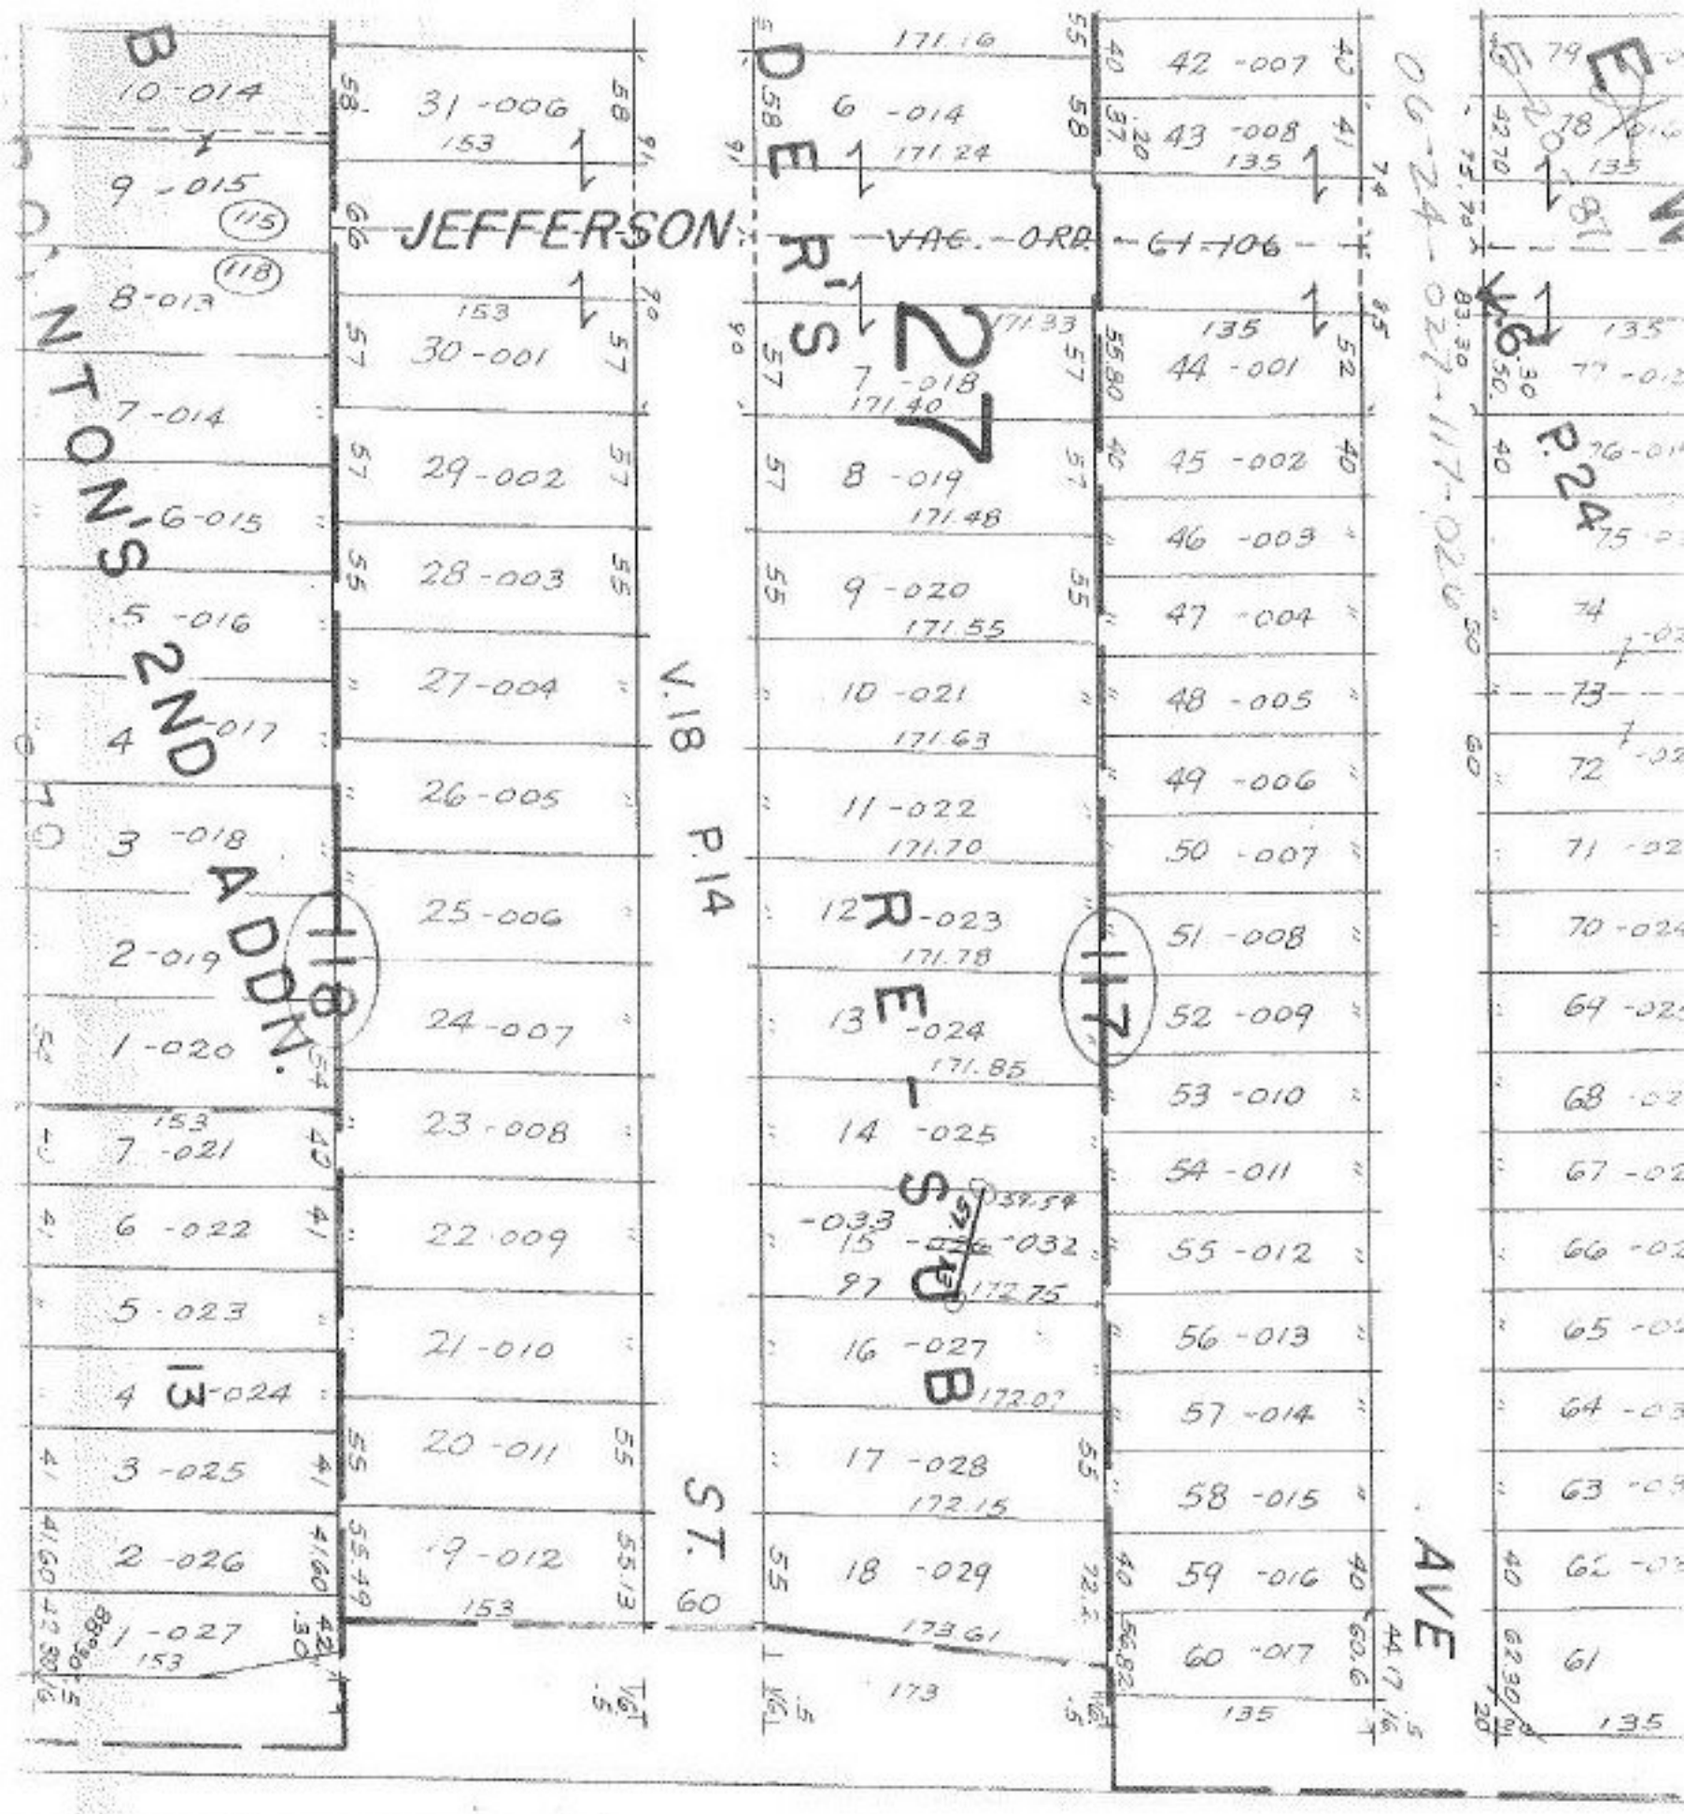
JEFFERSON
VAC. ORD. 61-106
DERS
REIS
BERS
ADDN.
2ND
NTONS
V.18 P.14
ST.
AVE
P.24
118
117
115
116
27
06-24-0247-117-0260
P6. 6.81
Z
APPROVED
LORAIN CO.
MAP DEPT.
DATE 2-15-68
#1548
BY
Done 6-1-68
LW Hall
1548