5-20-87 06-24-001-102-008

#1549
APPROVED
LORAIN CO.
MAP DEPT.
DATE 2-15-68
6-80
BY D Maynard
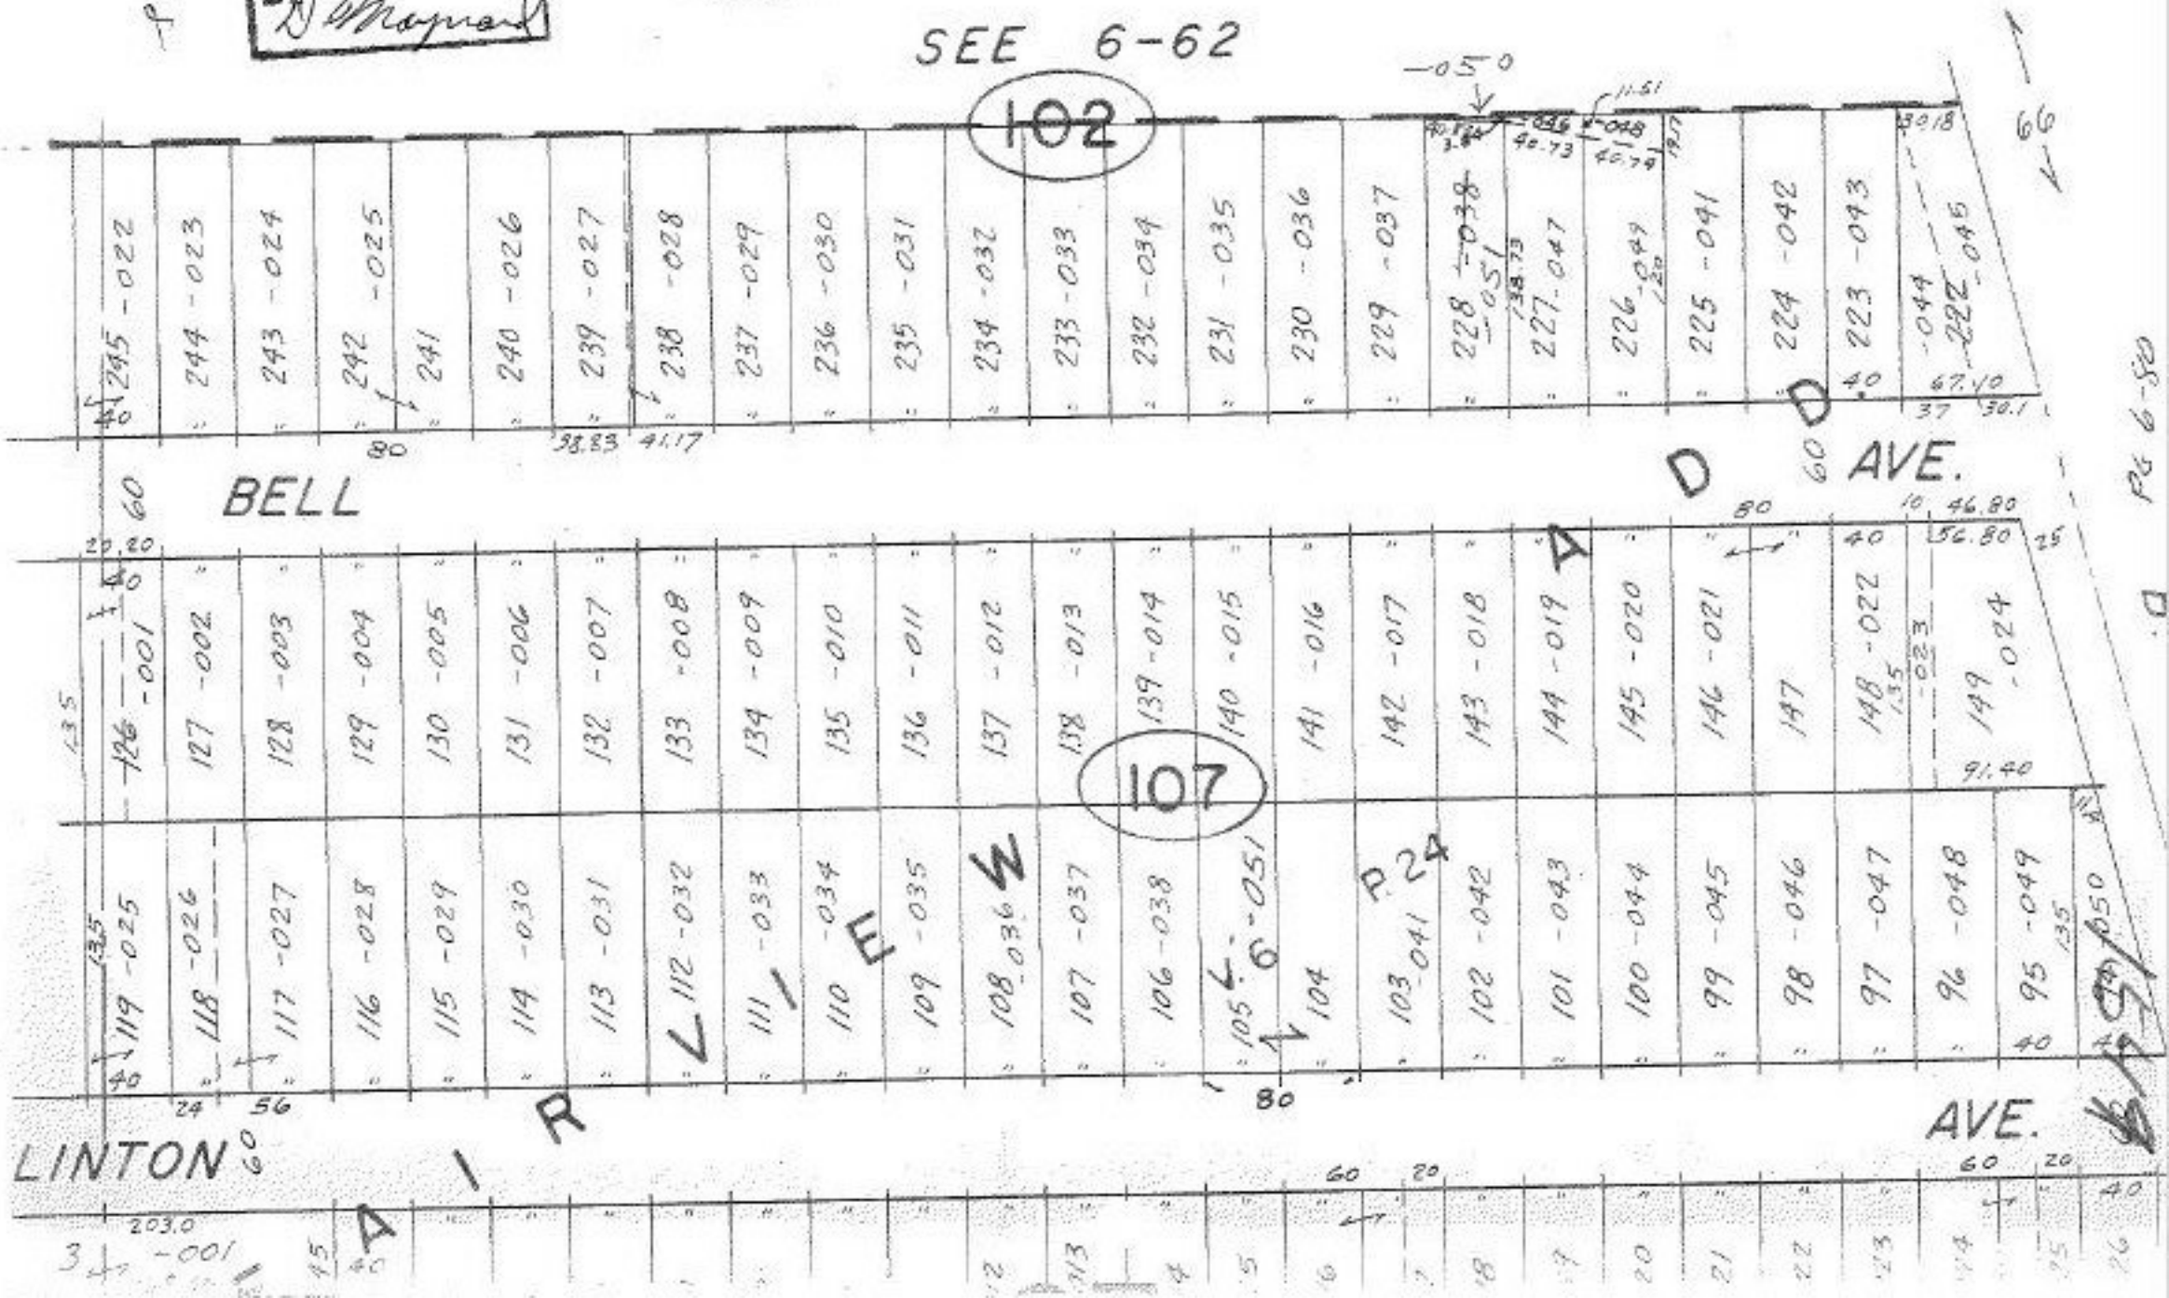
Done 6-1-68
J W Hall