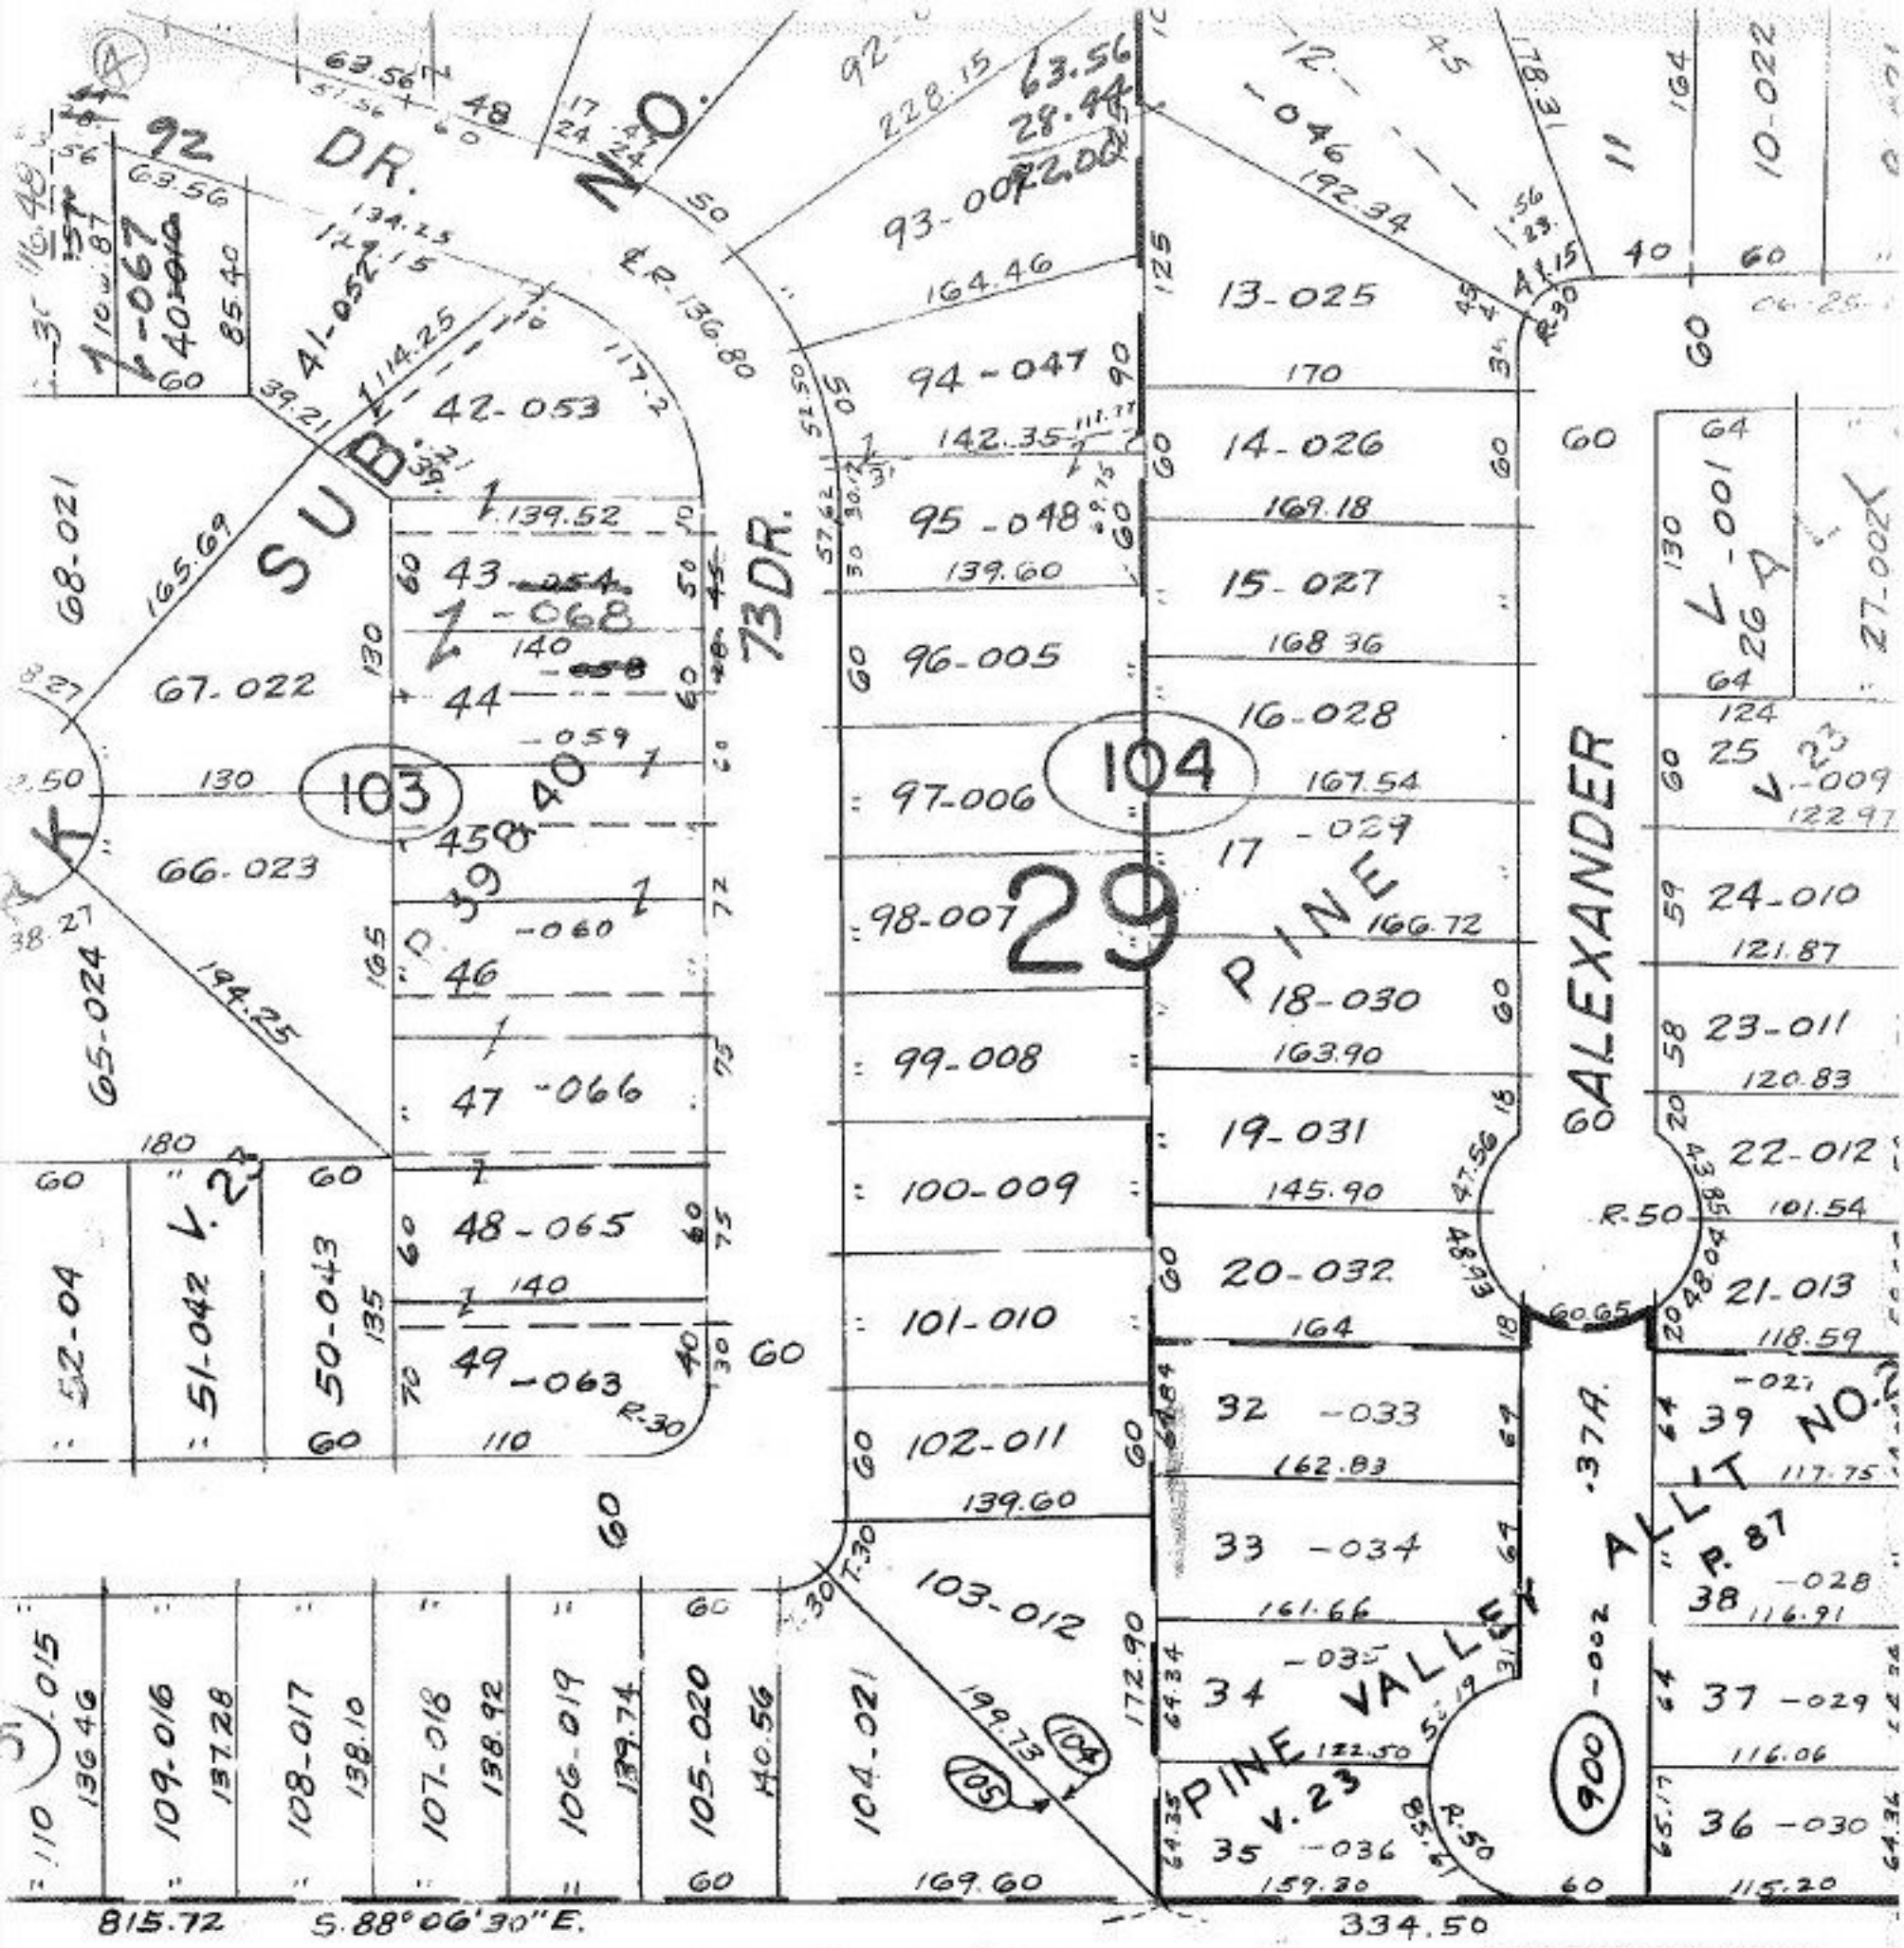

28.44 of 21.47
63.56

106.87
85.40
21.47

106.87
9.61
116.48
9.606
9.61

106

-063
9.73A.

#15505

APPROVED
LORAIN CO.
MAP DEPT.
DATE 4-27-84
PAGE 6-52
BY [signature]
VOID AFTER 15505

CH. 9-11-85