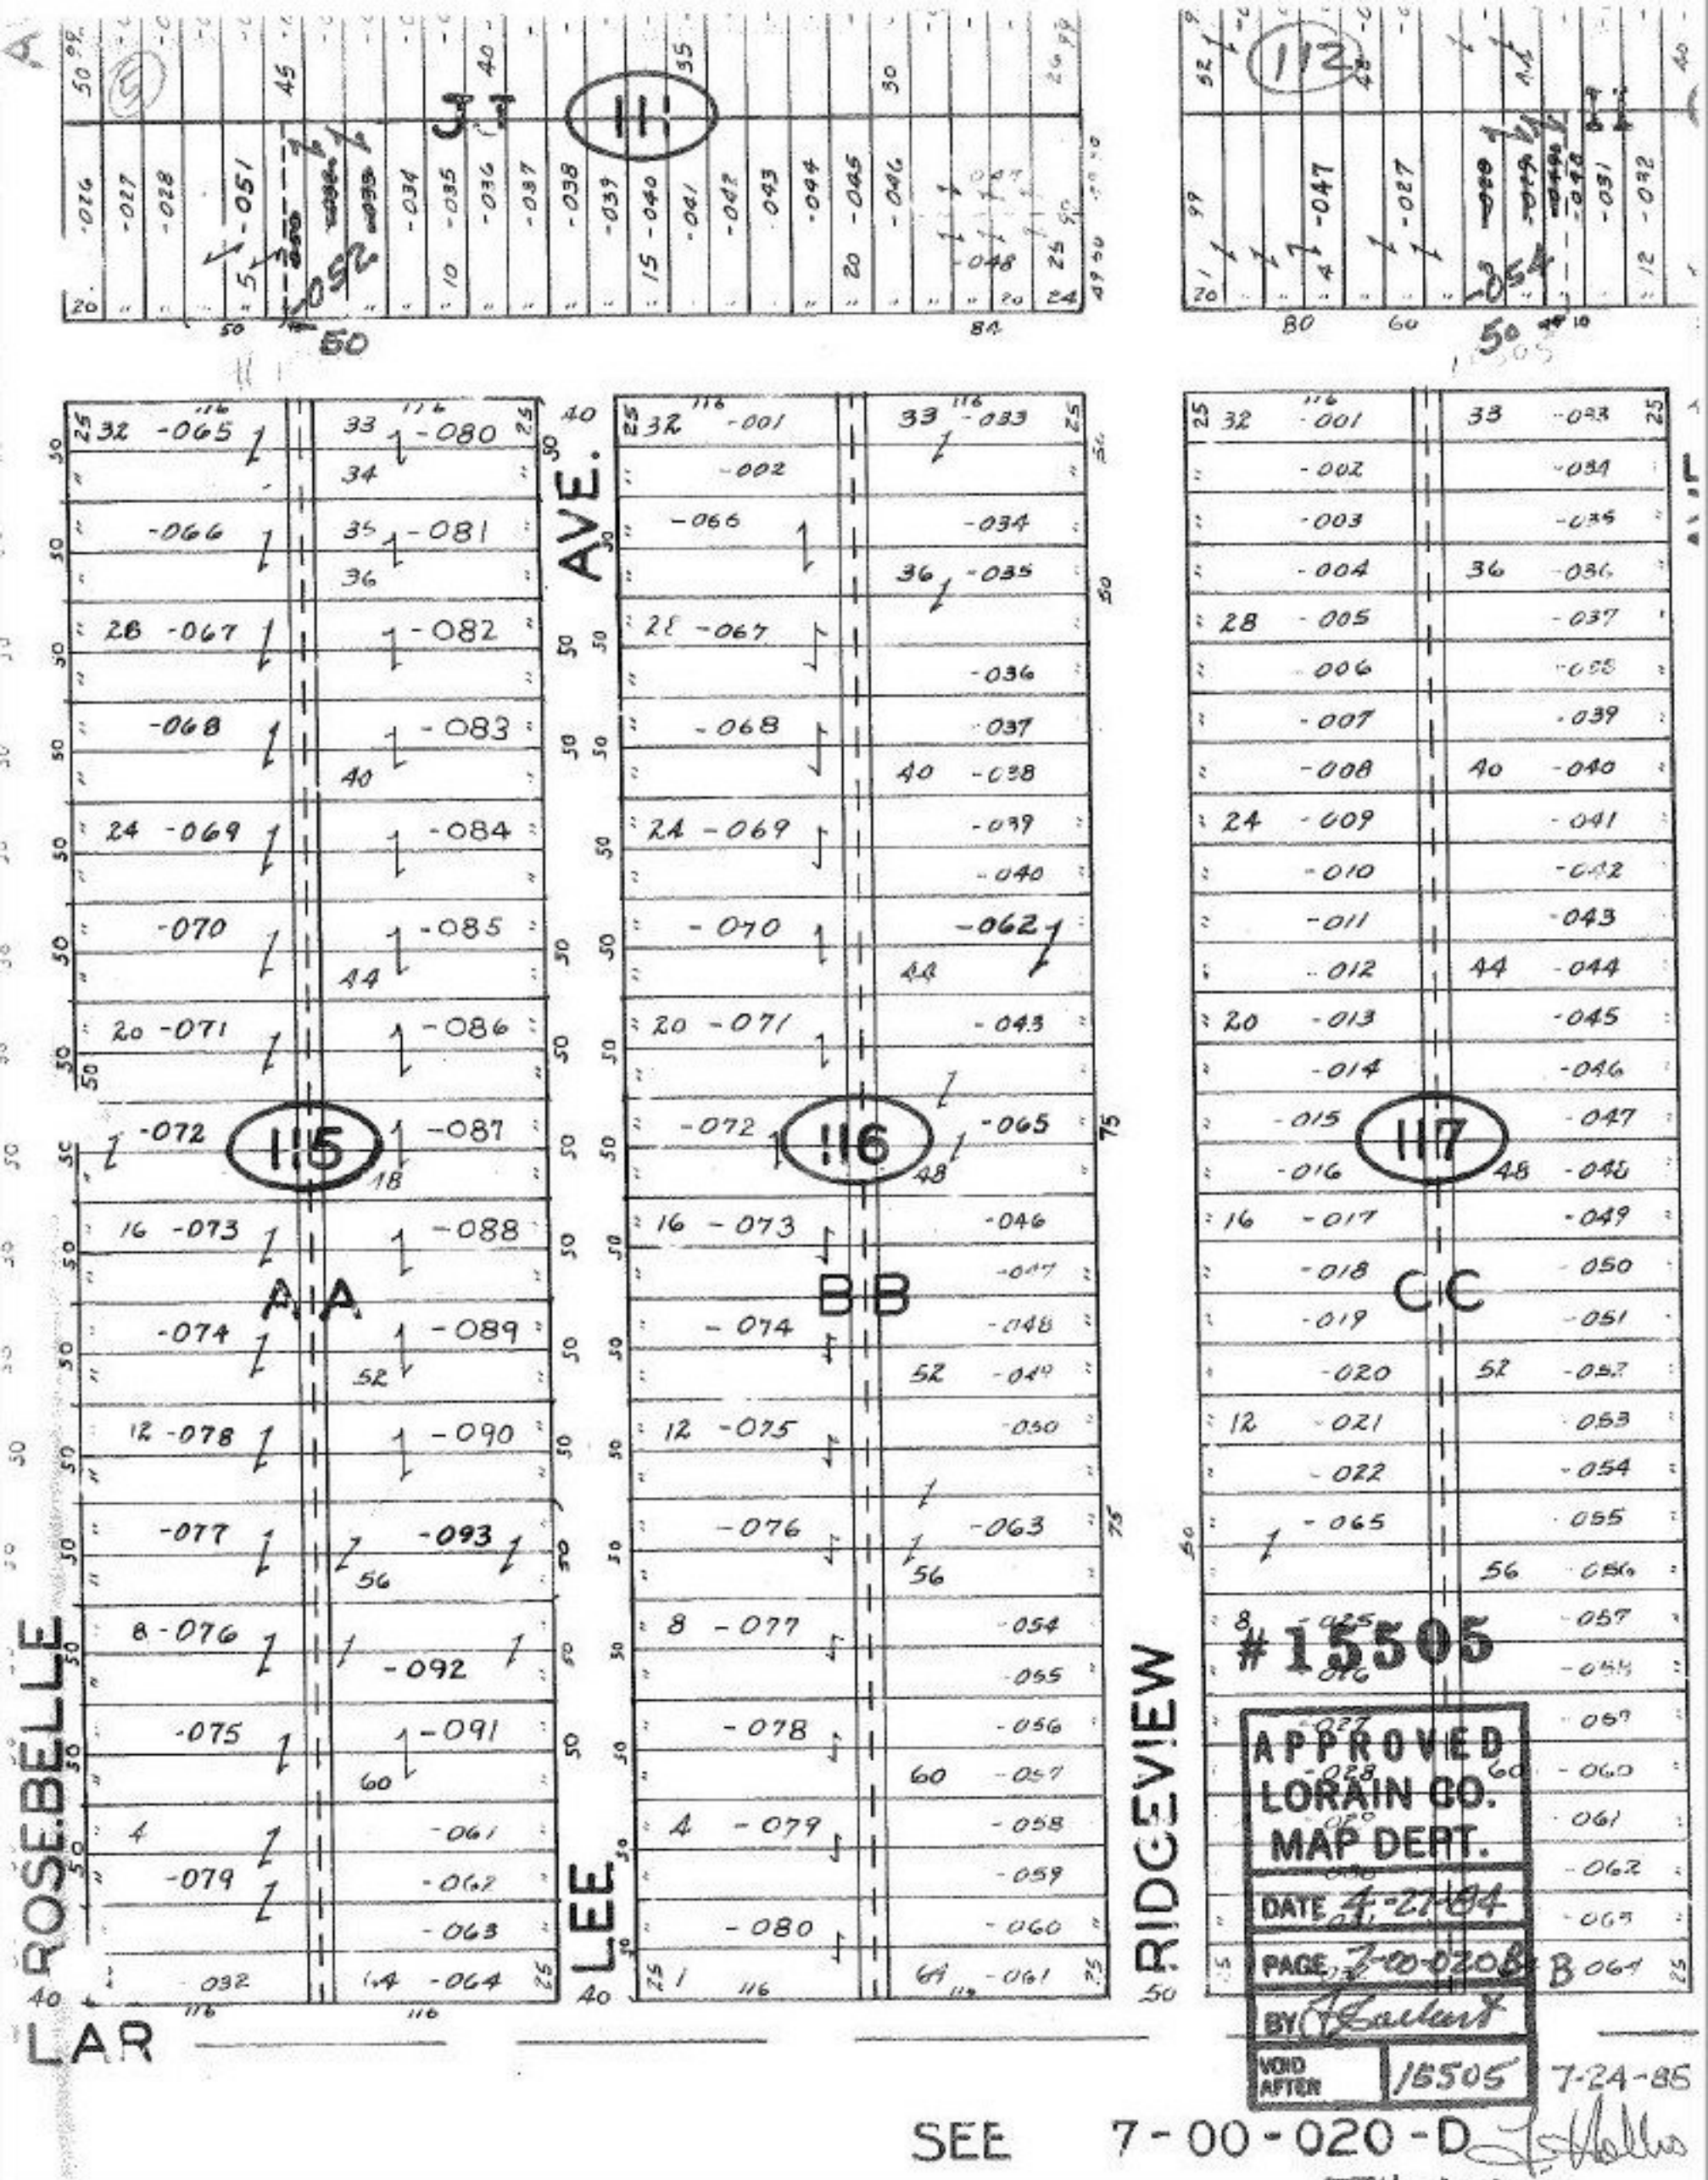
AVE.
ROSEBELLE
LEE
RIDGEVIEW
LAR
115
116
117
A A
B B
C C
#15505
APPROVED
LORAIN CO.
MAP DEPT.
DATE 4-27-84
PAGE 7-00-020 & B
BY
VOID AFTER 16505
7-24-85
SEE 7-00-020-D
TH 10-18-85