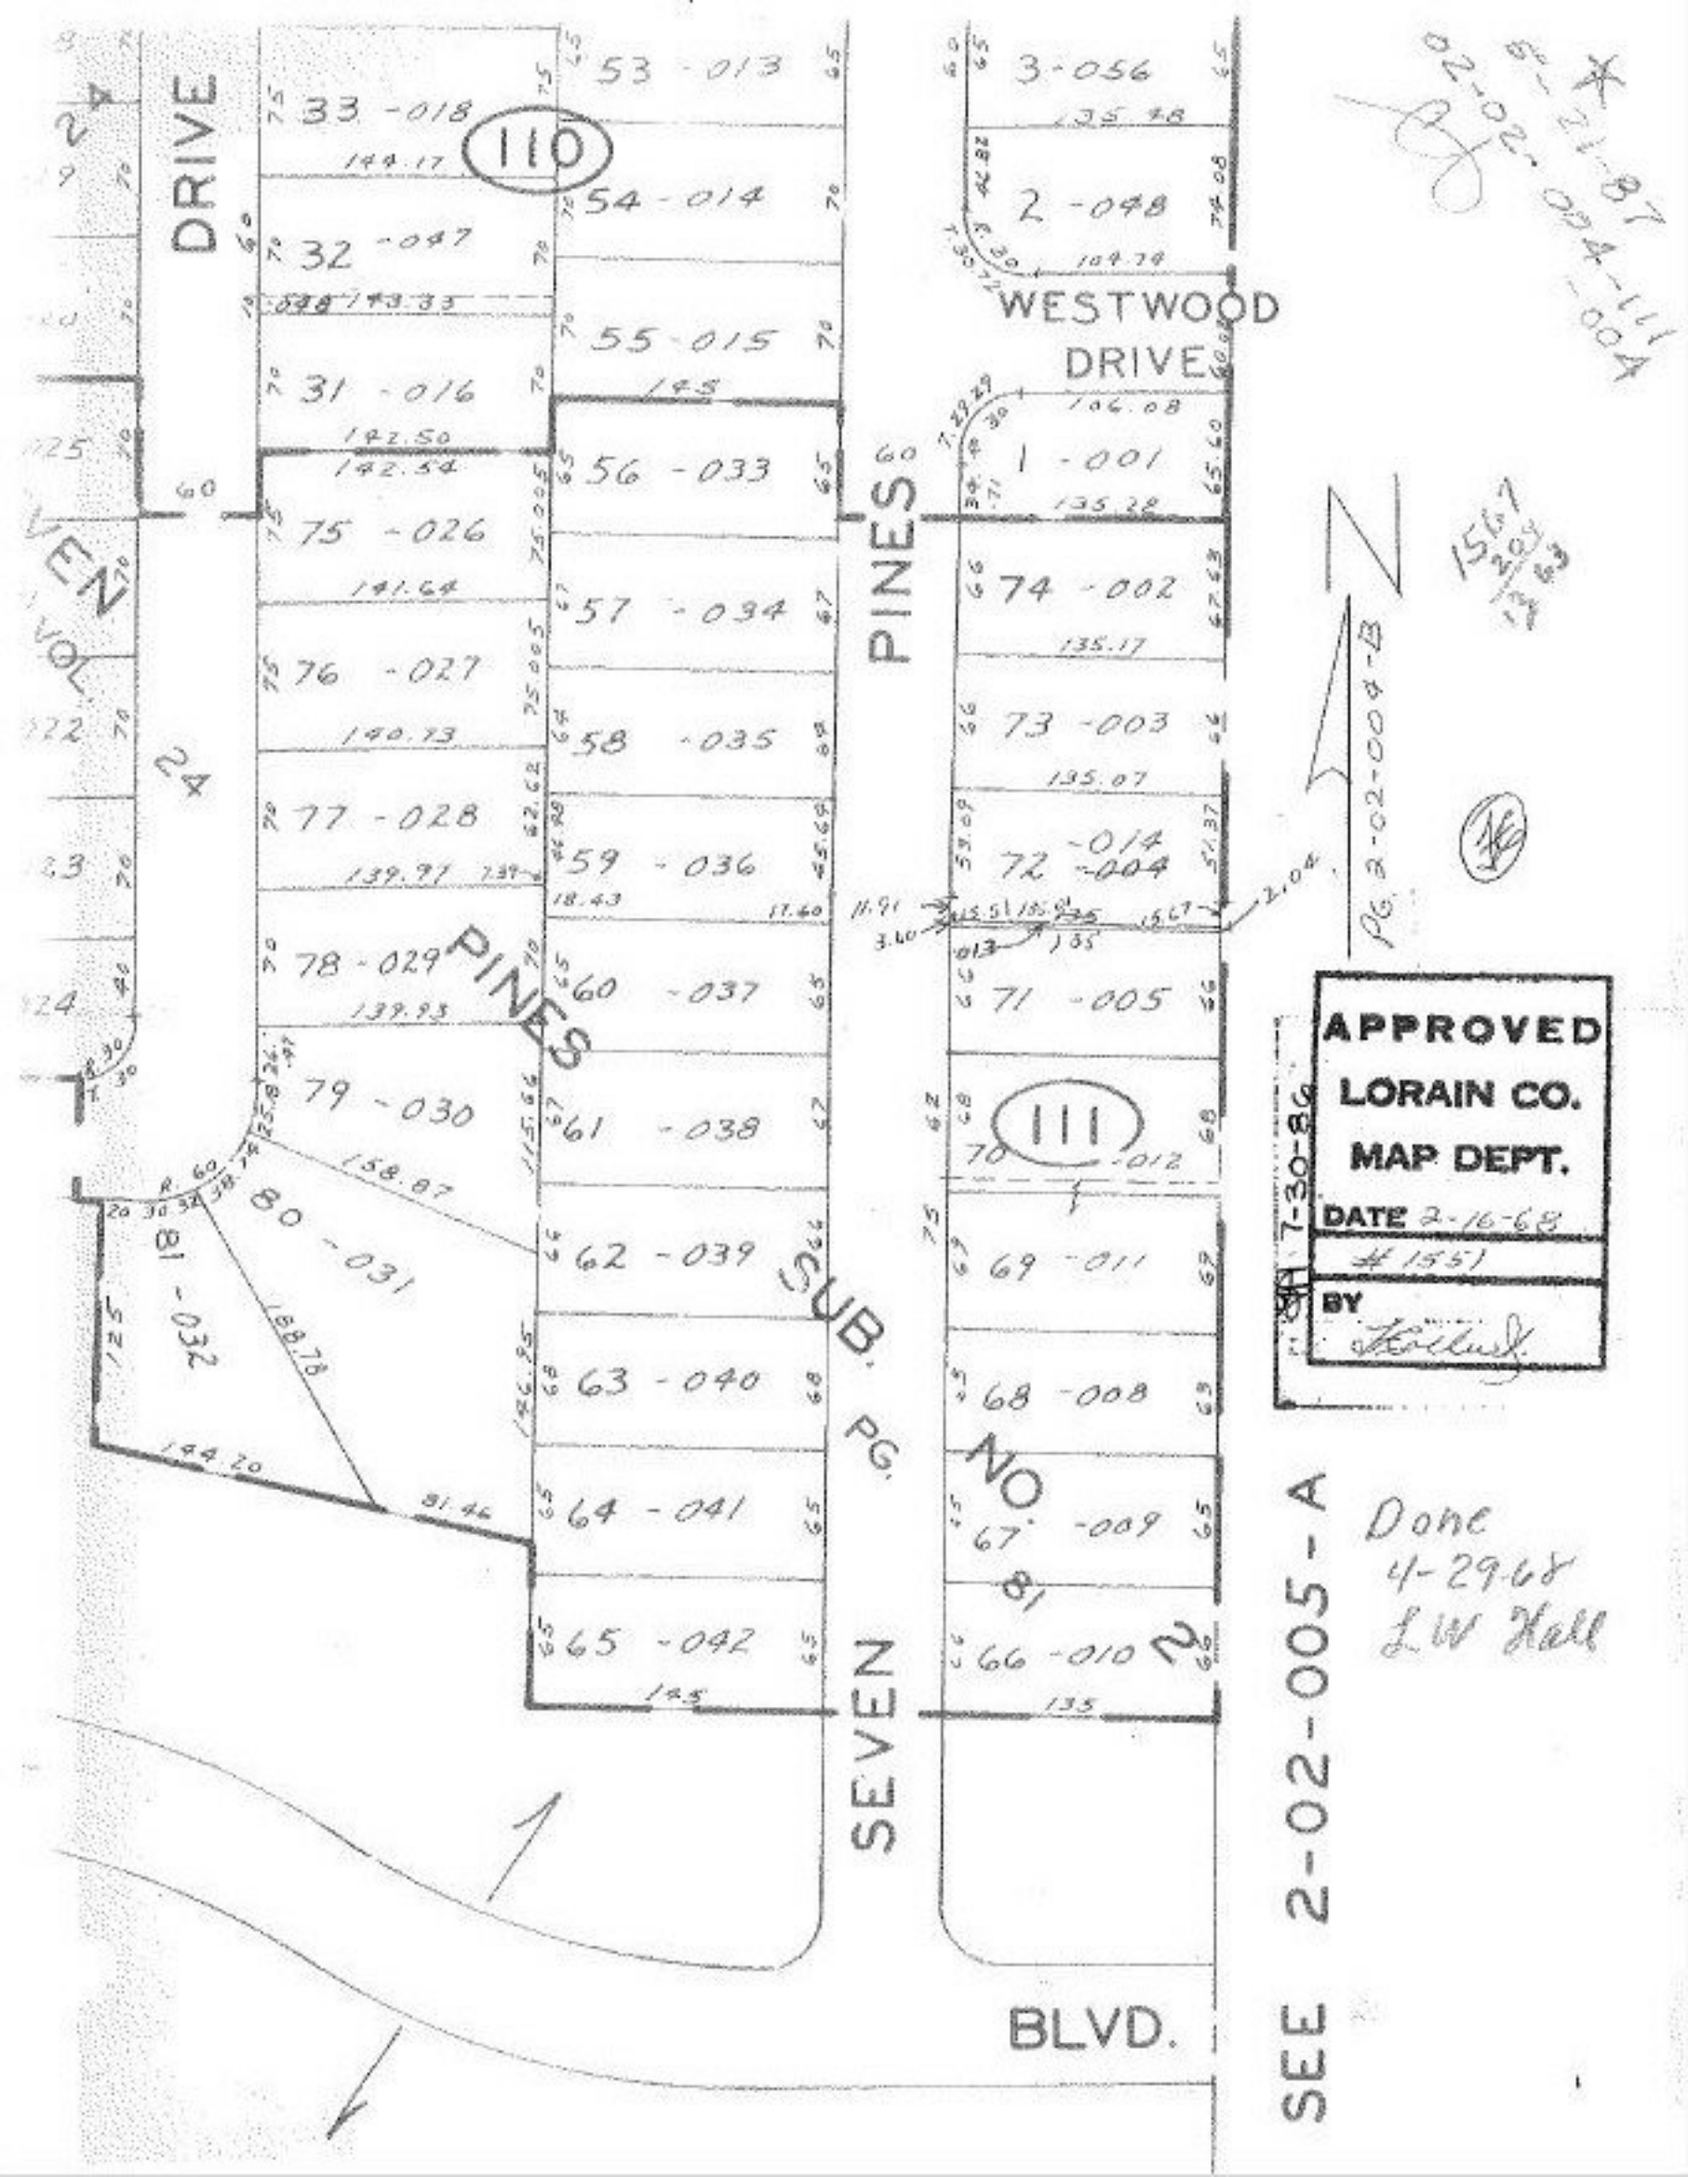
DRIVE
WESTWOOD DRIVE
PINES
SUB. NO. 82
SEVEN
BLVD.
110
111
33 -018
54 -014
32 -047
55 -015
31 -016
56 -033
75 -026
57 -034
76 -027
58 -035
77 -028
59 -036
78 -029
60 -037
79 -030
61 -038
80 -031
62 -039
81 -032
63 -040
64 -041
65 -042
3-056
2 -048
1 -001
74 -002
73 -003
72 -014
72 -004
71 -005
69 -011
68 -008
67 -009
66 -010
APPROVED
LORAIN CO.
MAP DEPT.
DATE 2-16-68
1551
BY
SEE 2-02-005-A
Done
4-29-68
L W Hall