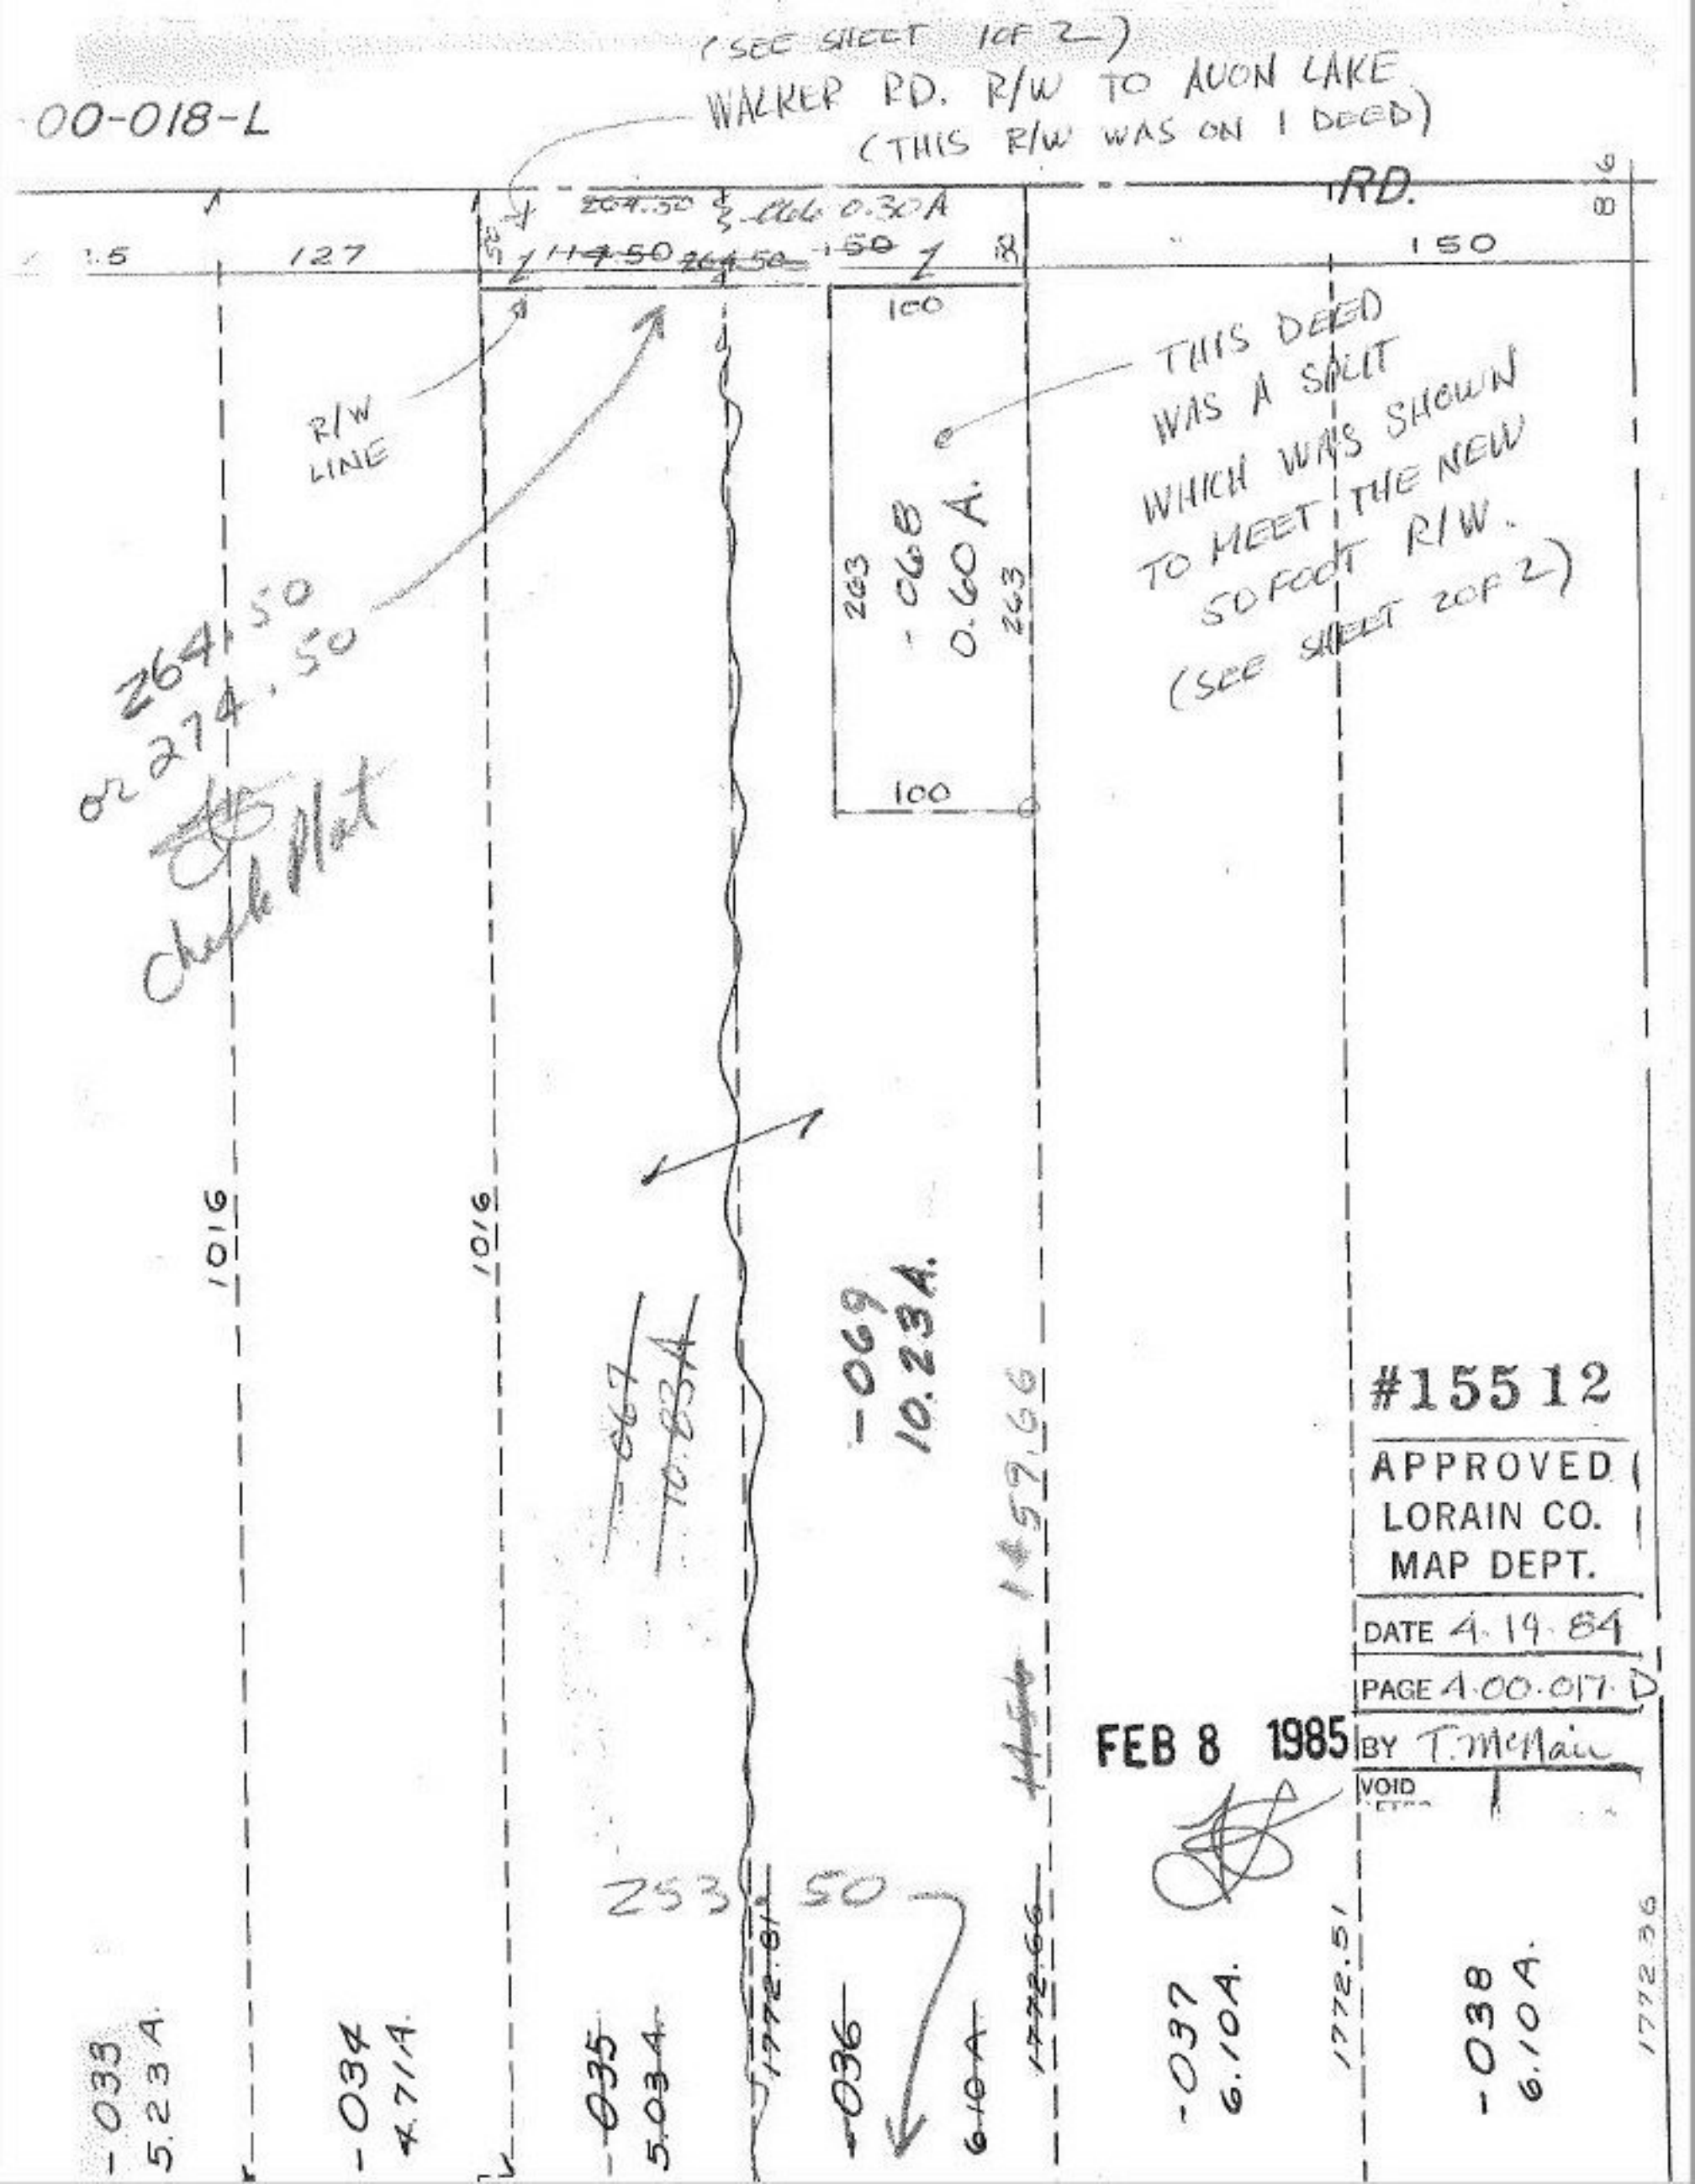

00-018-L
(SEE SHEET 1 OF 2)
WALKER RD. R/W TO AVON LAKE
(THIS R/W WAS ON 1 DEED)
RD.
127
150
R/W LINE
THIS DEED WAS A SPLIT WHICH WAS SHOWN TO MEET THE NEW 50 FOOT R/W.
(SEE SHEET 2 OF 2)
264.50
or 274.50
Check Plat
100
263
.068
0.60 A.
1016
-069
10.23 A.
1459.66
253.50
1772.81
1772.66
1772.51
1772.36
-033
5.23 A.
-034
4.71 A.
-035
5.03 A.
-036
6.10 A.
-037
6.10 A.
-038
6.10 A.
#15512
APPROVED
LORAIN CO.
MAP DEPT.
DATE 4.19.84
PAGE 4.00.017.D
BY T. McNair
VOID
FEB 8 1985