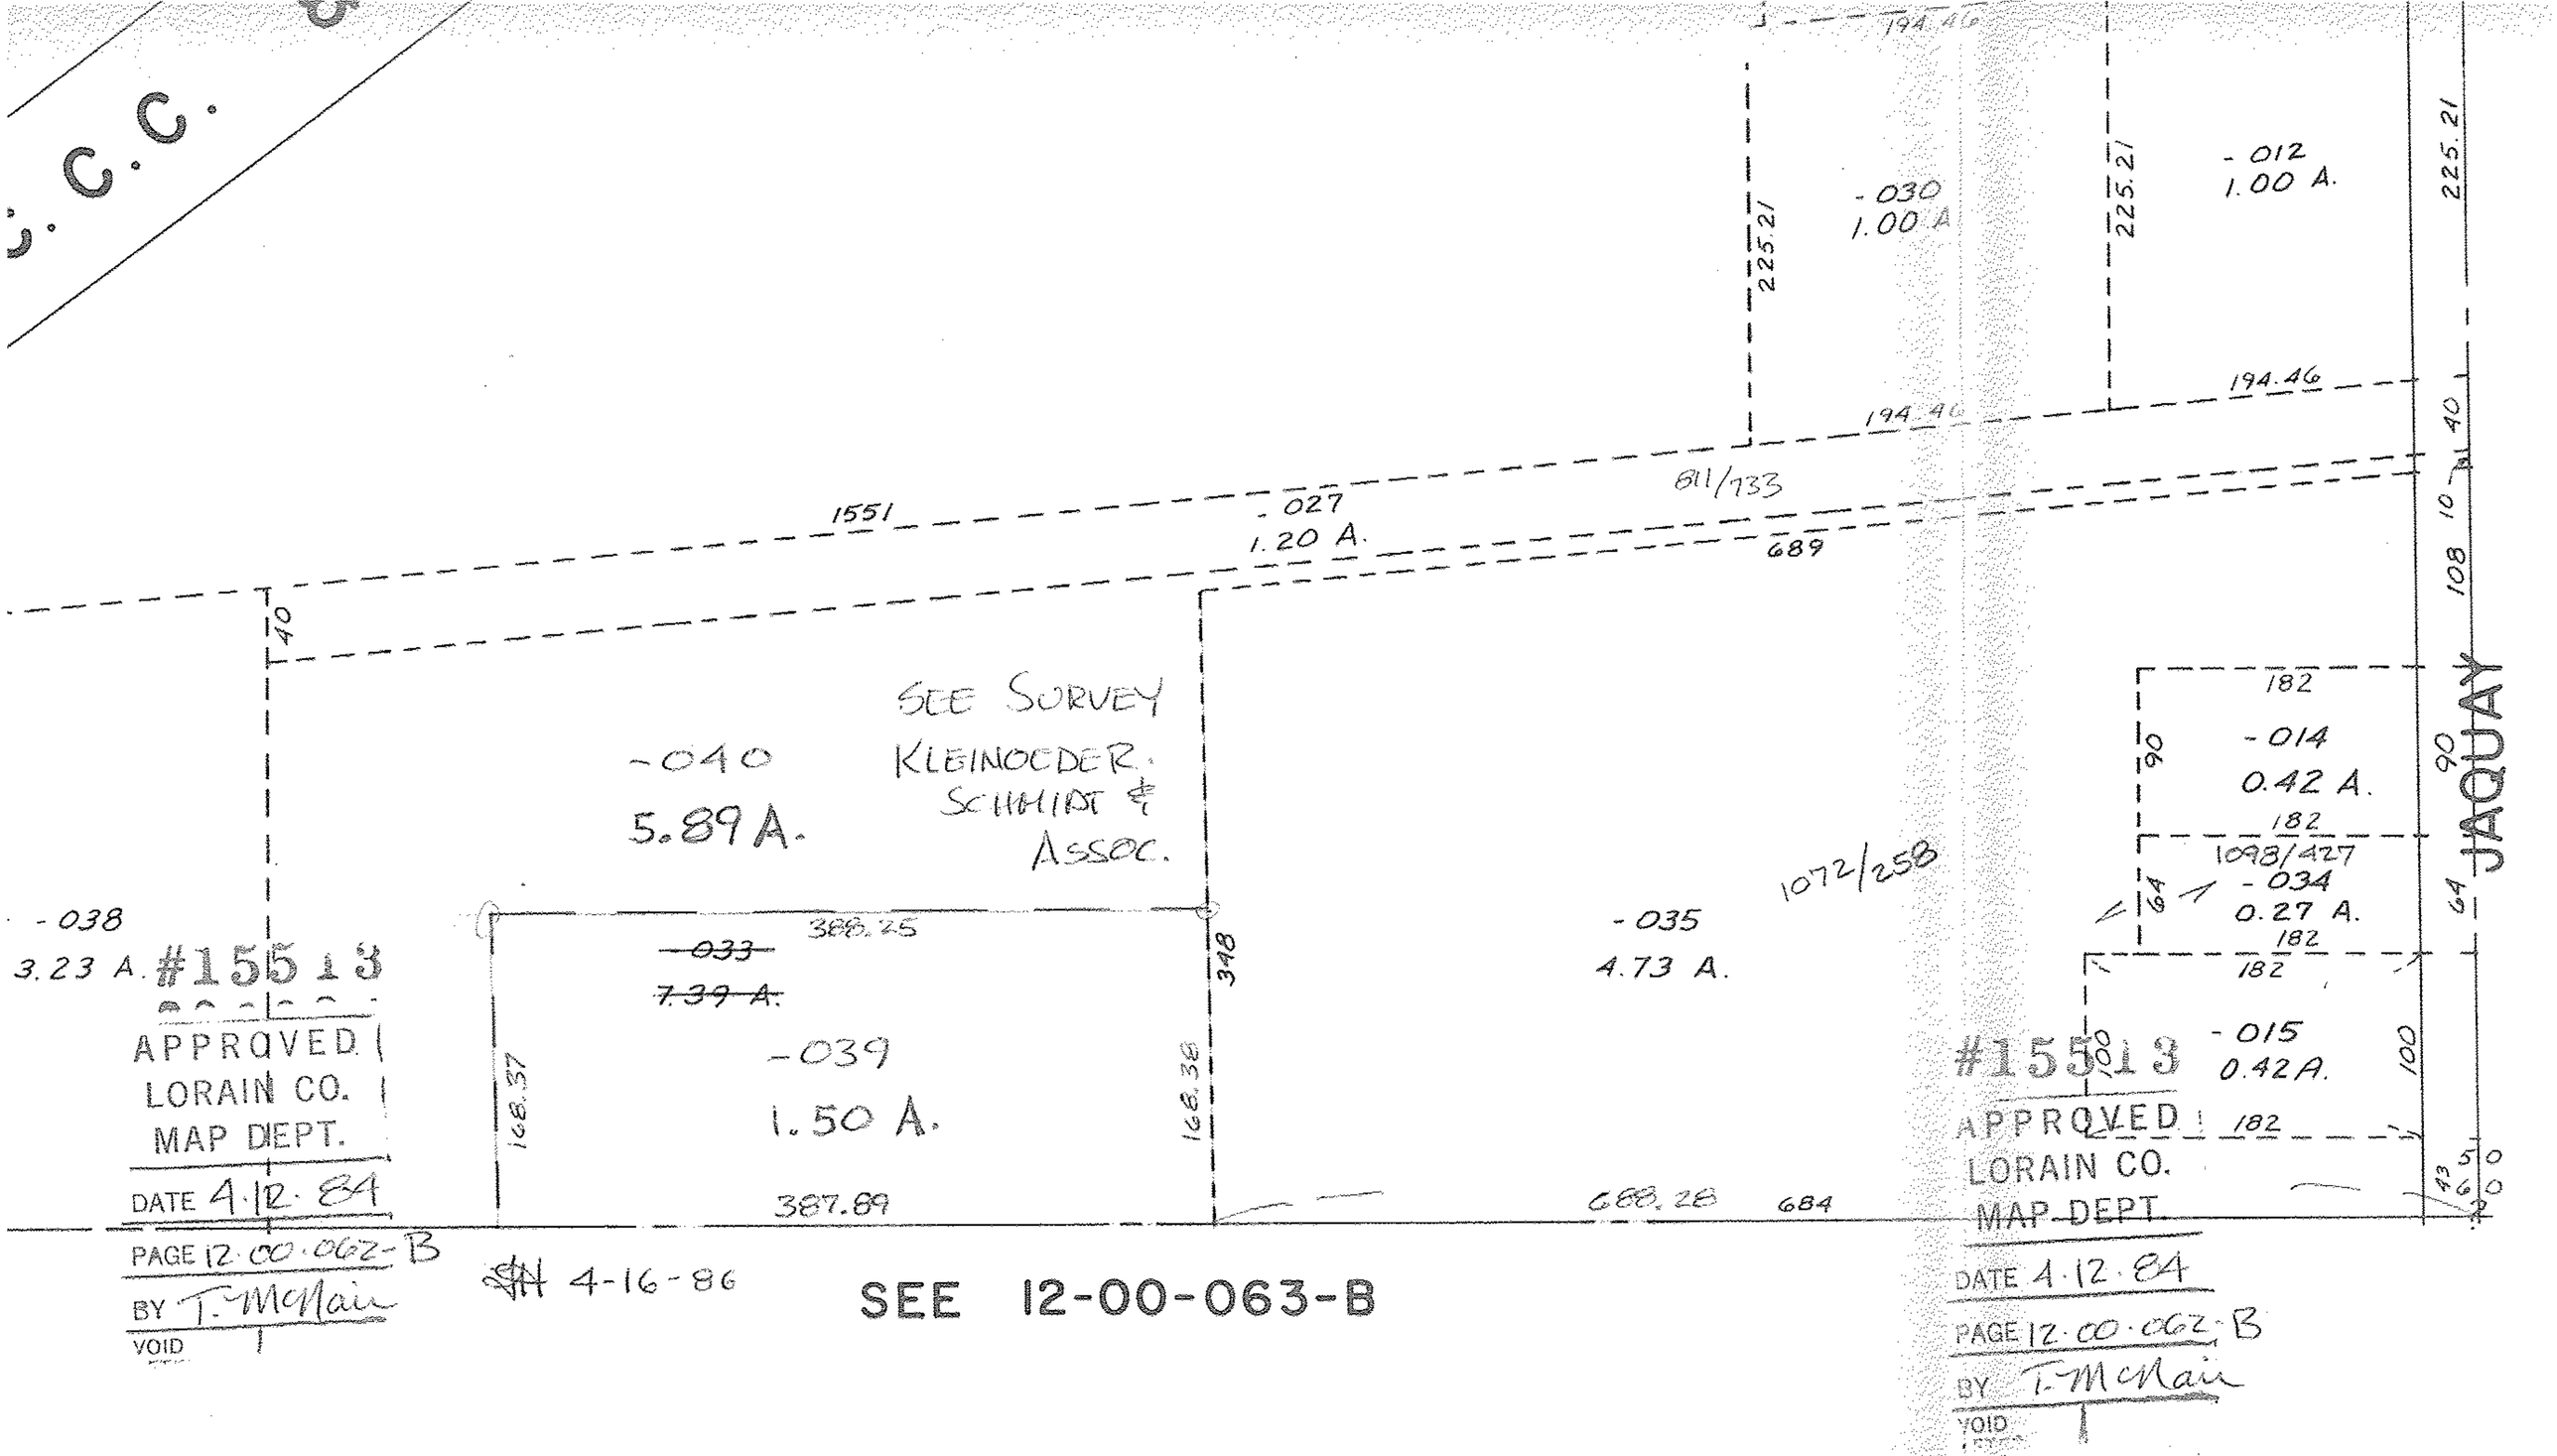

APPROVED
LORAIN CO.
MAP DEPT.
DATE 4.12.84
PAGE 12.00.062-B
BY T. McNair
VOID

SH 4-16-86

SEE 12-00-063-B