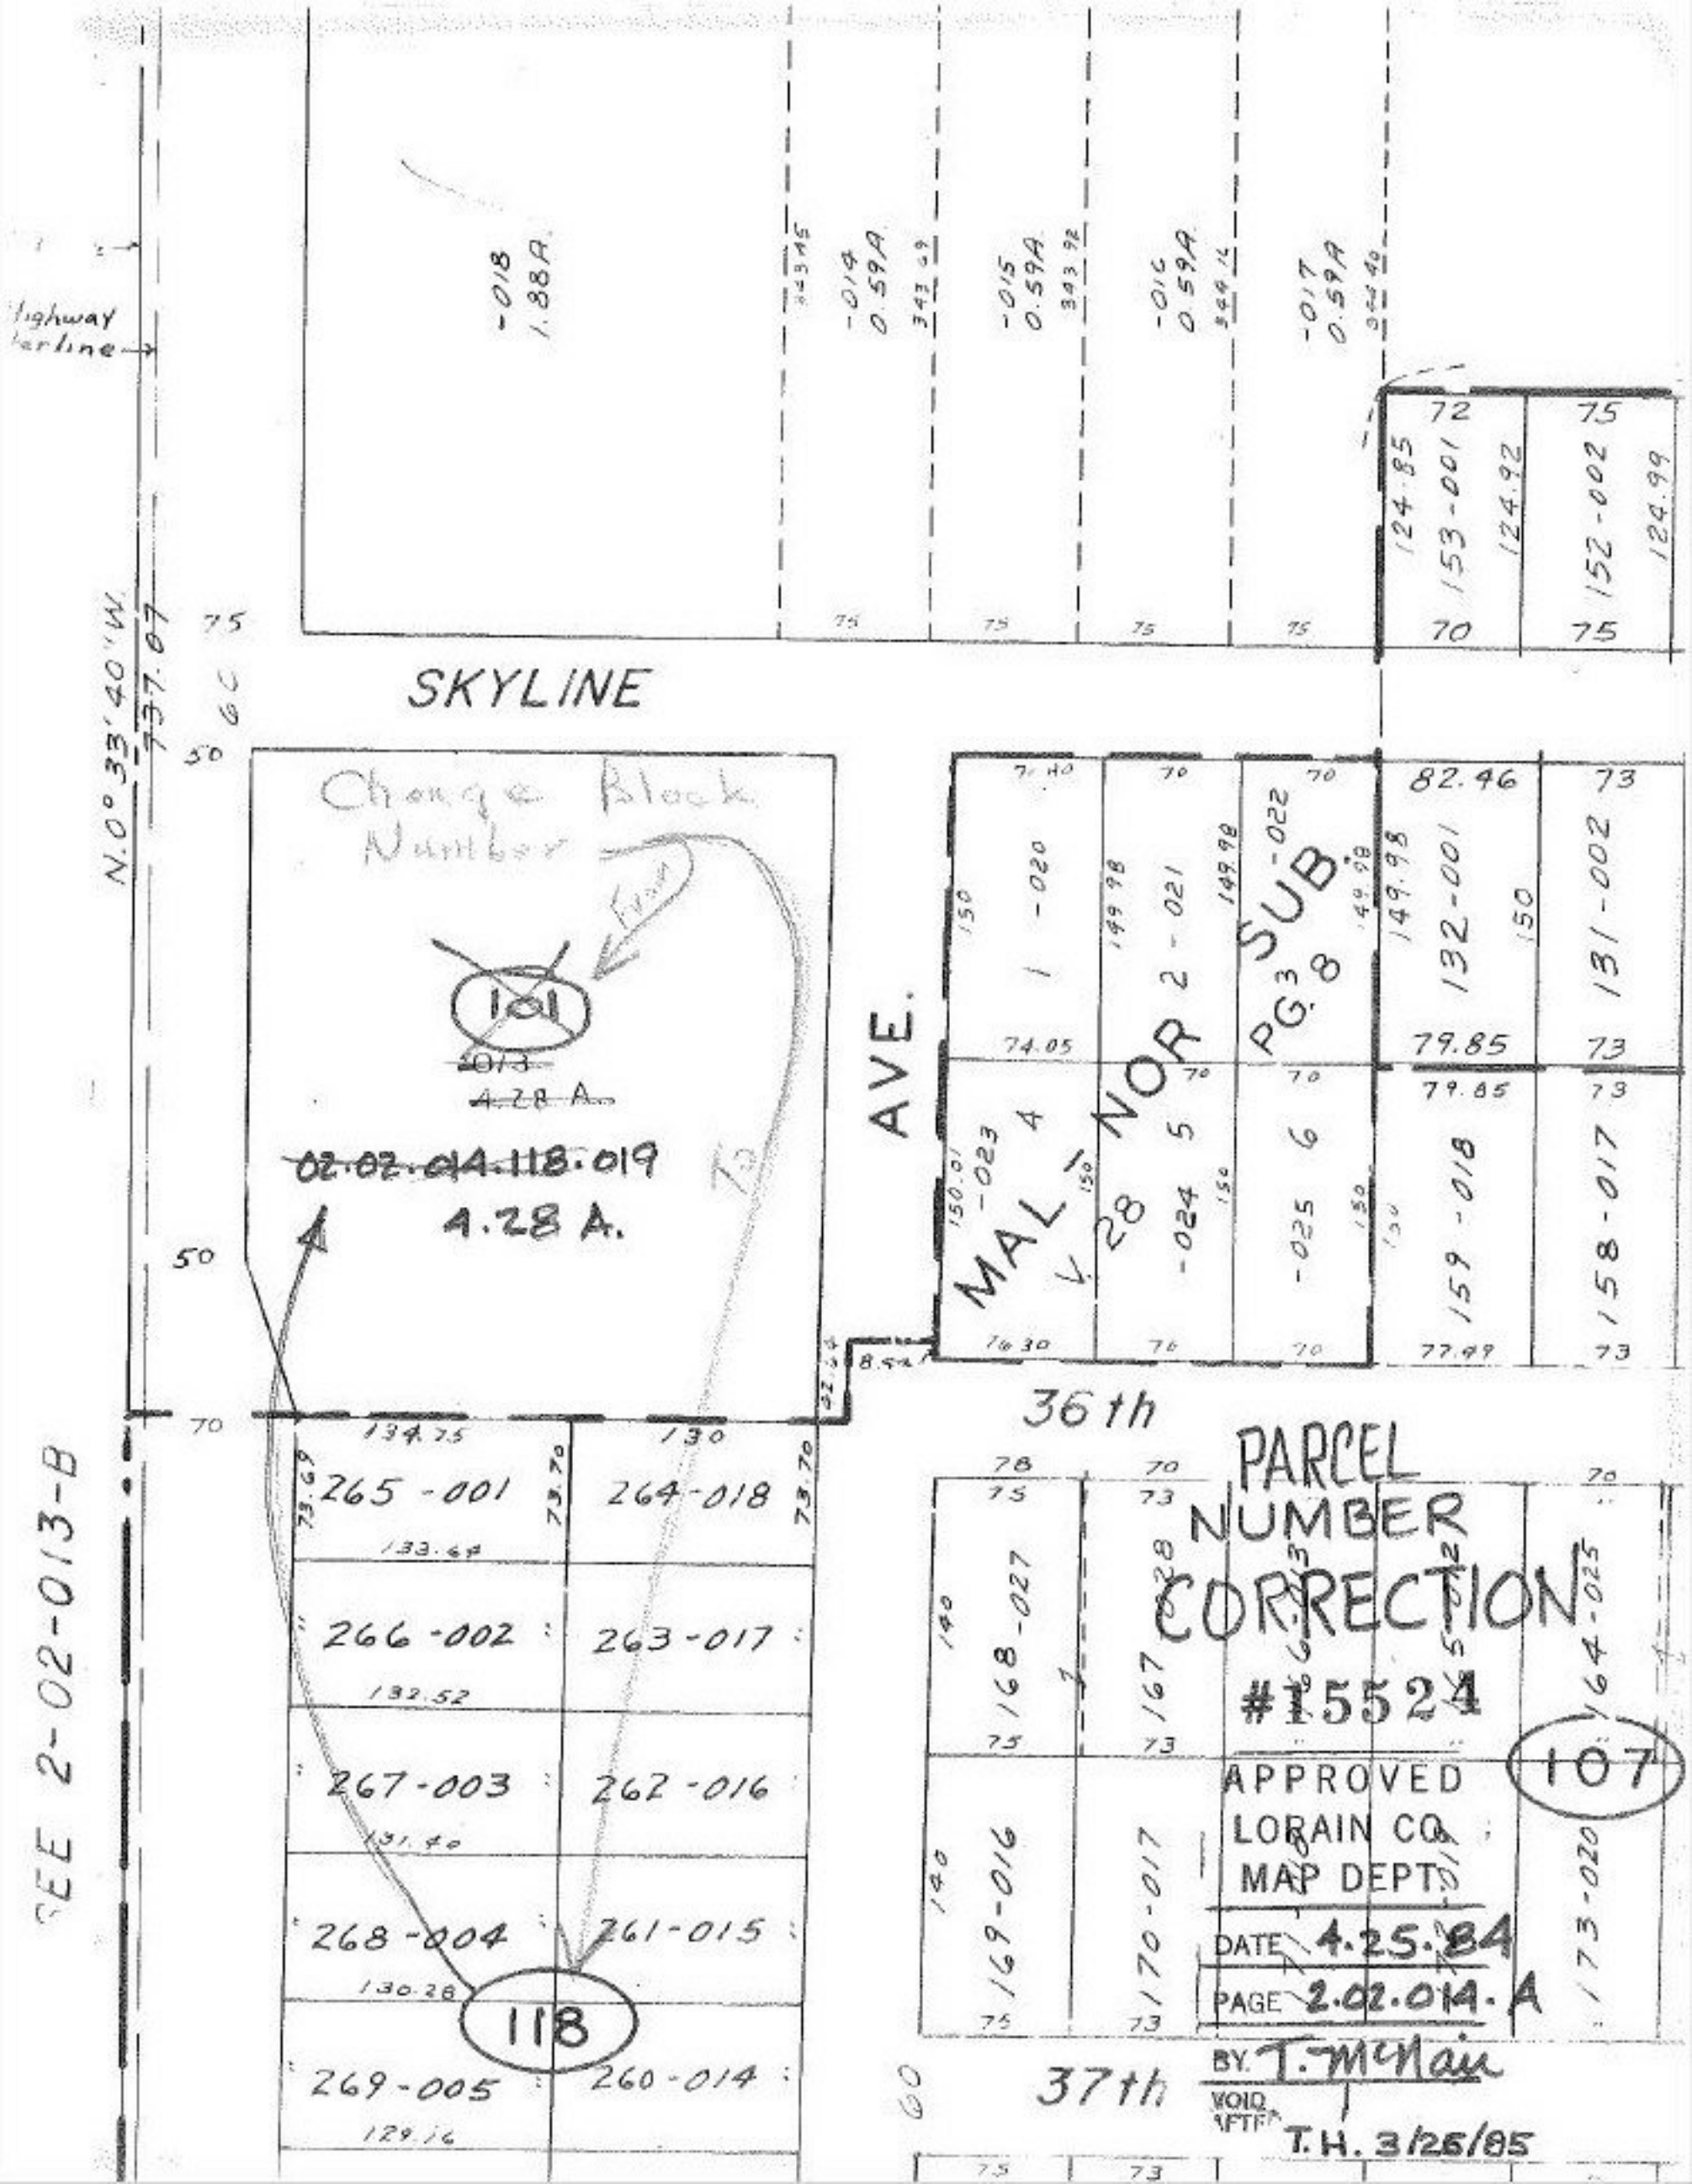

Highway
Centerline
-018
1.88A
-014
0.59A
-015
0.59A
-016
0.59A
-017
0.59A
72
75
124.85
153-001
124.92
152-002
124.99
70
75
SKYLINE
N.0° 33' 40" W.
737.07
75
50
Change Block Number
101
~~-013~~
~~4.28 A.~~
~~02.02.014.118.019~~
4.28 A.
AVE.
MAL-NOR SUB.
V. 28 PG. 8
82.46
73
132-001
131-002
79.85
73
159-018
158-017
77.49
36th
134.75
130
265-001
264-018
133.64
266-002
263-017
132.52
267-003
262-016
131.40
268-004
261-015
130.28
118
269-005
260-014
129.16
SEE 2-02-013-B
PARCEL NUMBER CORRECTION
#15524
168-027
167-028
164-025
169-016
170-017
173-020
107
APPROVED
LORAIN CO.
MAP DEPT.
DATE 4.25.84
PAGE 2.02.014.A
BY T. McNair
VOID AFTER
T.H. 3/26/85
37th