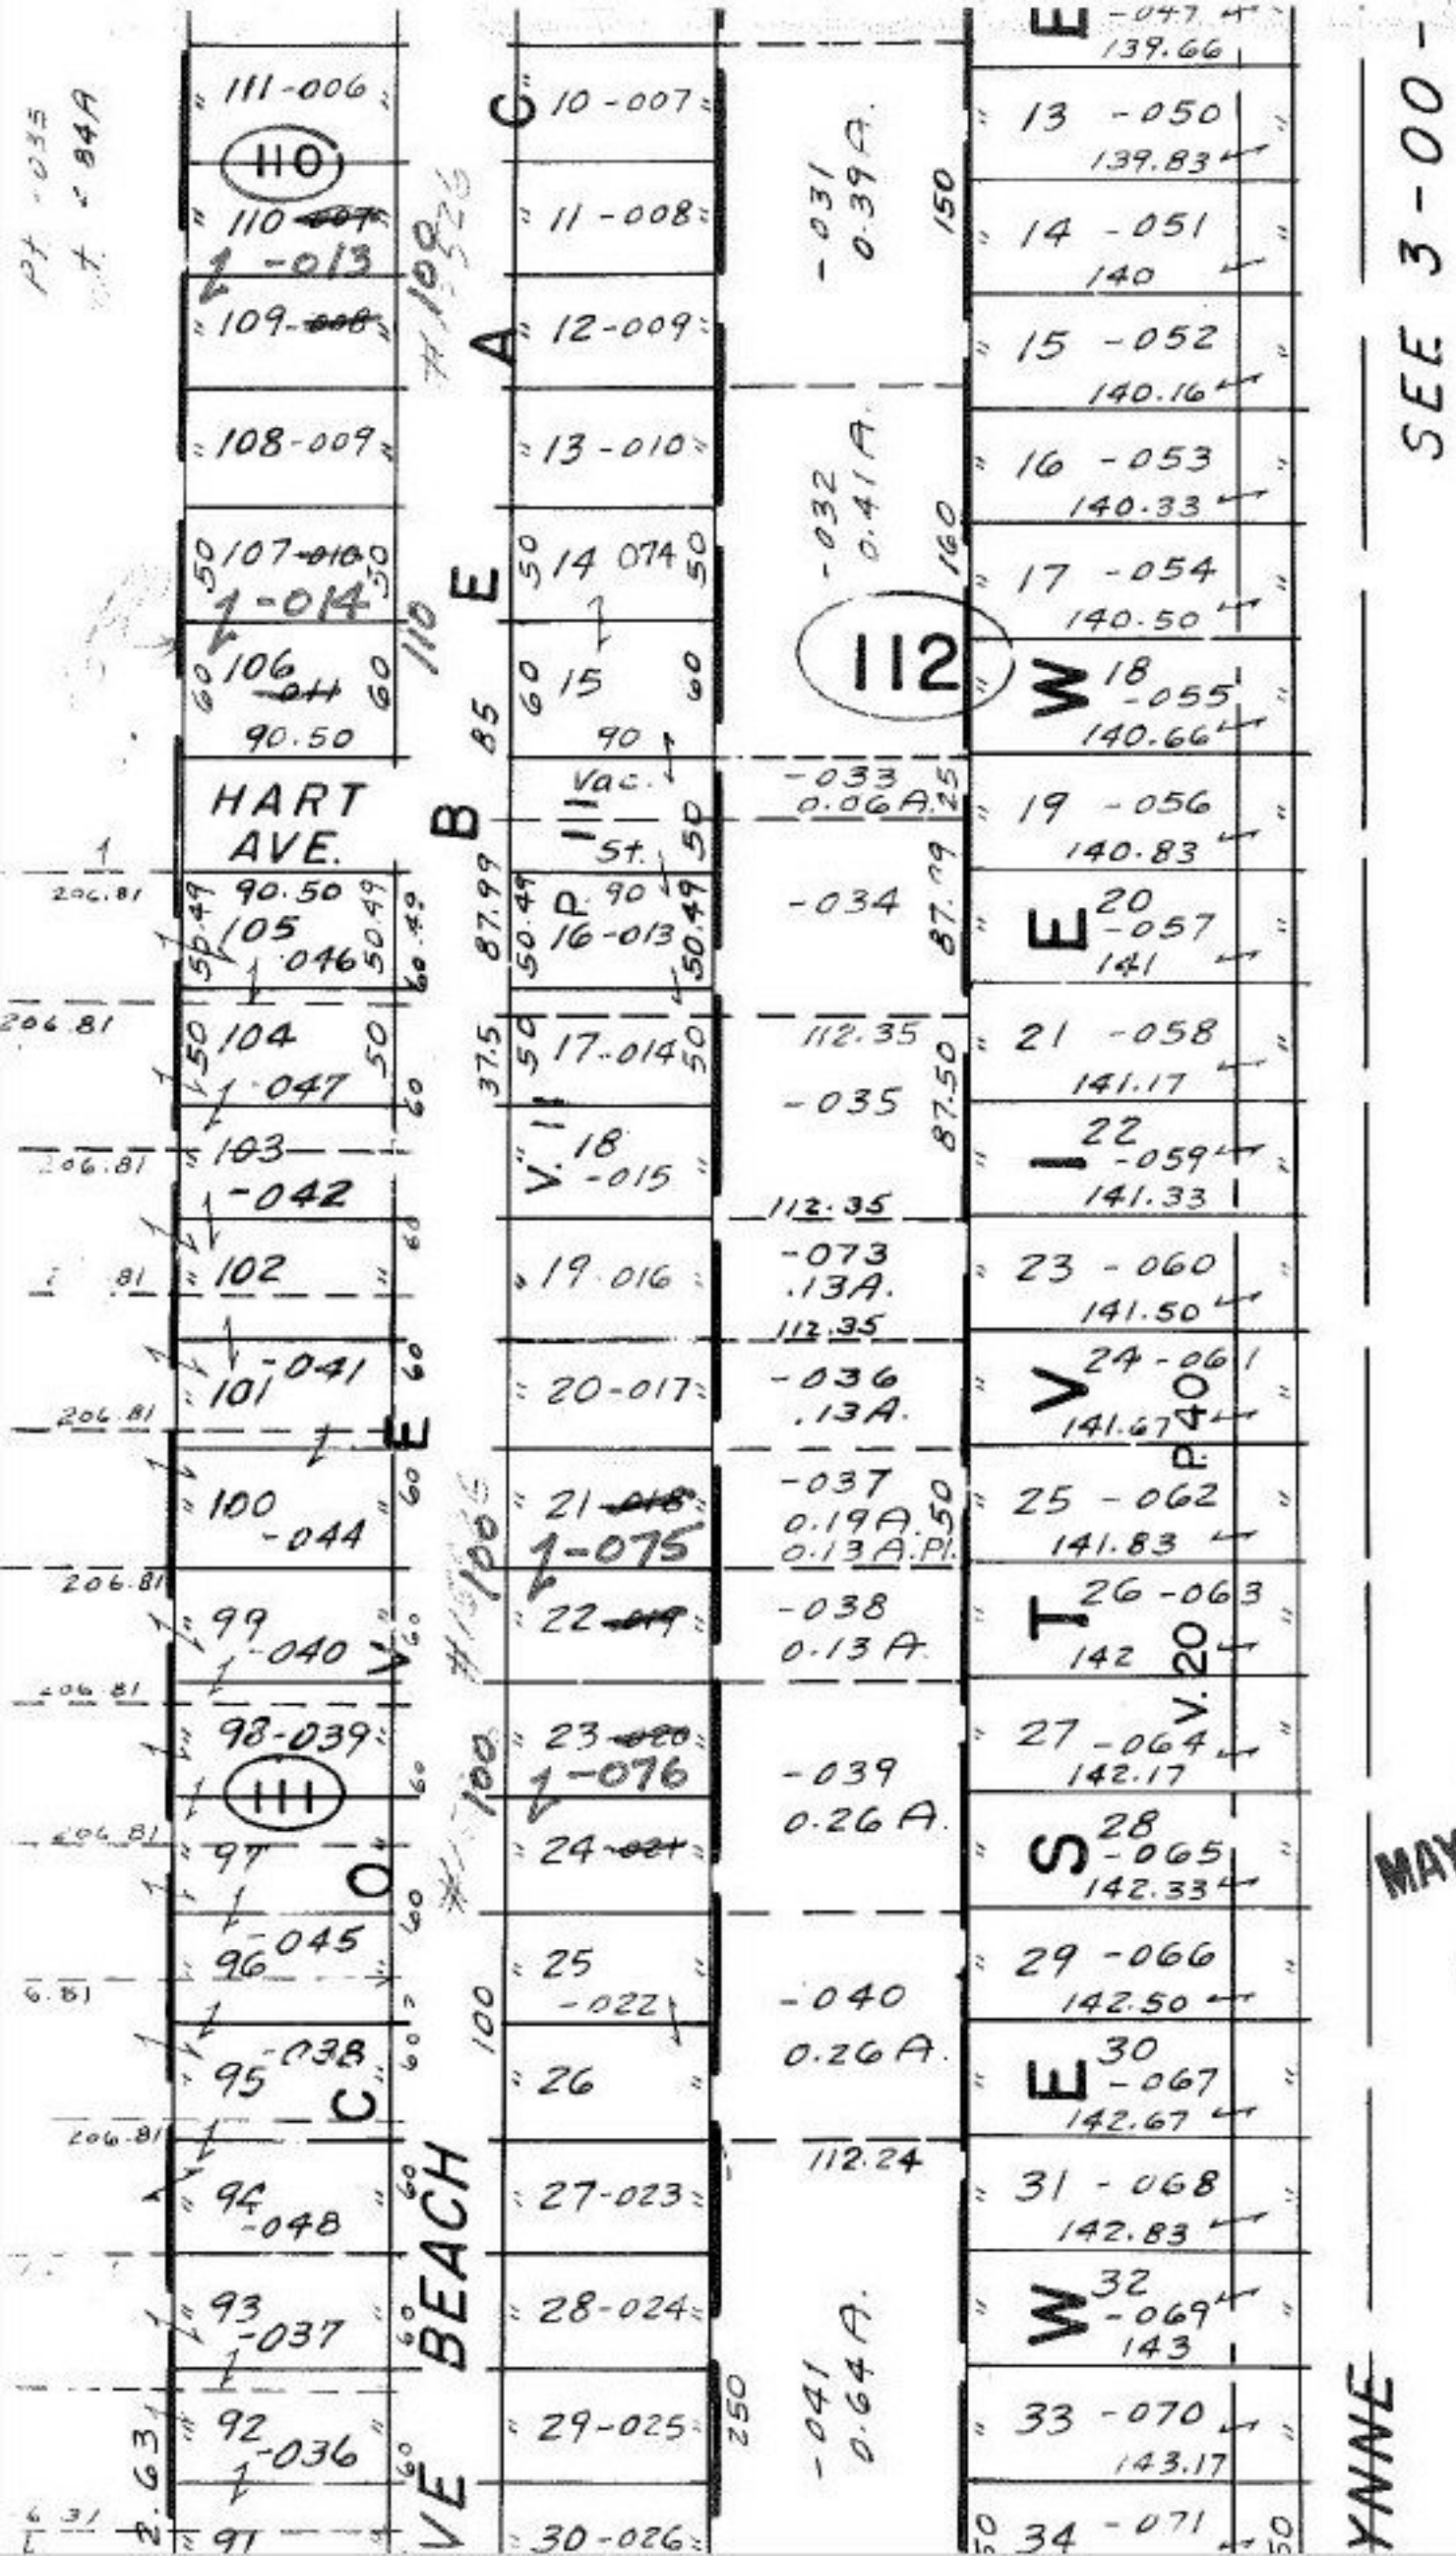

MAY 13 1984

#15526

APPROVED
LORAIN CO.
MAP DEPT.

DATE 5-4-84

PAGE 3-00-033 A

BY [signature]

VOID AFTER 15526