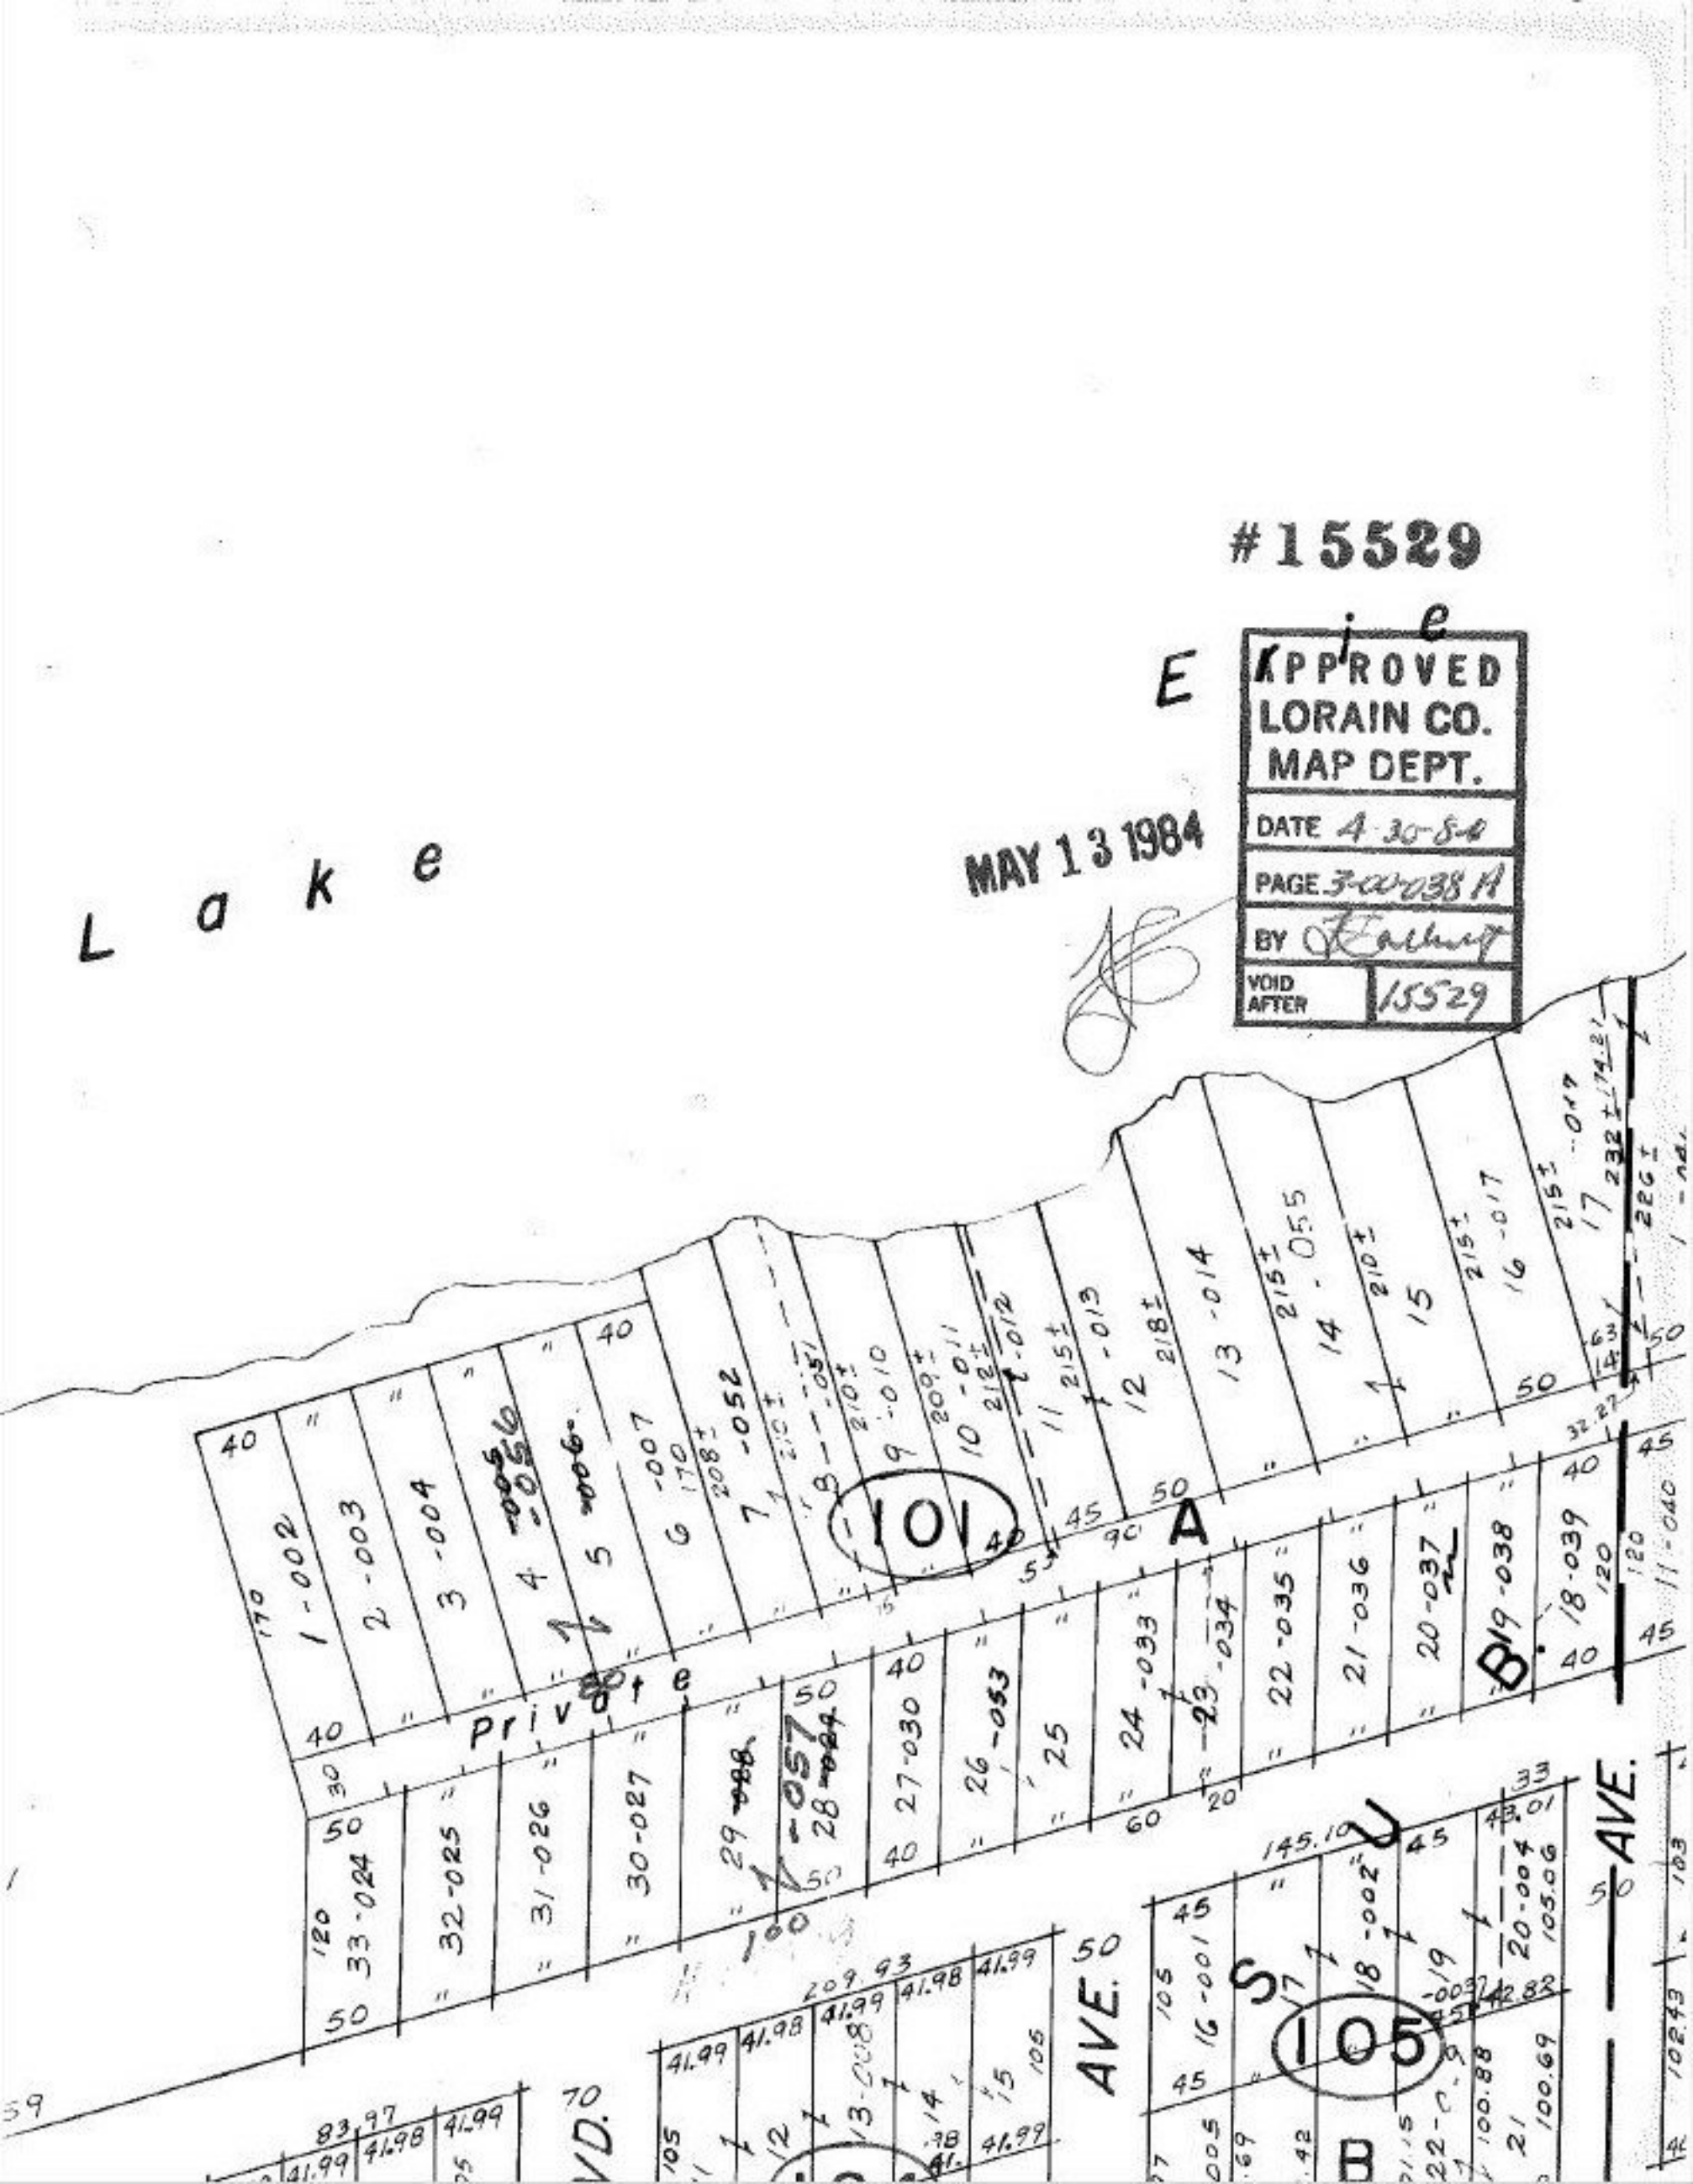
#15529
APPROVED
LORAIN CO.
MAP DEPT.
DATE 4-30-84
PAGE 3-00-038 A
BY
VOID AFTER 15529
MAY 13 1984
Lake
Private
101
105
A
B
S
AVE.