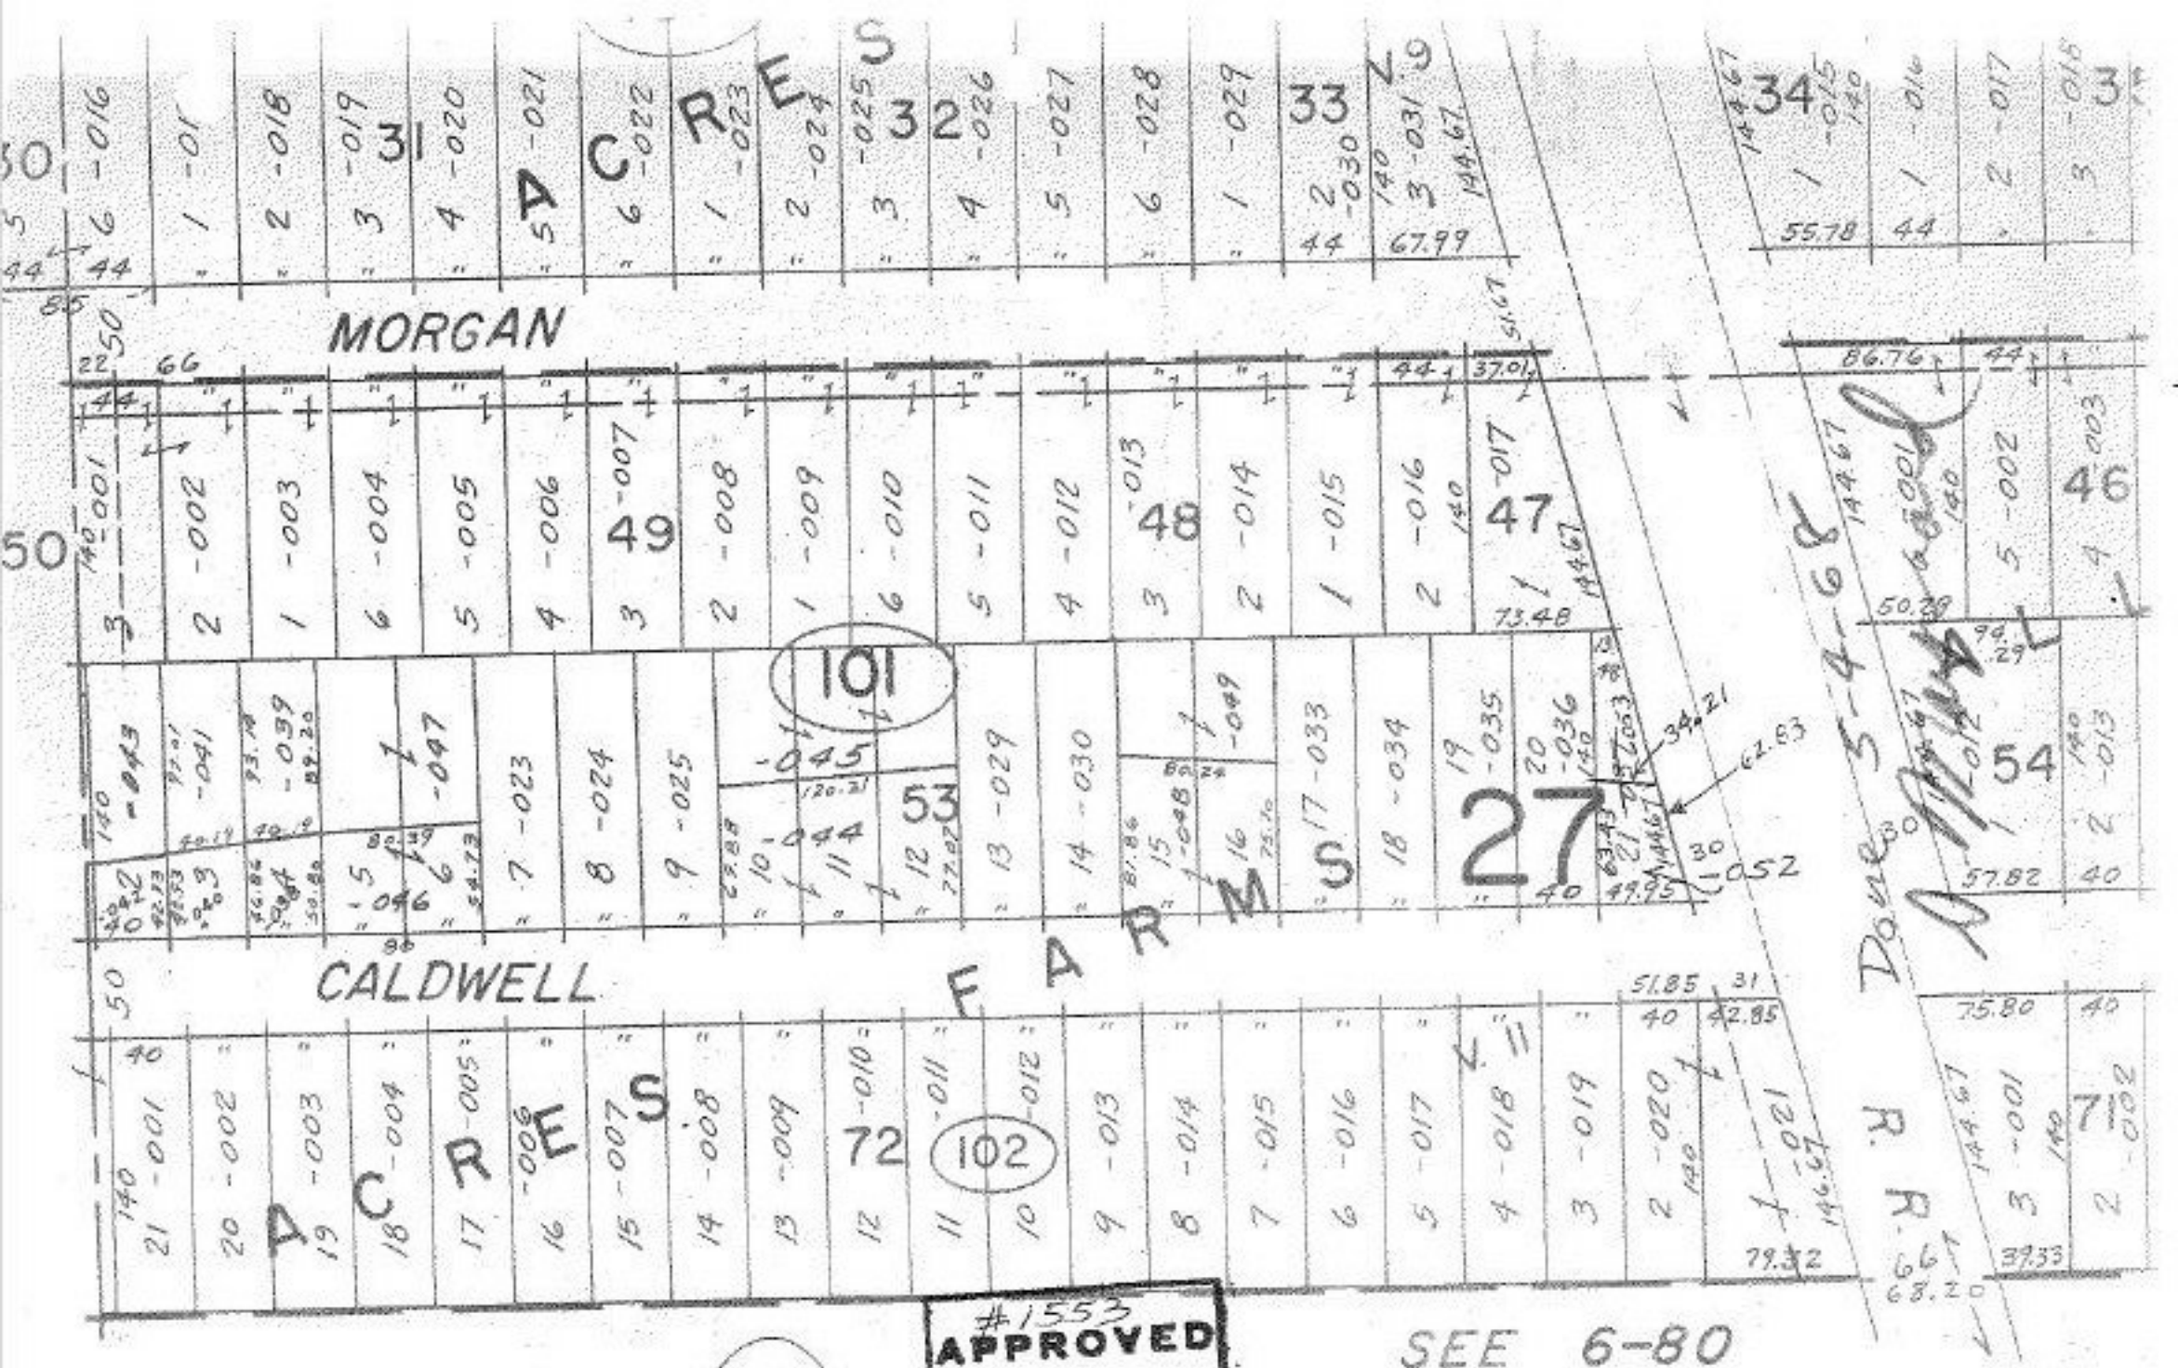

#1553
APPROVED
LORAIN CO.
MAP DEPT.
DATE 3-7-68
6-62
BY D. Maynard

ELYRIA

SCALE: 1" = 100'

WEST OF RIVE
PT. LOTS 33, 3