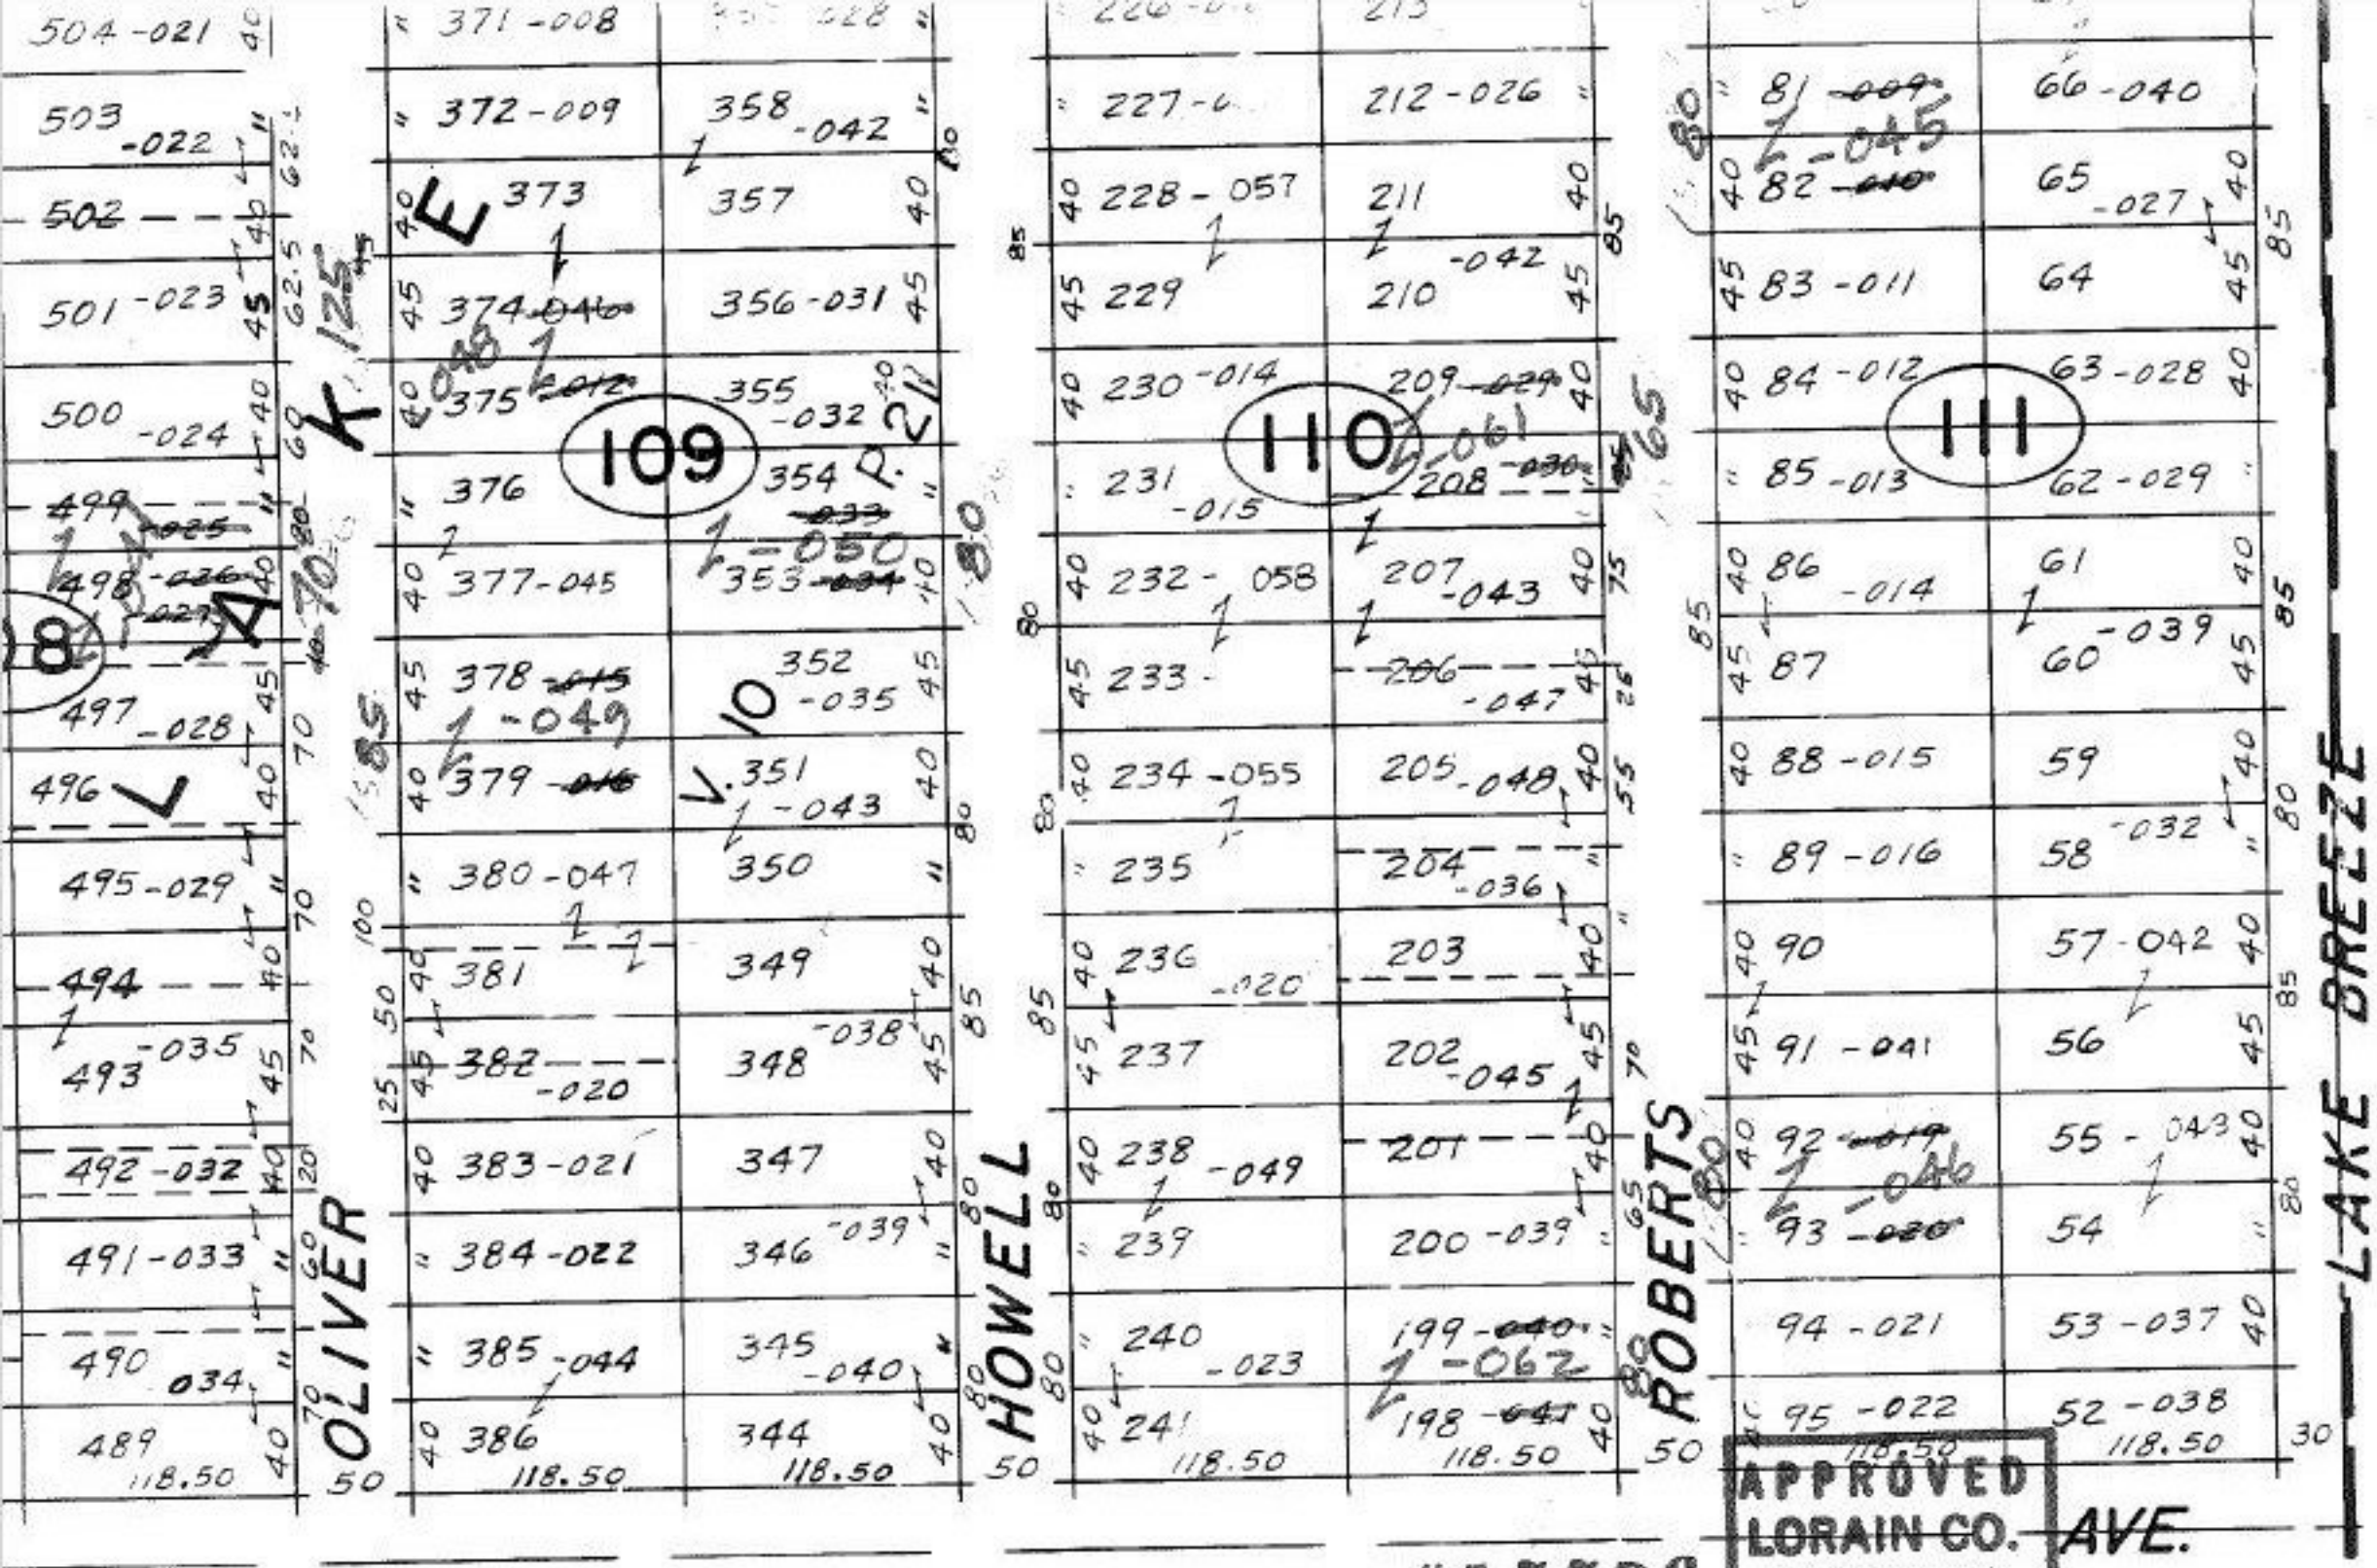

SEE 3-00-042-B

MAY 13 1984

#15536

#15537

APPROVED
LORAIN CO.
MAP DEPT.
DATE 4-30-84 5-4-84
PAGE 3-00-042 A
BY
VOID AFTER 1553 6/7