 
103
108
109
AVE.
AVE.
AVE.
Vac.
B.
C
H
I
S
U
-004
-015
-019
-020
-016
-012
-013
-005
-009
-010
-011
-018
-026
-022
-023
-024
-025
-027
-028
