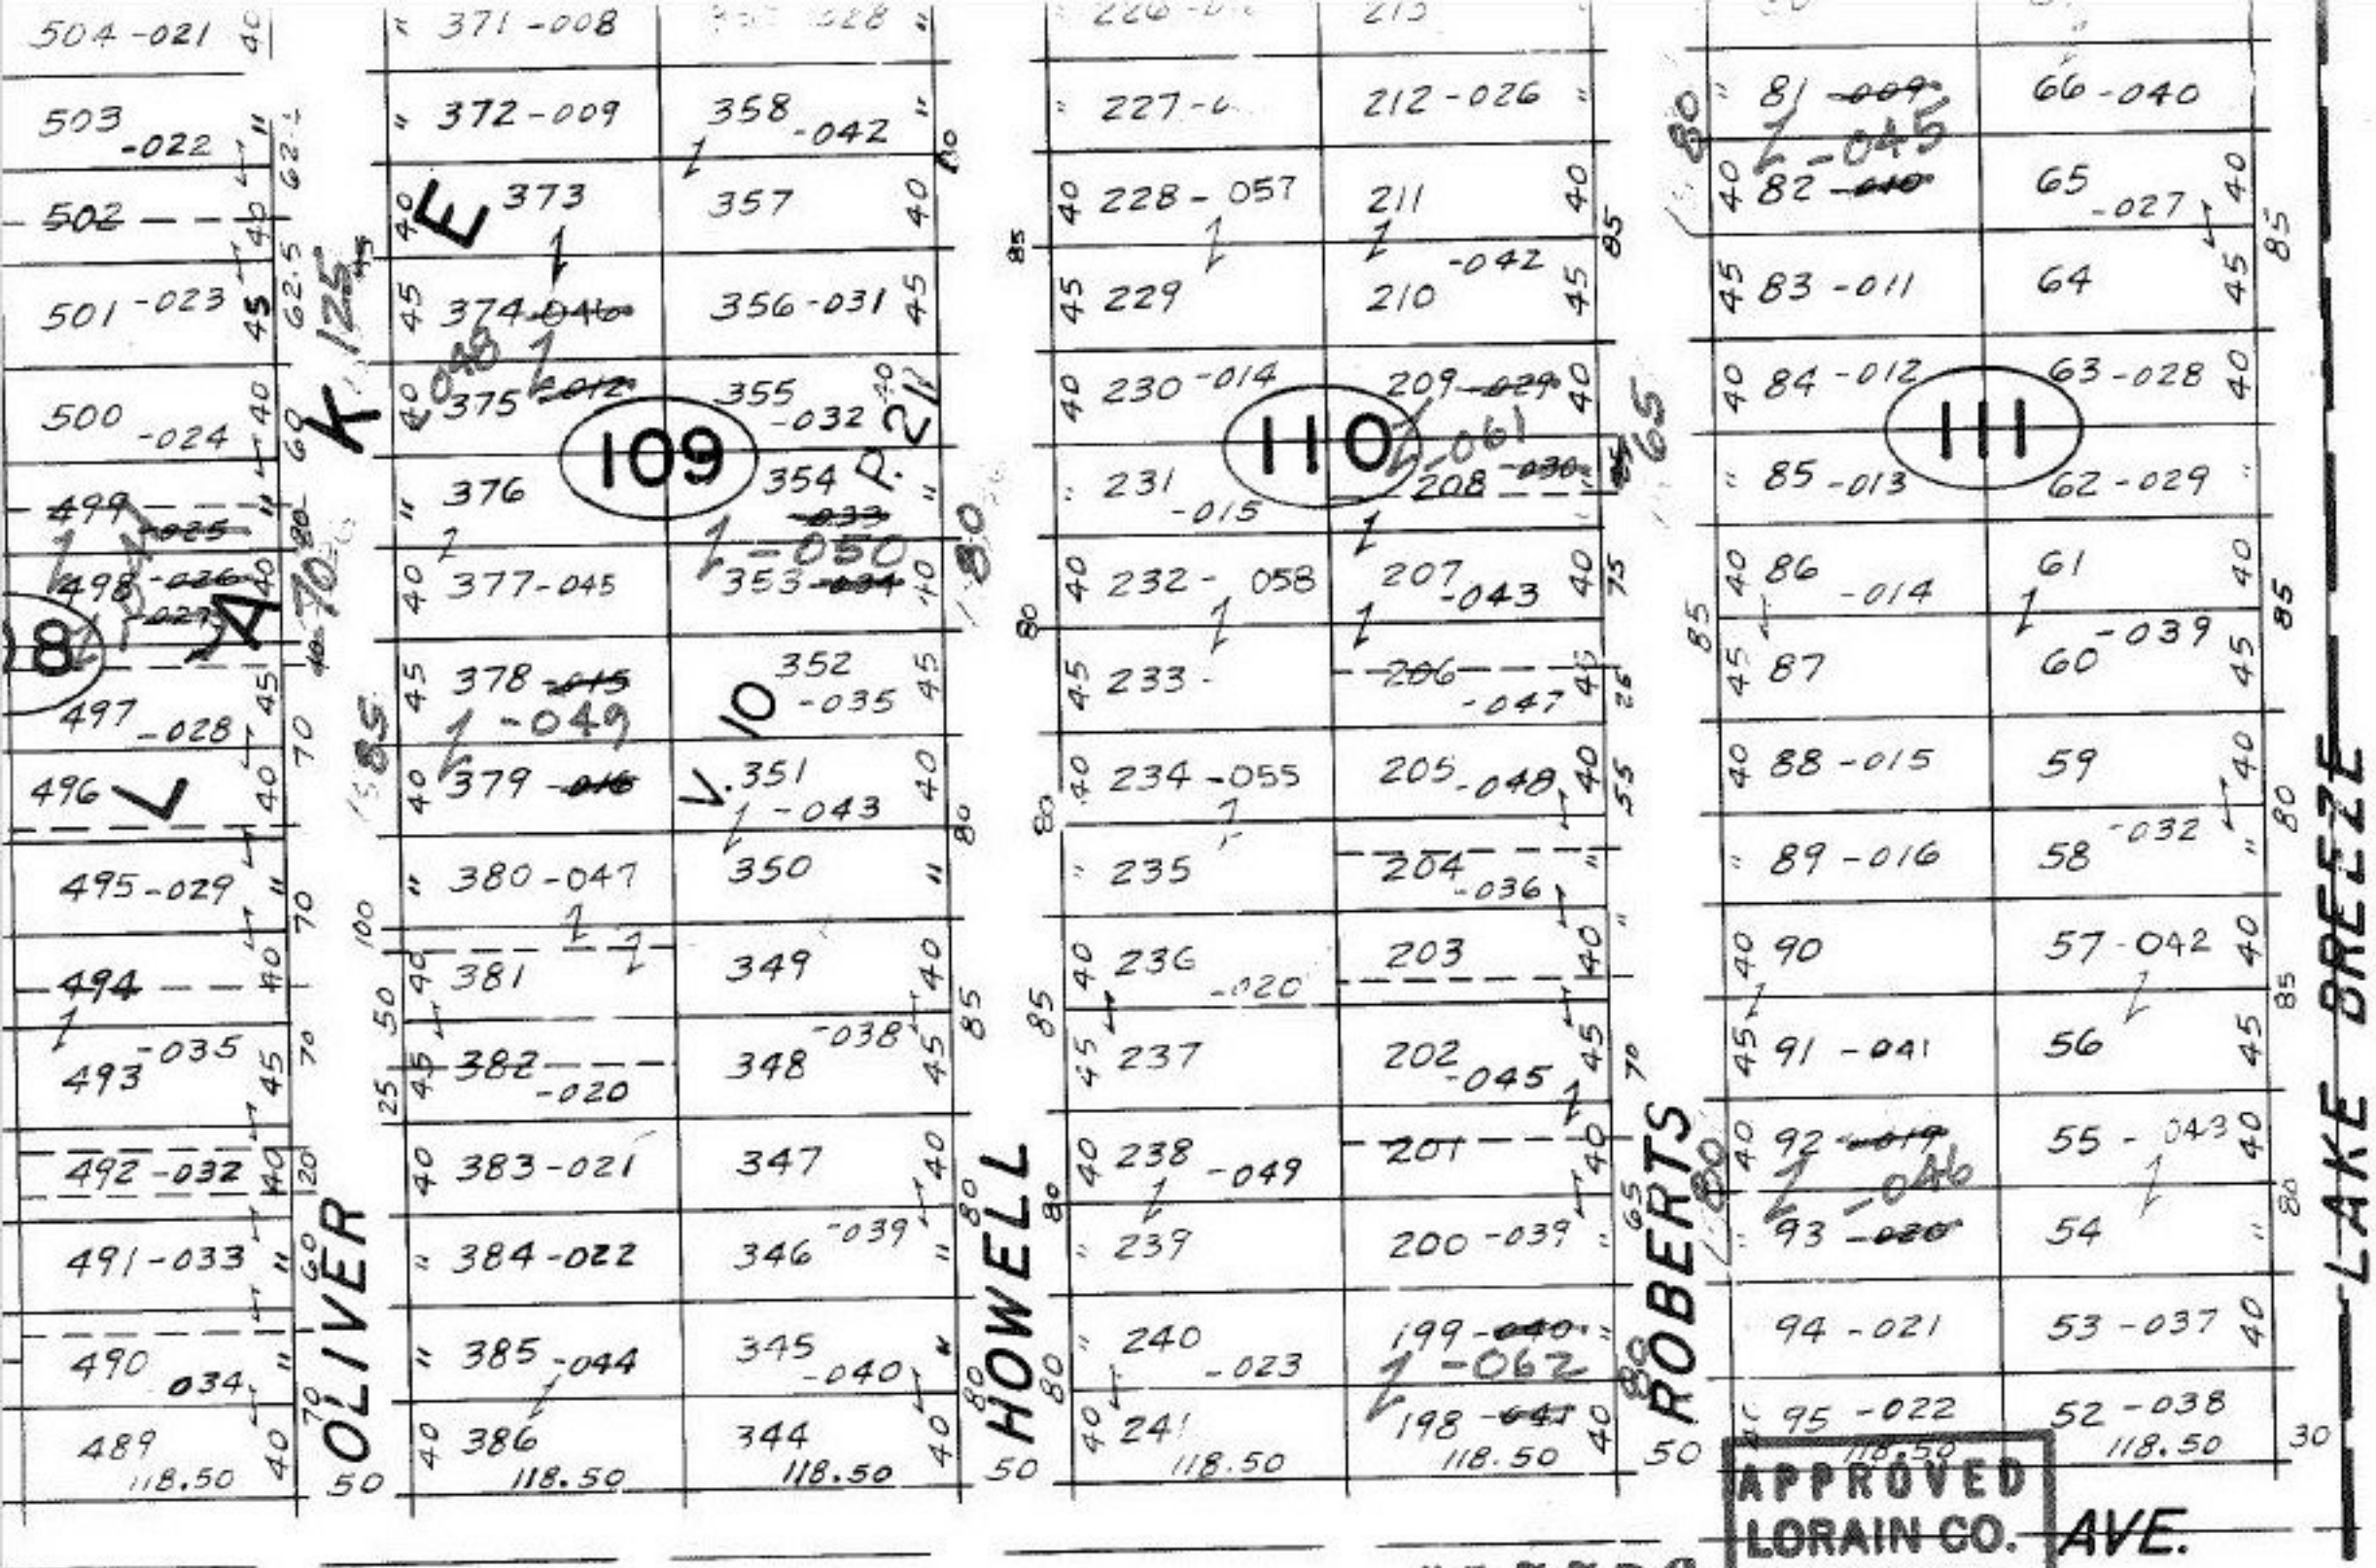

SEE 3-00-042-B

MAY 13 1984

#15536

#15537

APPROVED
LORAIN CO.
MAP DEPT.
DATE ~~4-30-84~~
PAGE 3-00-042 A
BY [signature]
VOID AFTER 1553 6/7

5-4-84