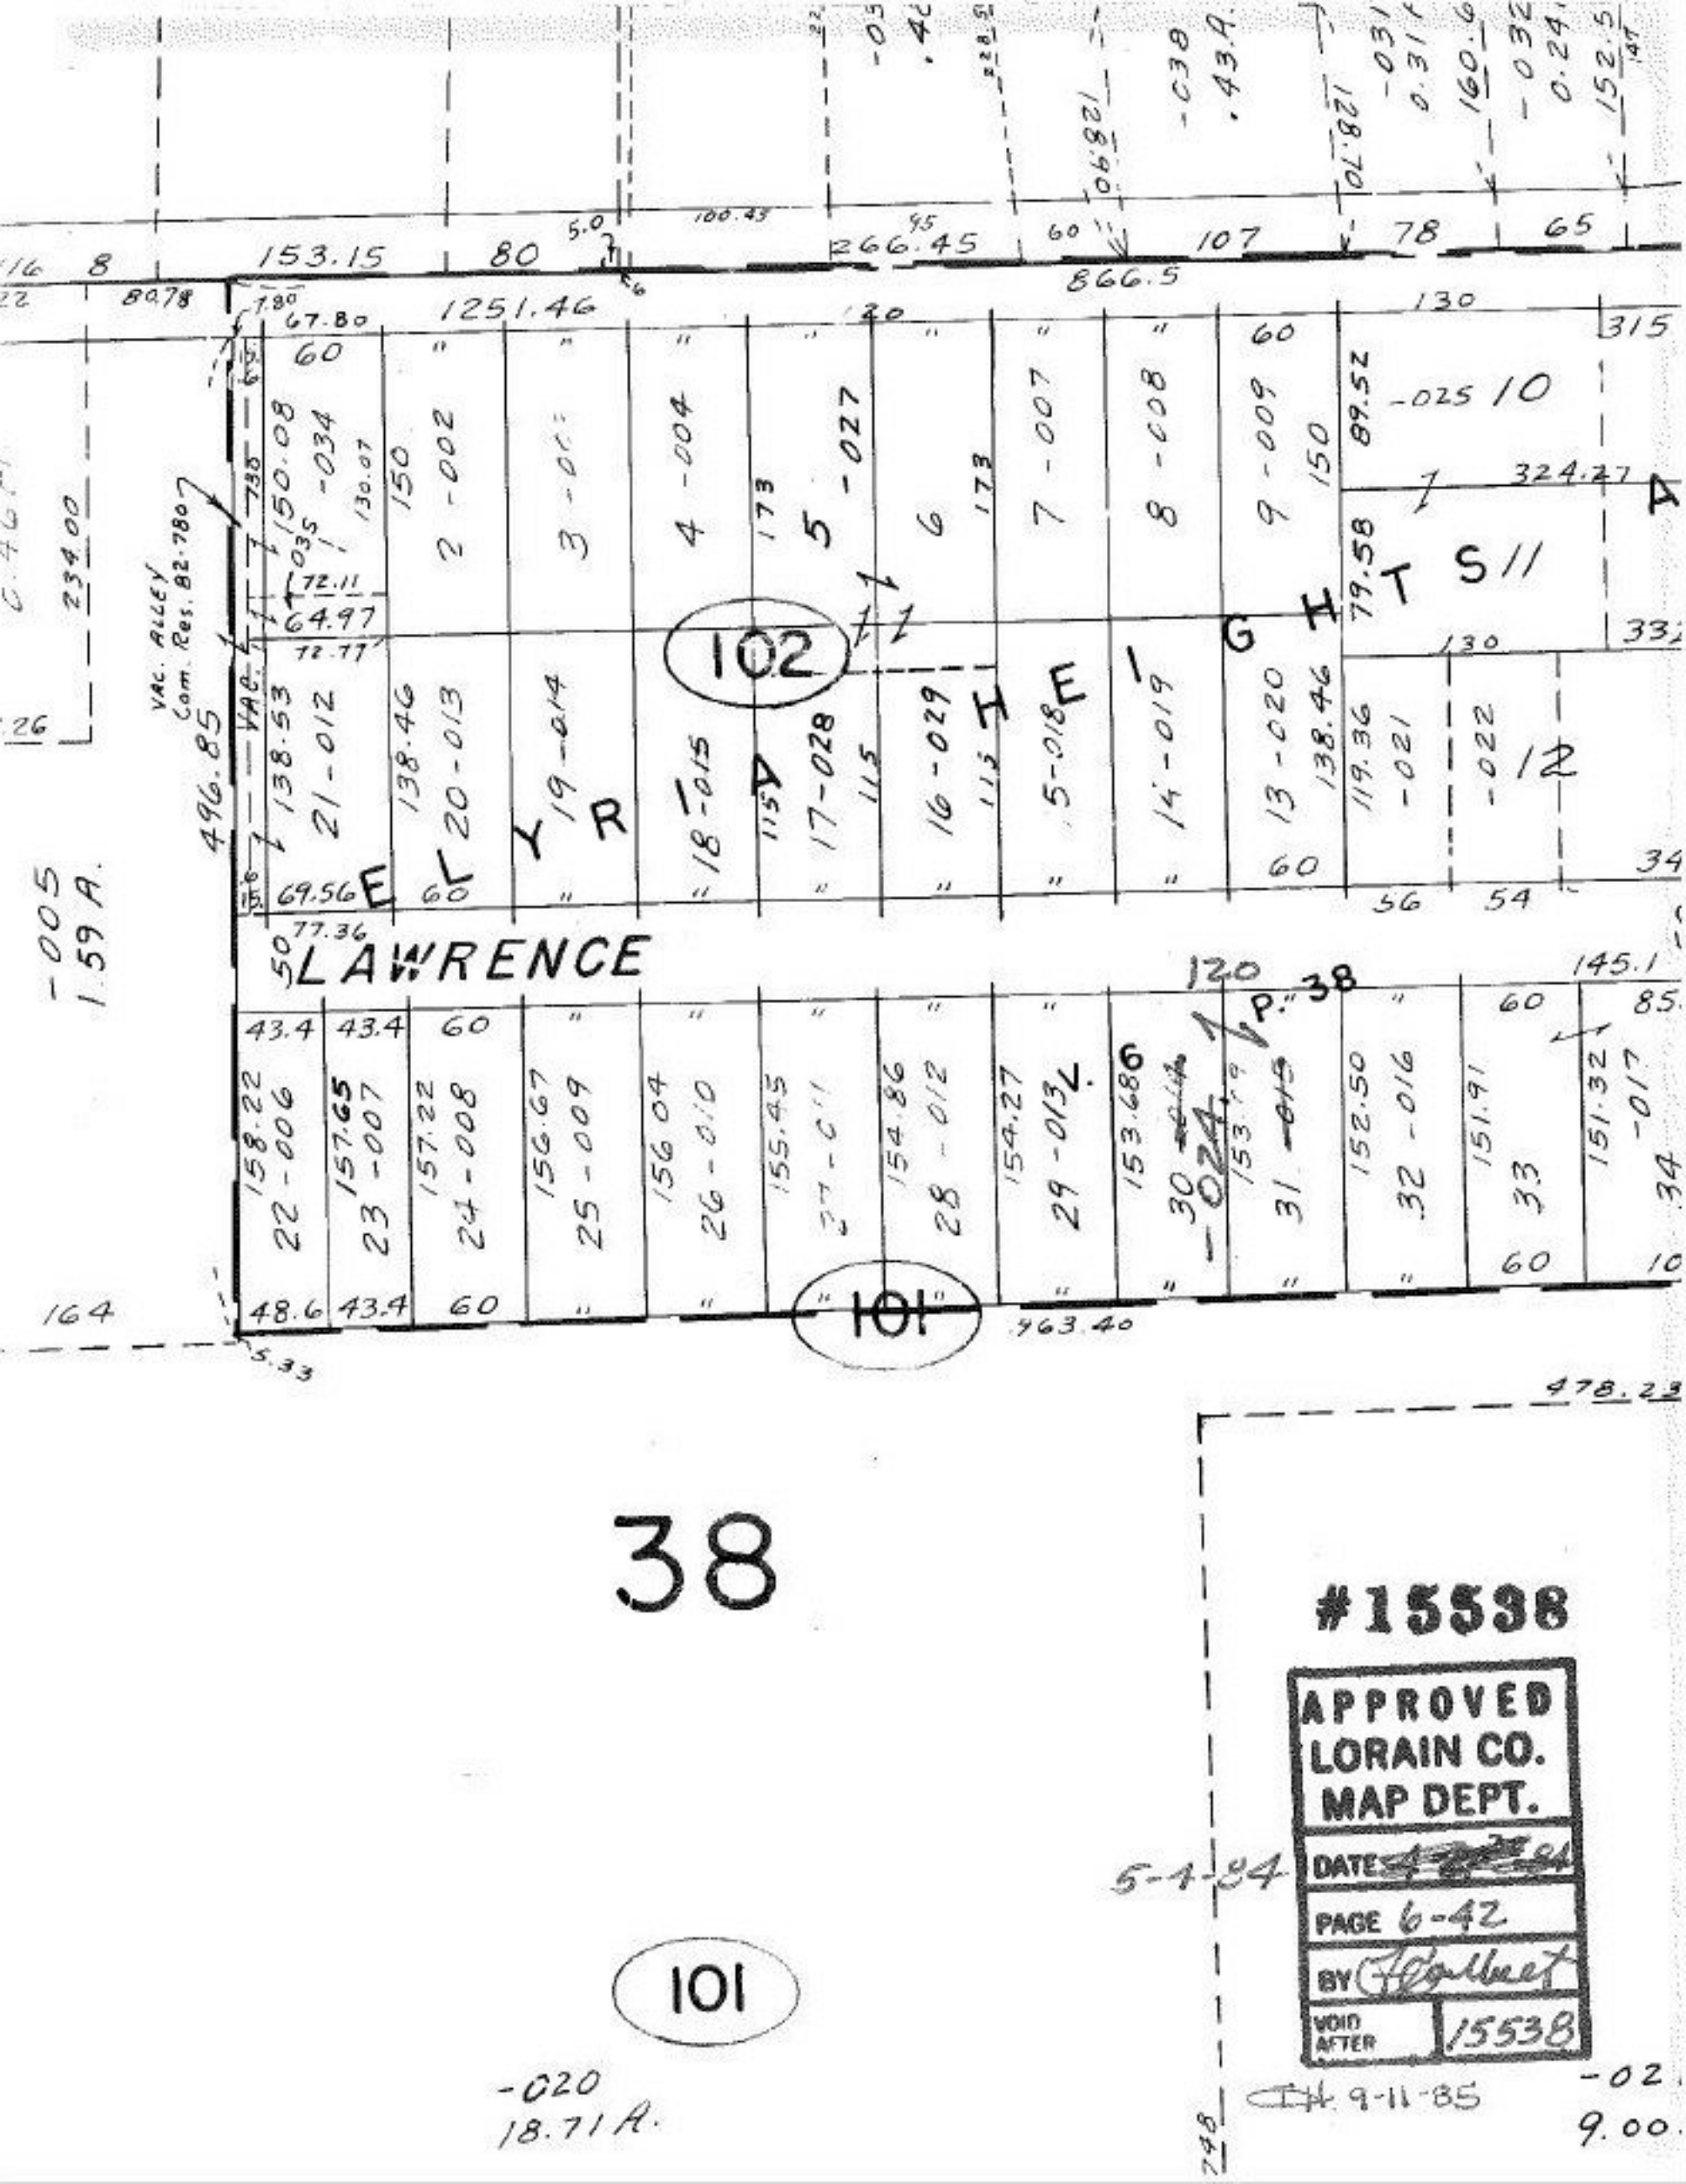

ELYRIA HEIGHTS
LAWRENCE
102
101
38
VAC. ALLEY Com. Res. 82-780
VAC.
P. 38
#15538
APPROVED
LORAIN CO.
MAP DEPT.
DATE
PAGE 6-42
BY
VOID AFTER 15538
5-4-84
9-11-85
-020
18.71 A.
-02
9.00