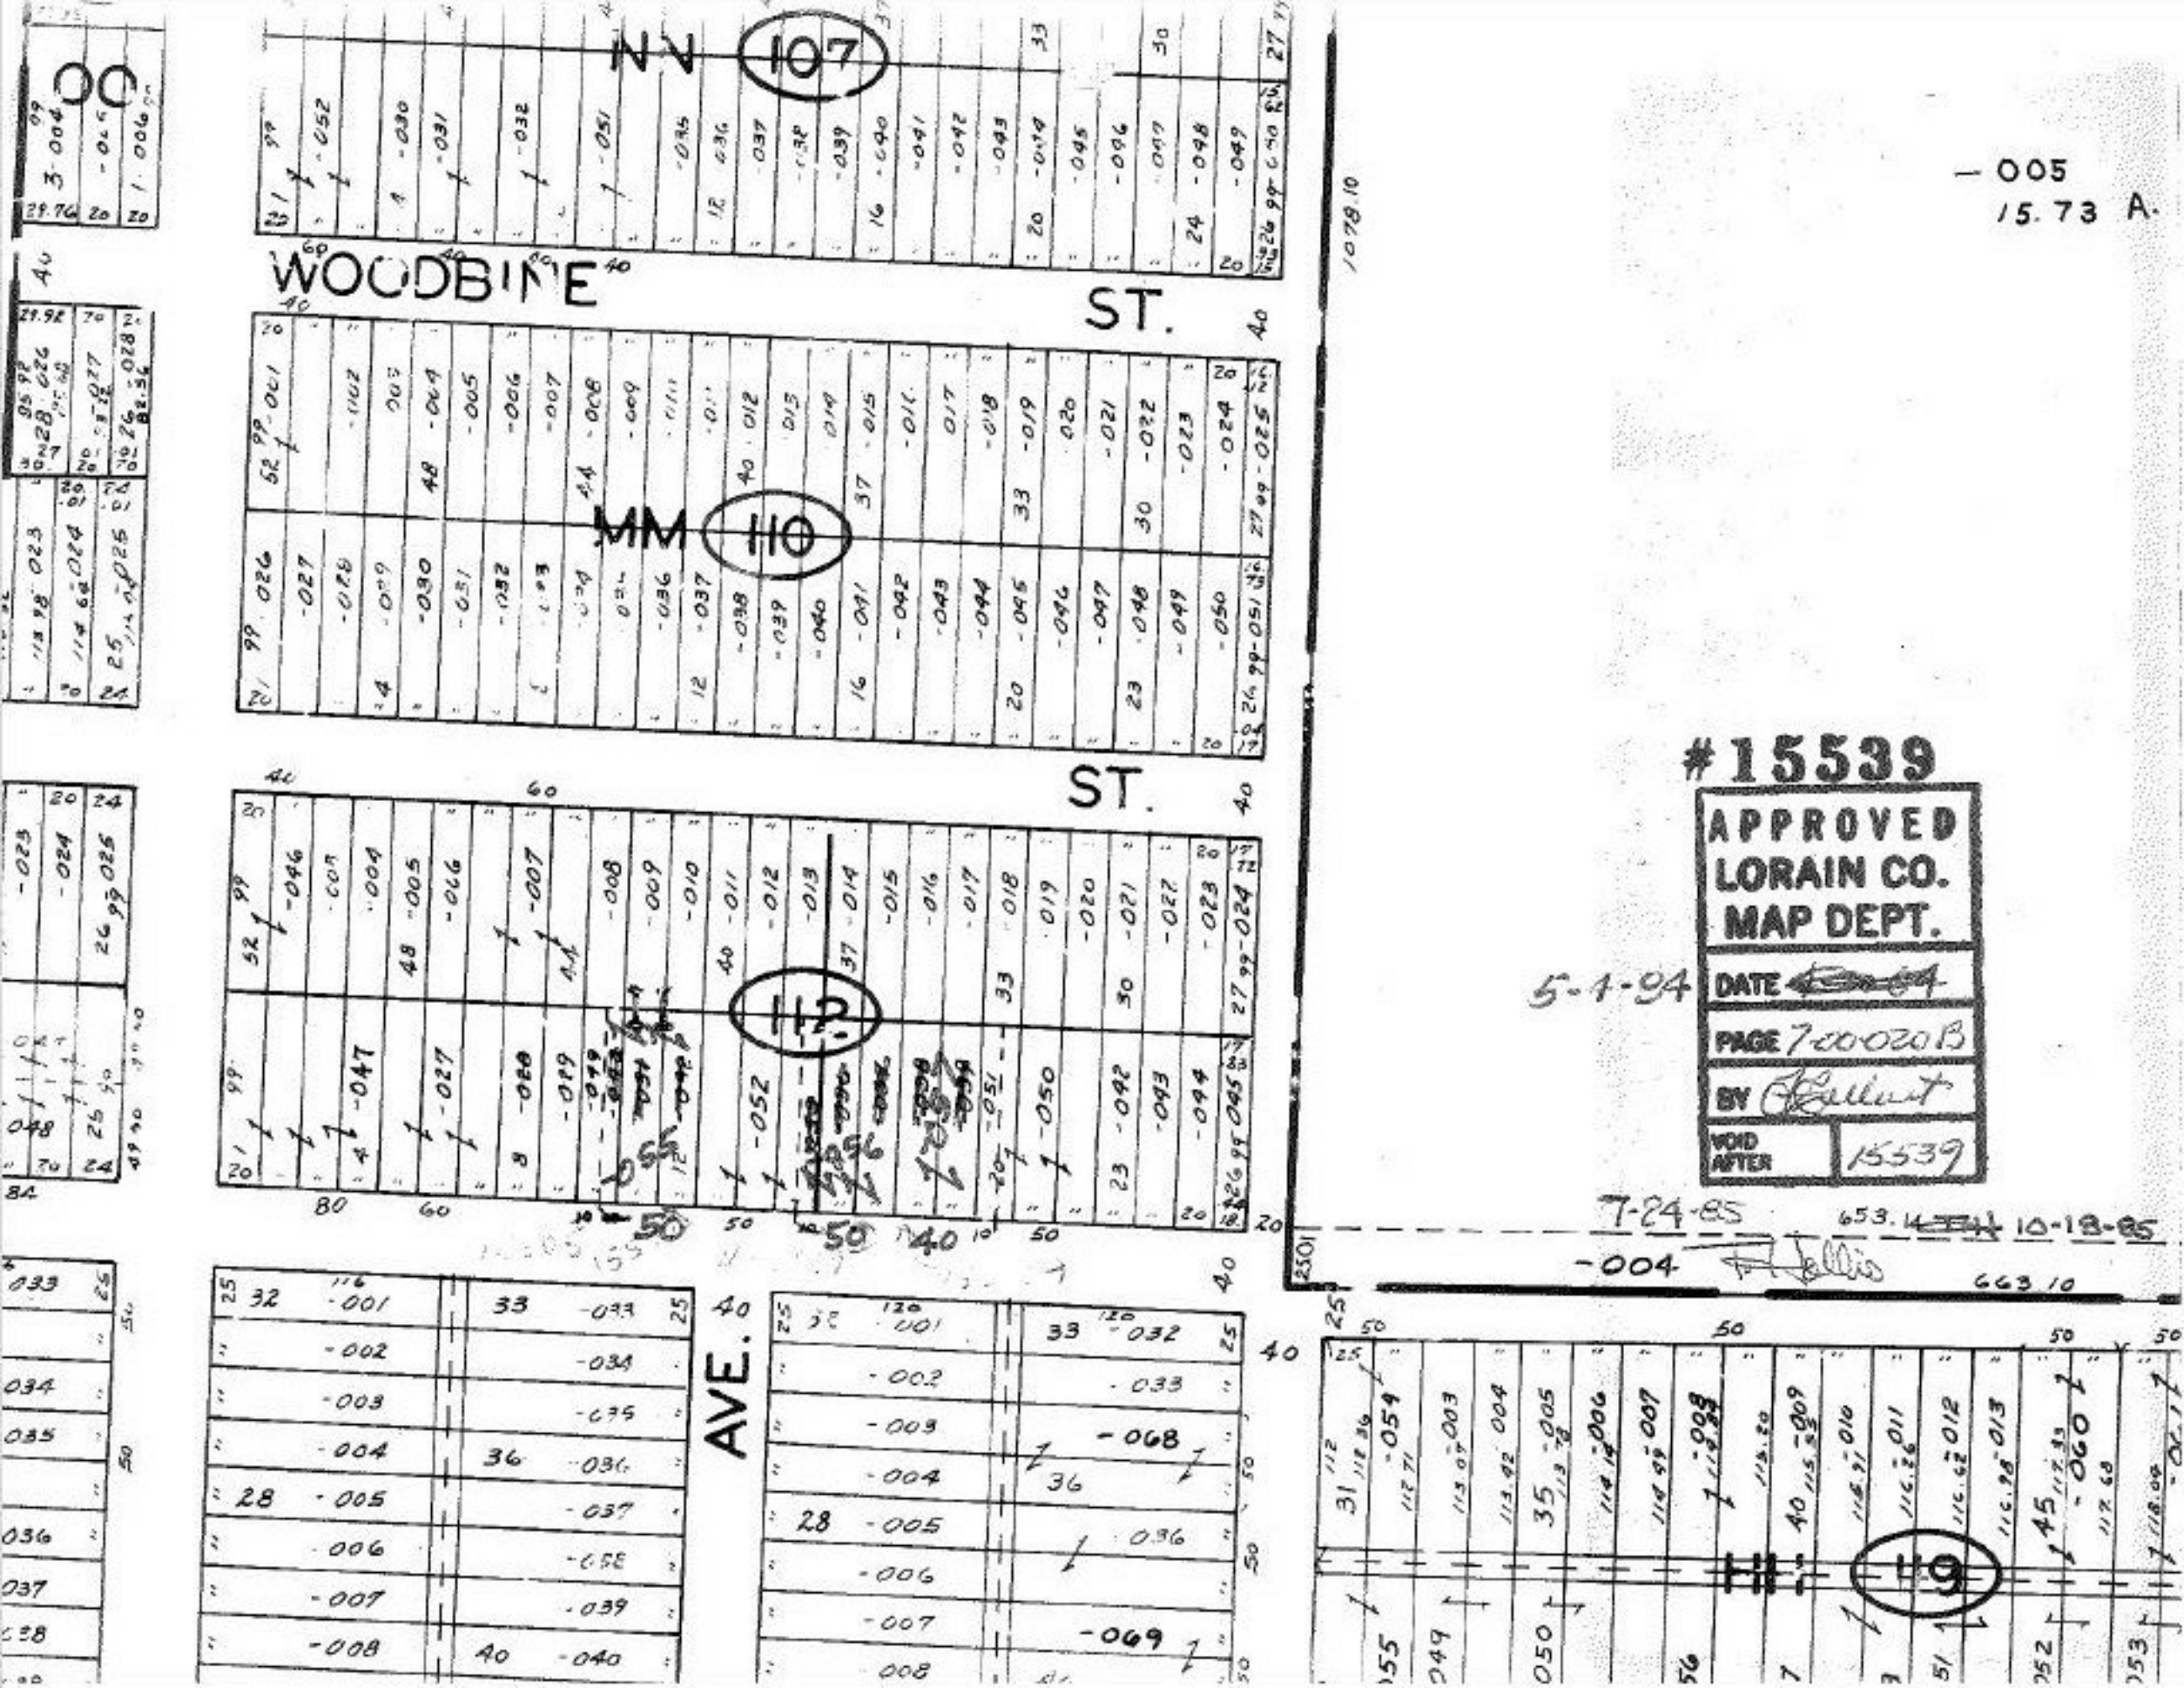

NN 107
WOODBINE ST.
MM 110
ST.
112
AVE.
HH 119
-005
15.73 A.
#15539
APPROVED
LORAIN CO.
MAP DEPT.
DATE
PAGE 7-00-020B
BY
VOID AFTER 15539
5-1-94
7-24-85
10-18-85
-004