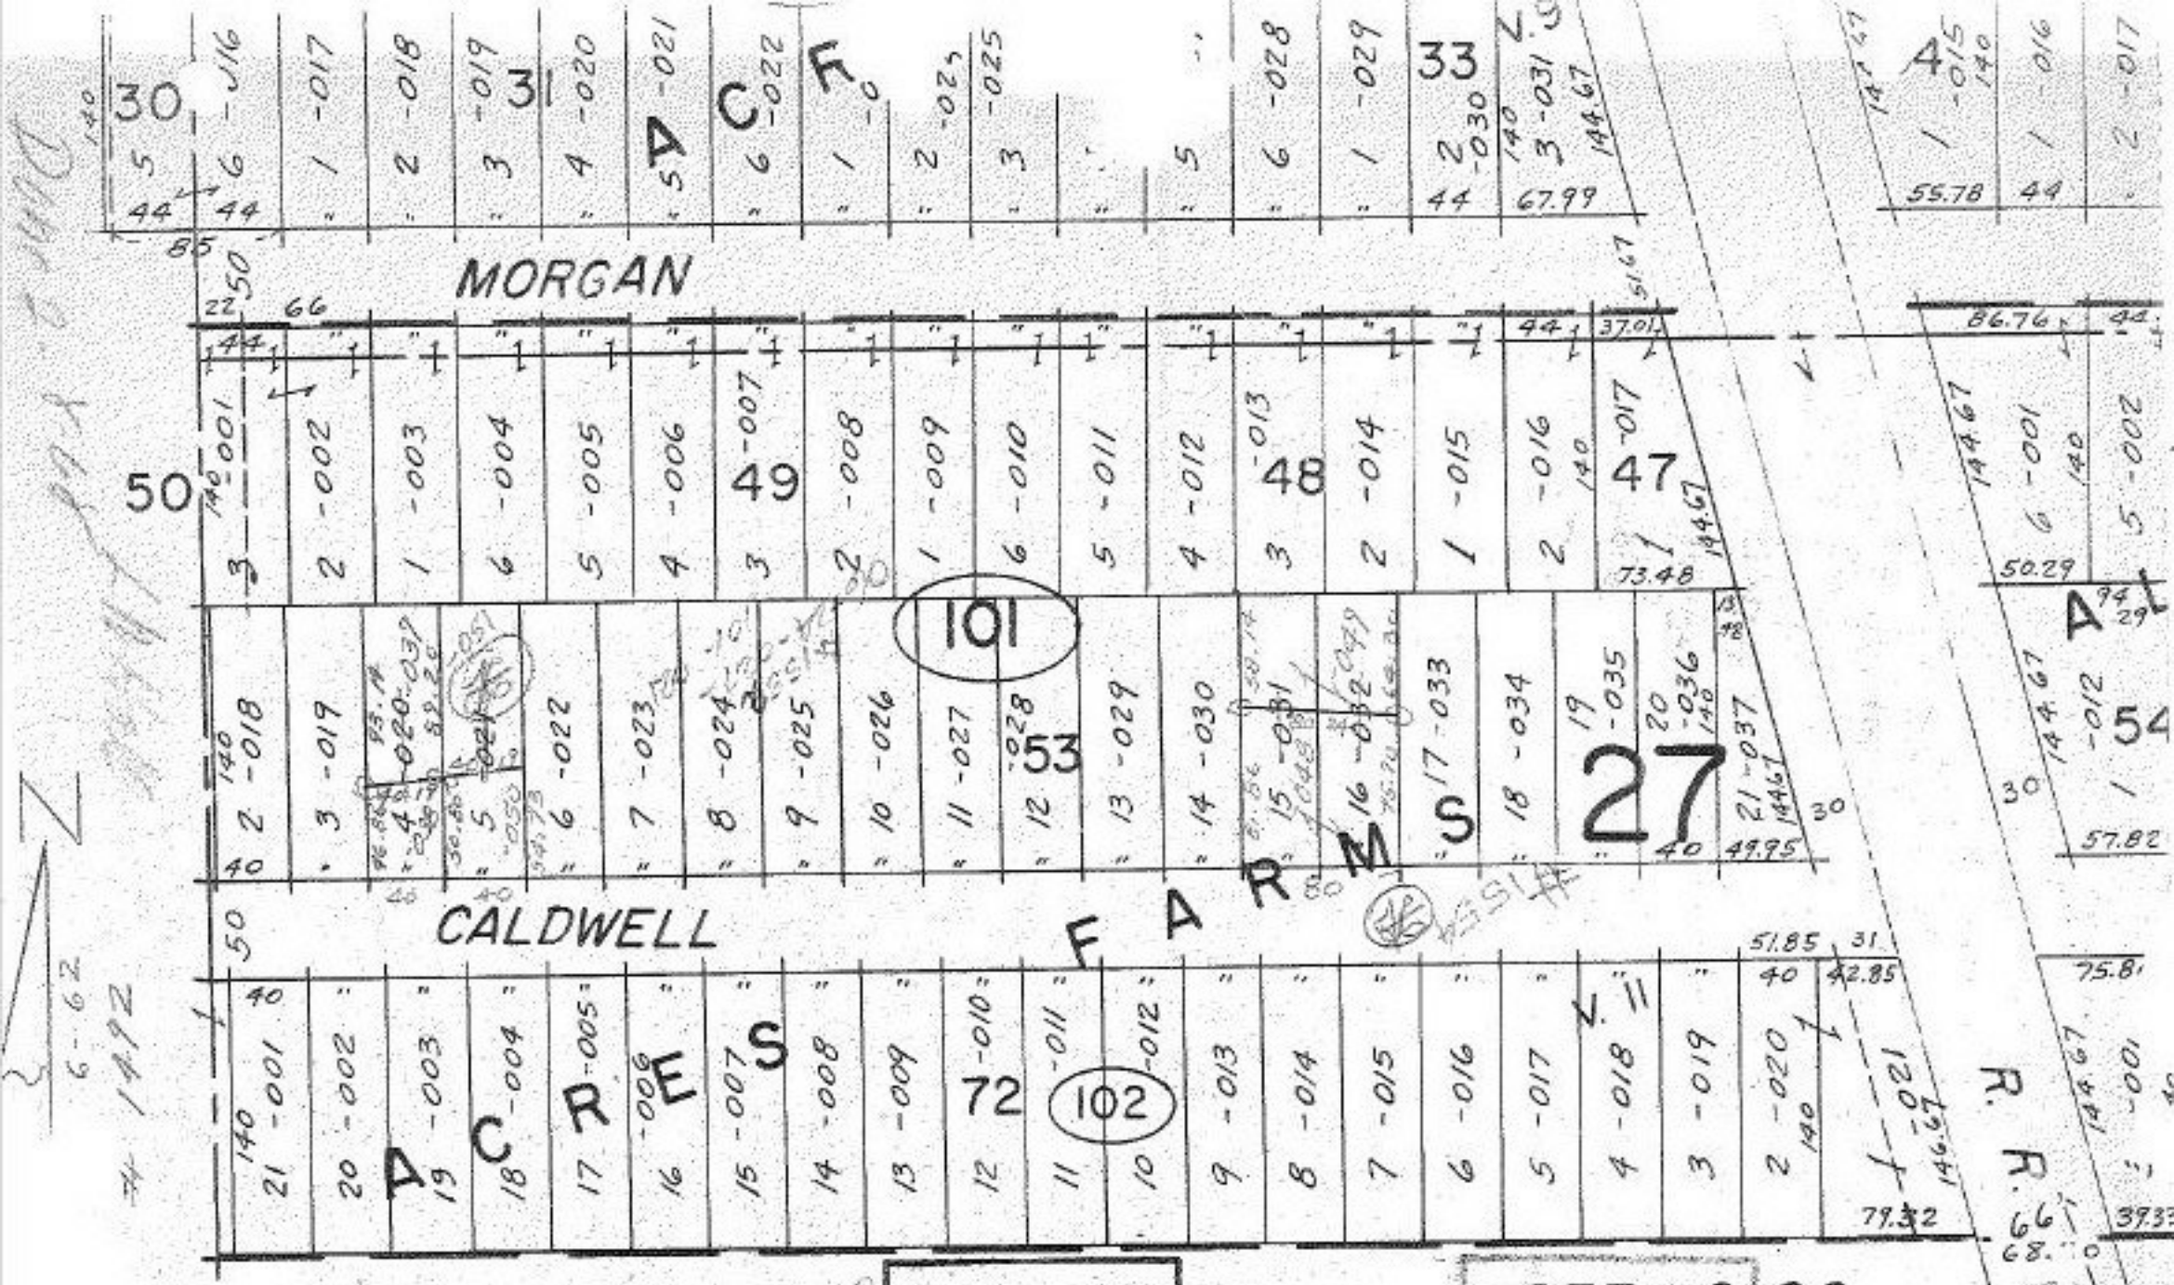

APPROVED
LORAIN CO.
MAP DEPT.
DATE 1-10-68
#1492
BY

APPROVED
LORAIN CO.
MAP DEPT.
DATE 2-17-68

ELYRIA
ALE 1" = 100'

WEST OF R
PT. LOTS 3