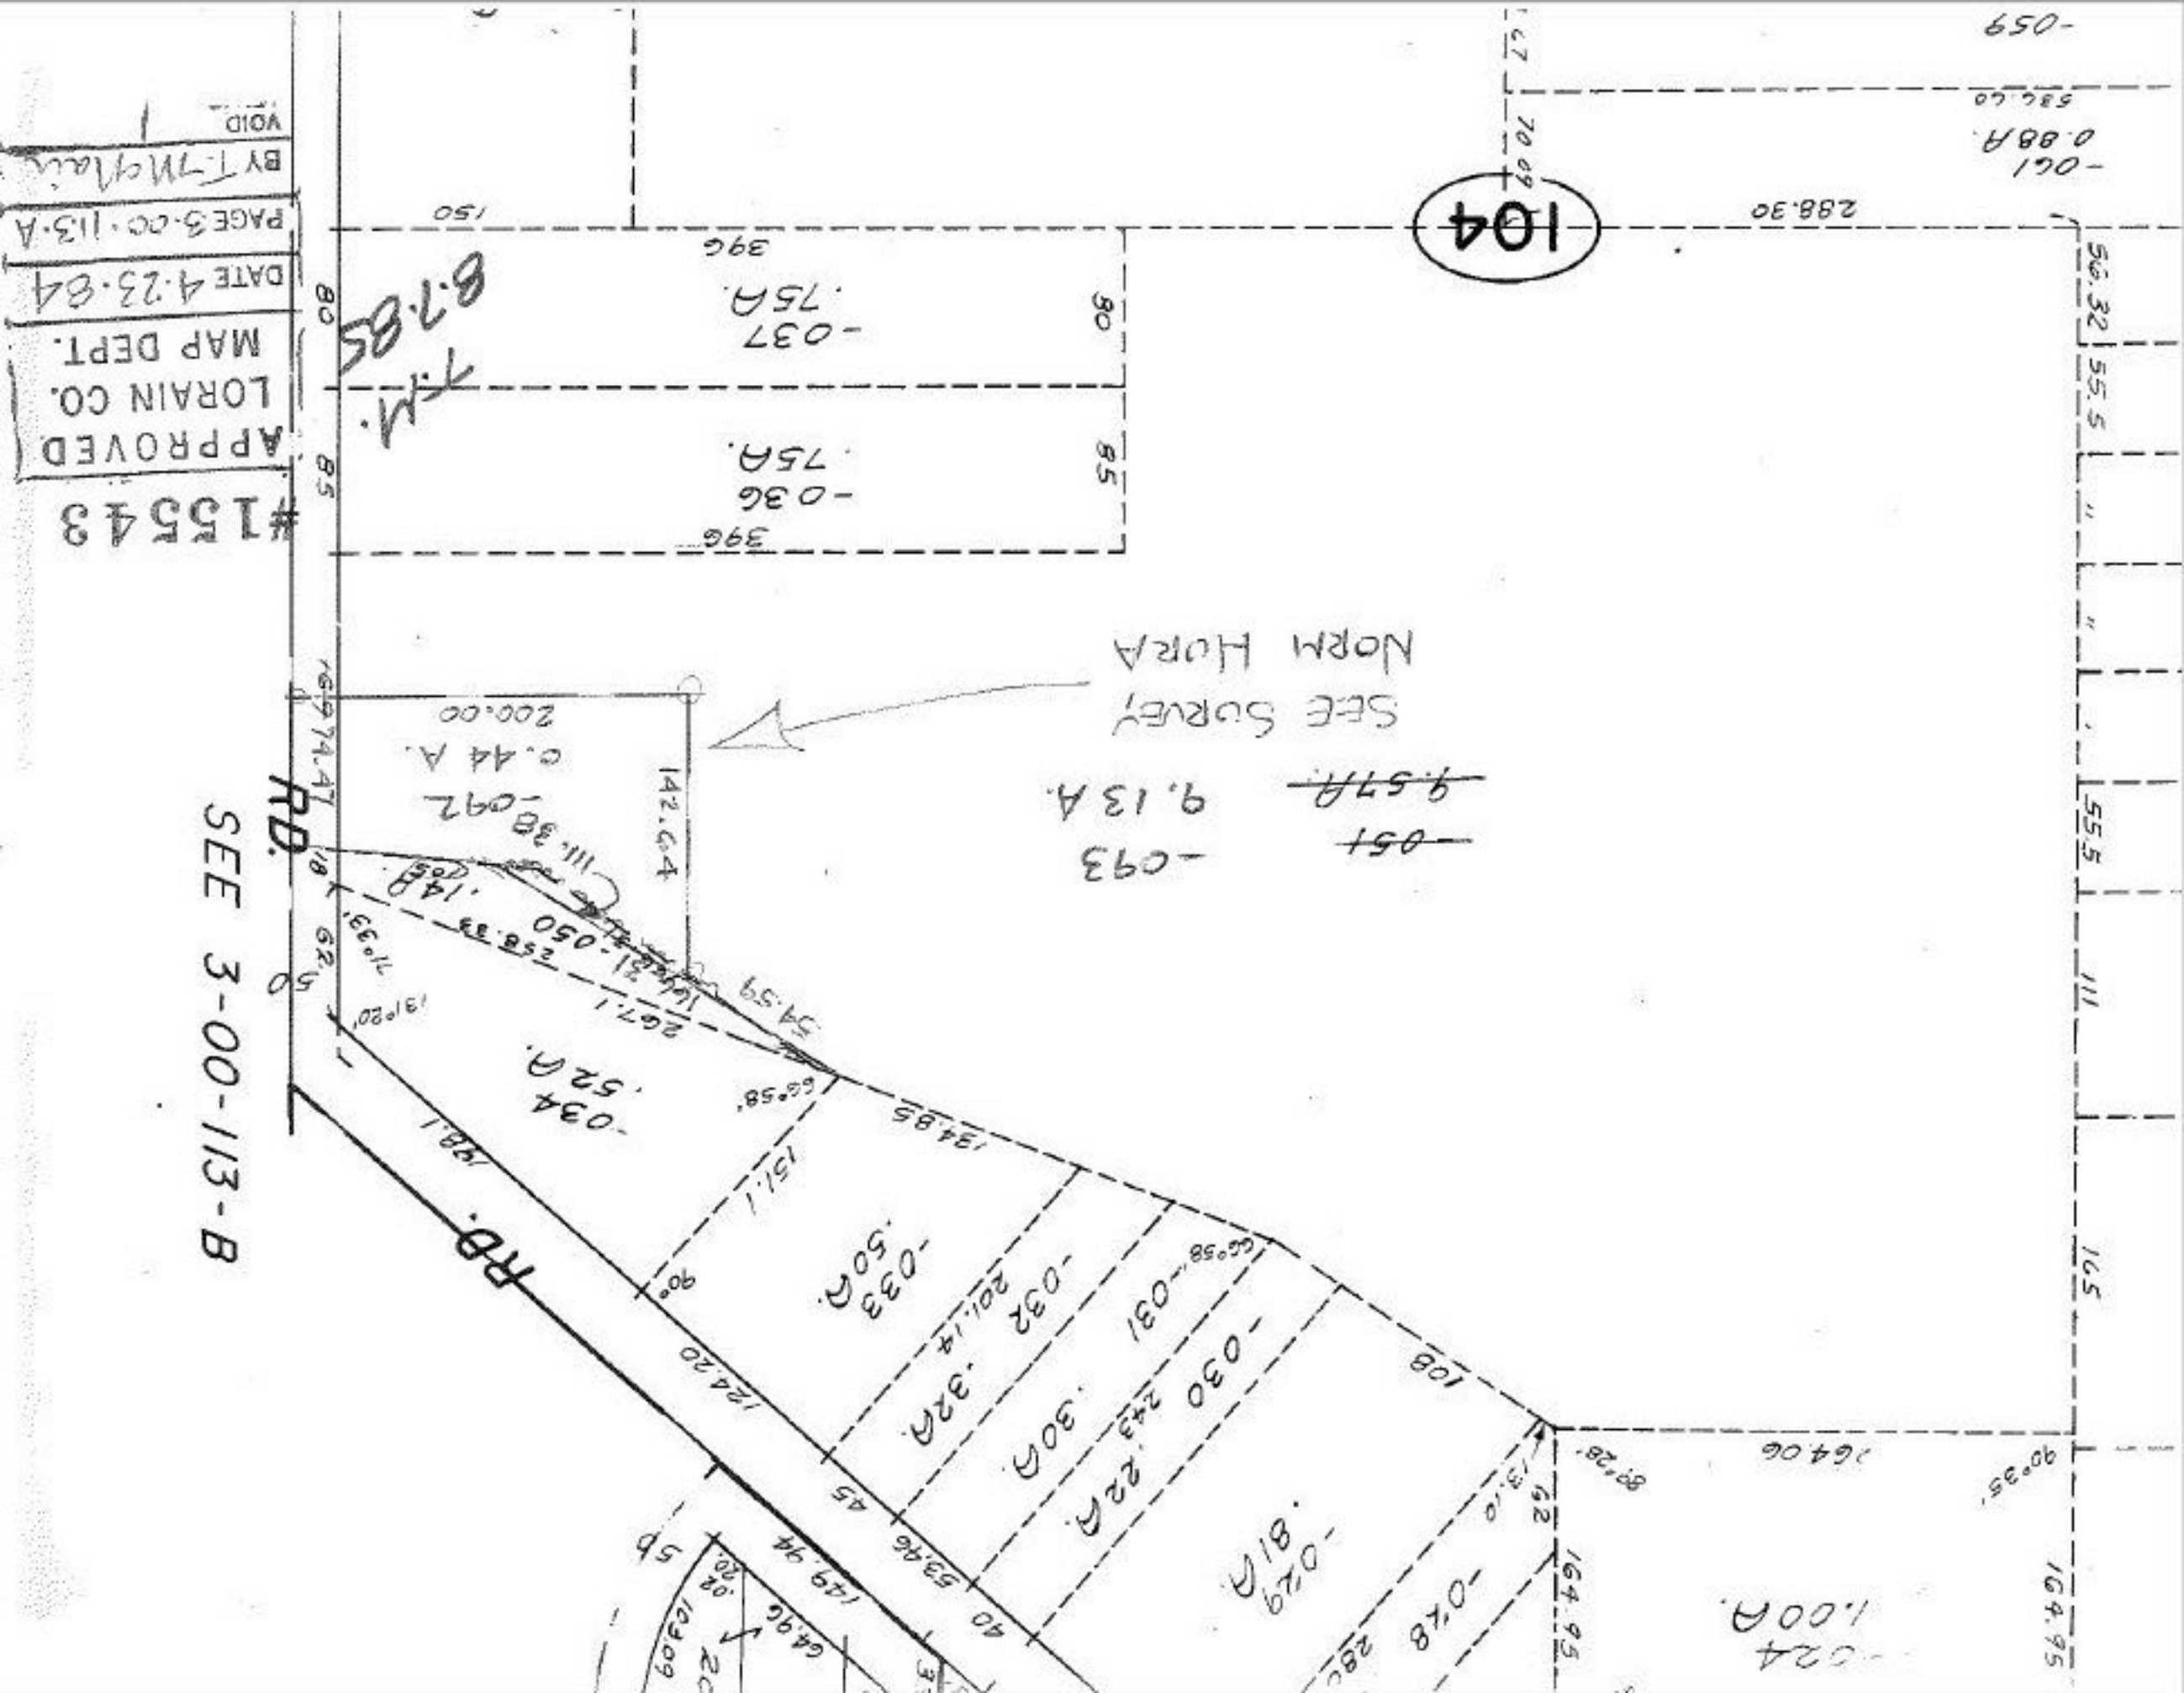

#15543
APPROVED
LORAIN CO.
MAP DEPT.
DATE 4.23.84
PAGE 3-00-113-A
BY T. McMain
VOID
T.M.
8.7.85
104
SEE SURVEY
NORM HORA
-093
9.13 A.
-051
9.57A.
-092
0.44 A.
200.00
-037
.75A.
-036
.75A.
-034
.52A.
-033
.50A.
-032
.32A.
-031
.30A.
-030
.22A.
-029
.81A.
-028
1.00A.
-059
-061
0.88A.
288.30
164.06
164.95
RD.
SEE 3-00-113-B