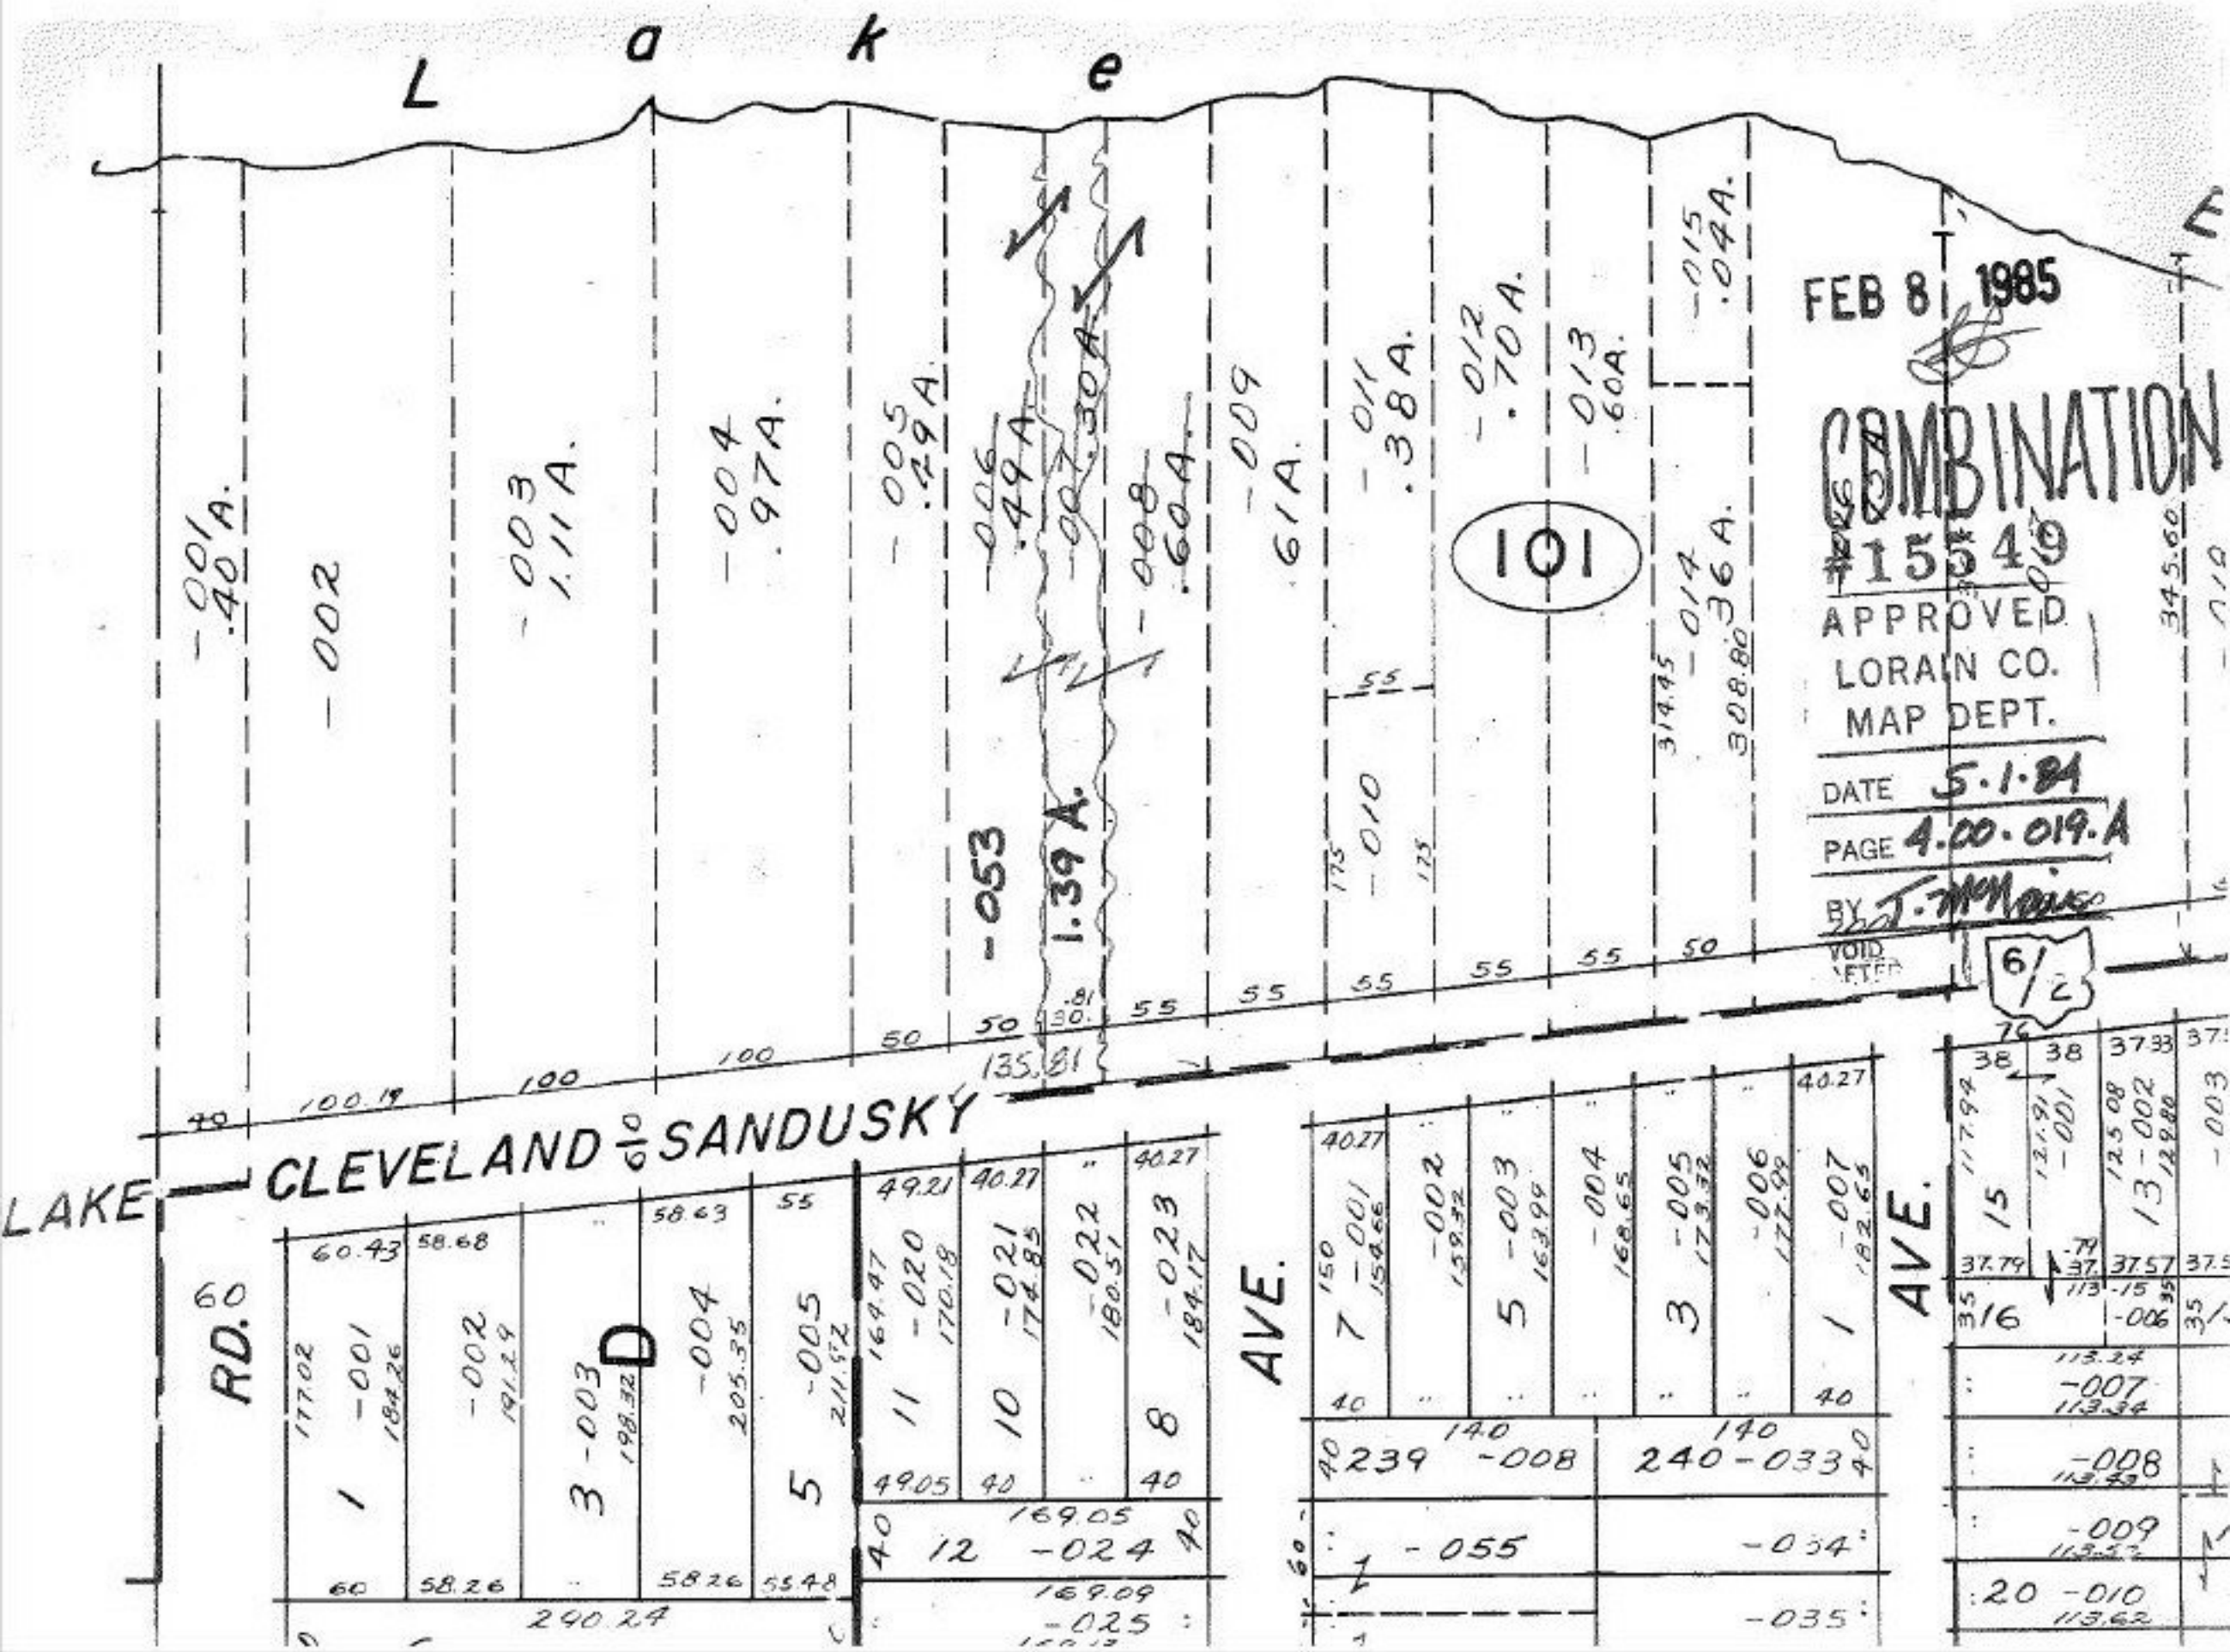

Lake
LAKE CLEVELAND SANDUSKY
RD.
AVE.
AVE.
101
FEB 8 1985
COMBINATION
#15549
APPROVED
LORAIN CO.
MAP DEPT.
DATE 5.1.84
PAGE 4.00.019.A
BY
VOID
6/2