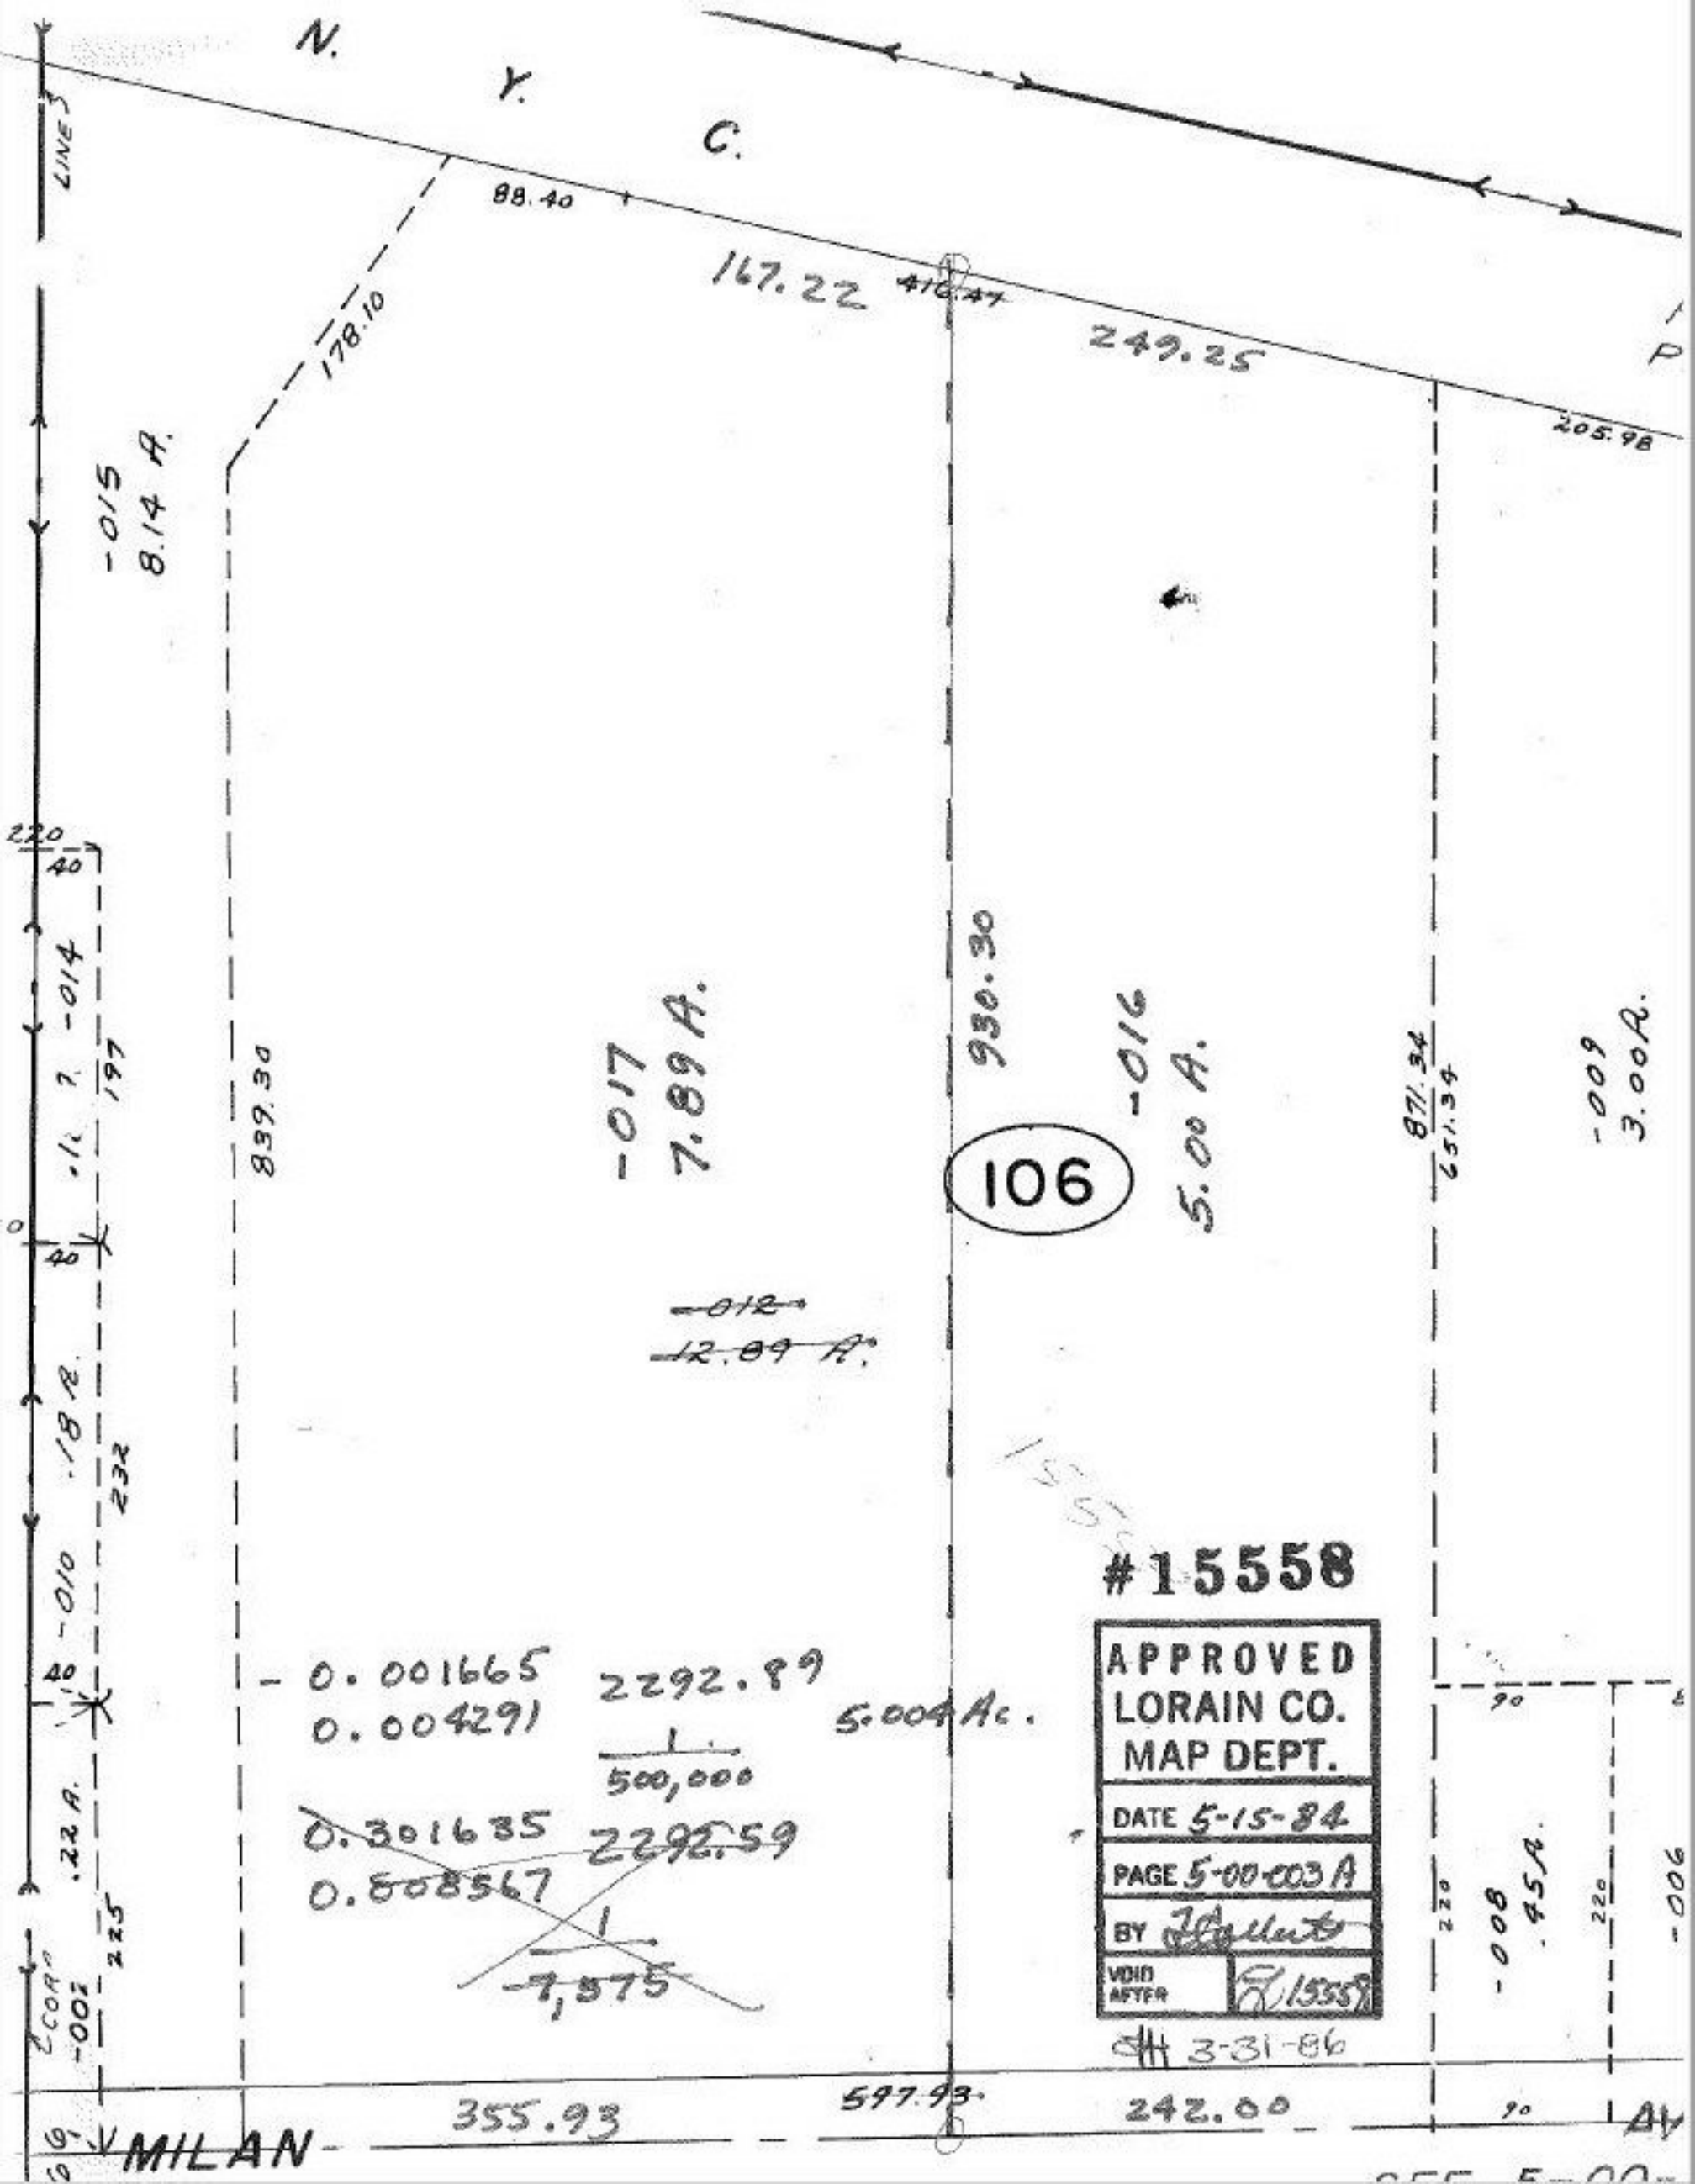

#15558

APPROVED
LORAIN CO.
MAP DEPT.
DATE 5-15-84
PAGE 5-00-003 A
BY [signature]
VOID AFTER [signature] 15559
3-31-86