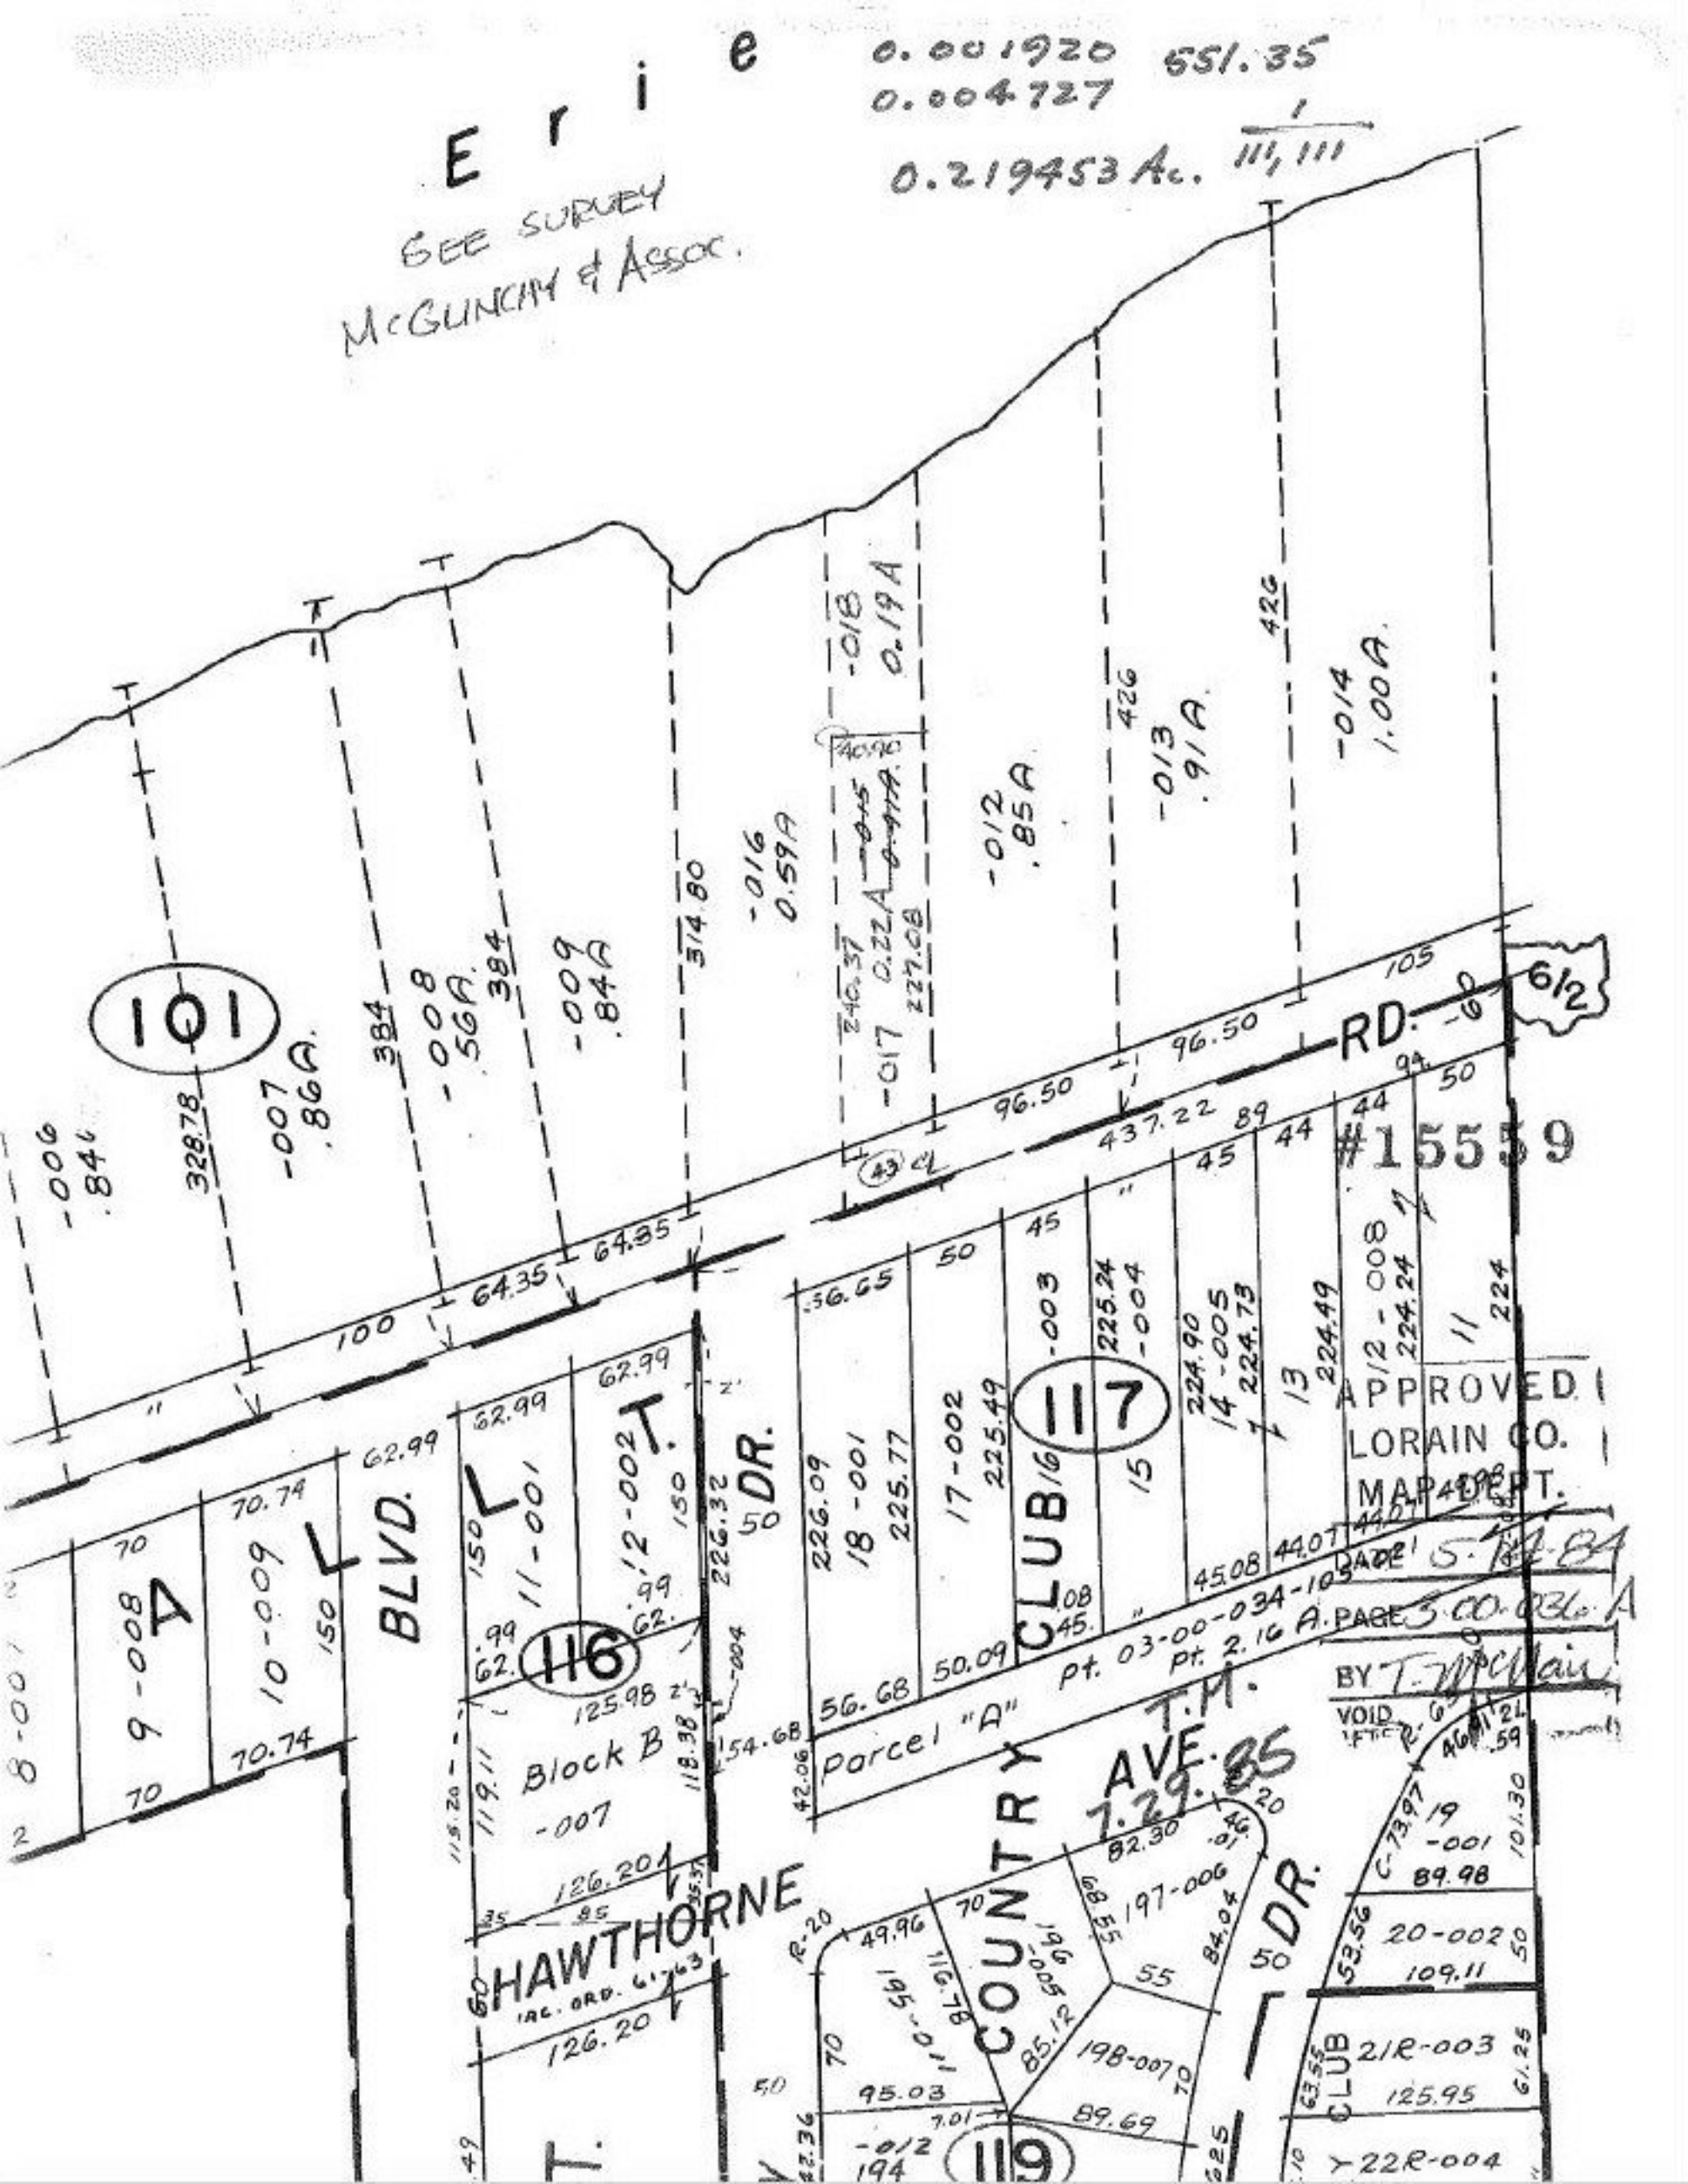

Erie
0.001920 551.35
0.004727
0.219453 Ac. 1/111,111
SEE SURVEY
McGLINCHY & ASSOC.
101
117
116
119
#15559
APPROVED
LORAIN CO.
MAP DEPT.
DATE 5-14-84
PAGE 3-00-036-A
BY T. McClain
VOID
RD.
6/2
BLVD.
DR.
COUNTRY
CLUB
AVE.
T.M.
HAWTHORNE
Block B
Parcel "A"
Pt. 03-00-034-105
Pt. 2.16 A.
7.29.85