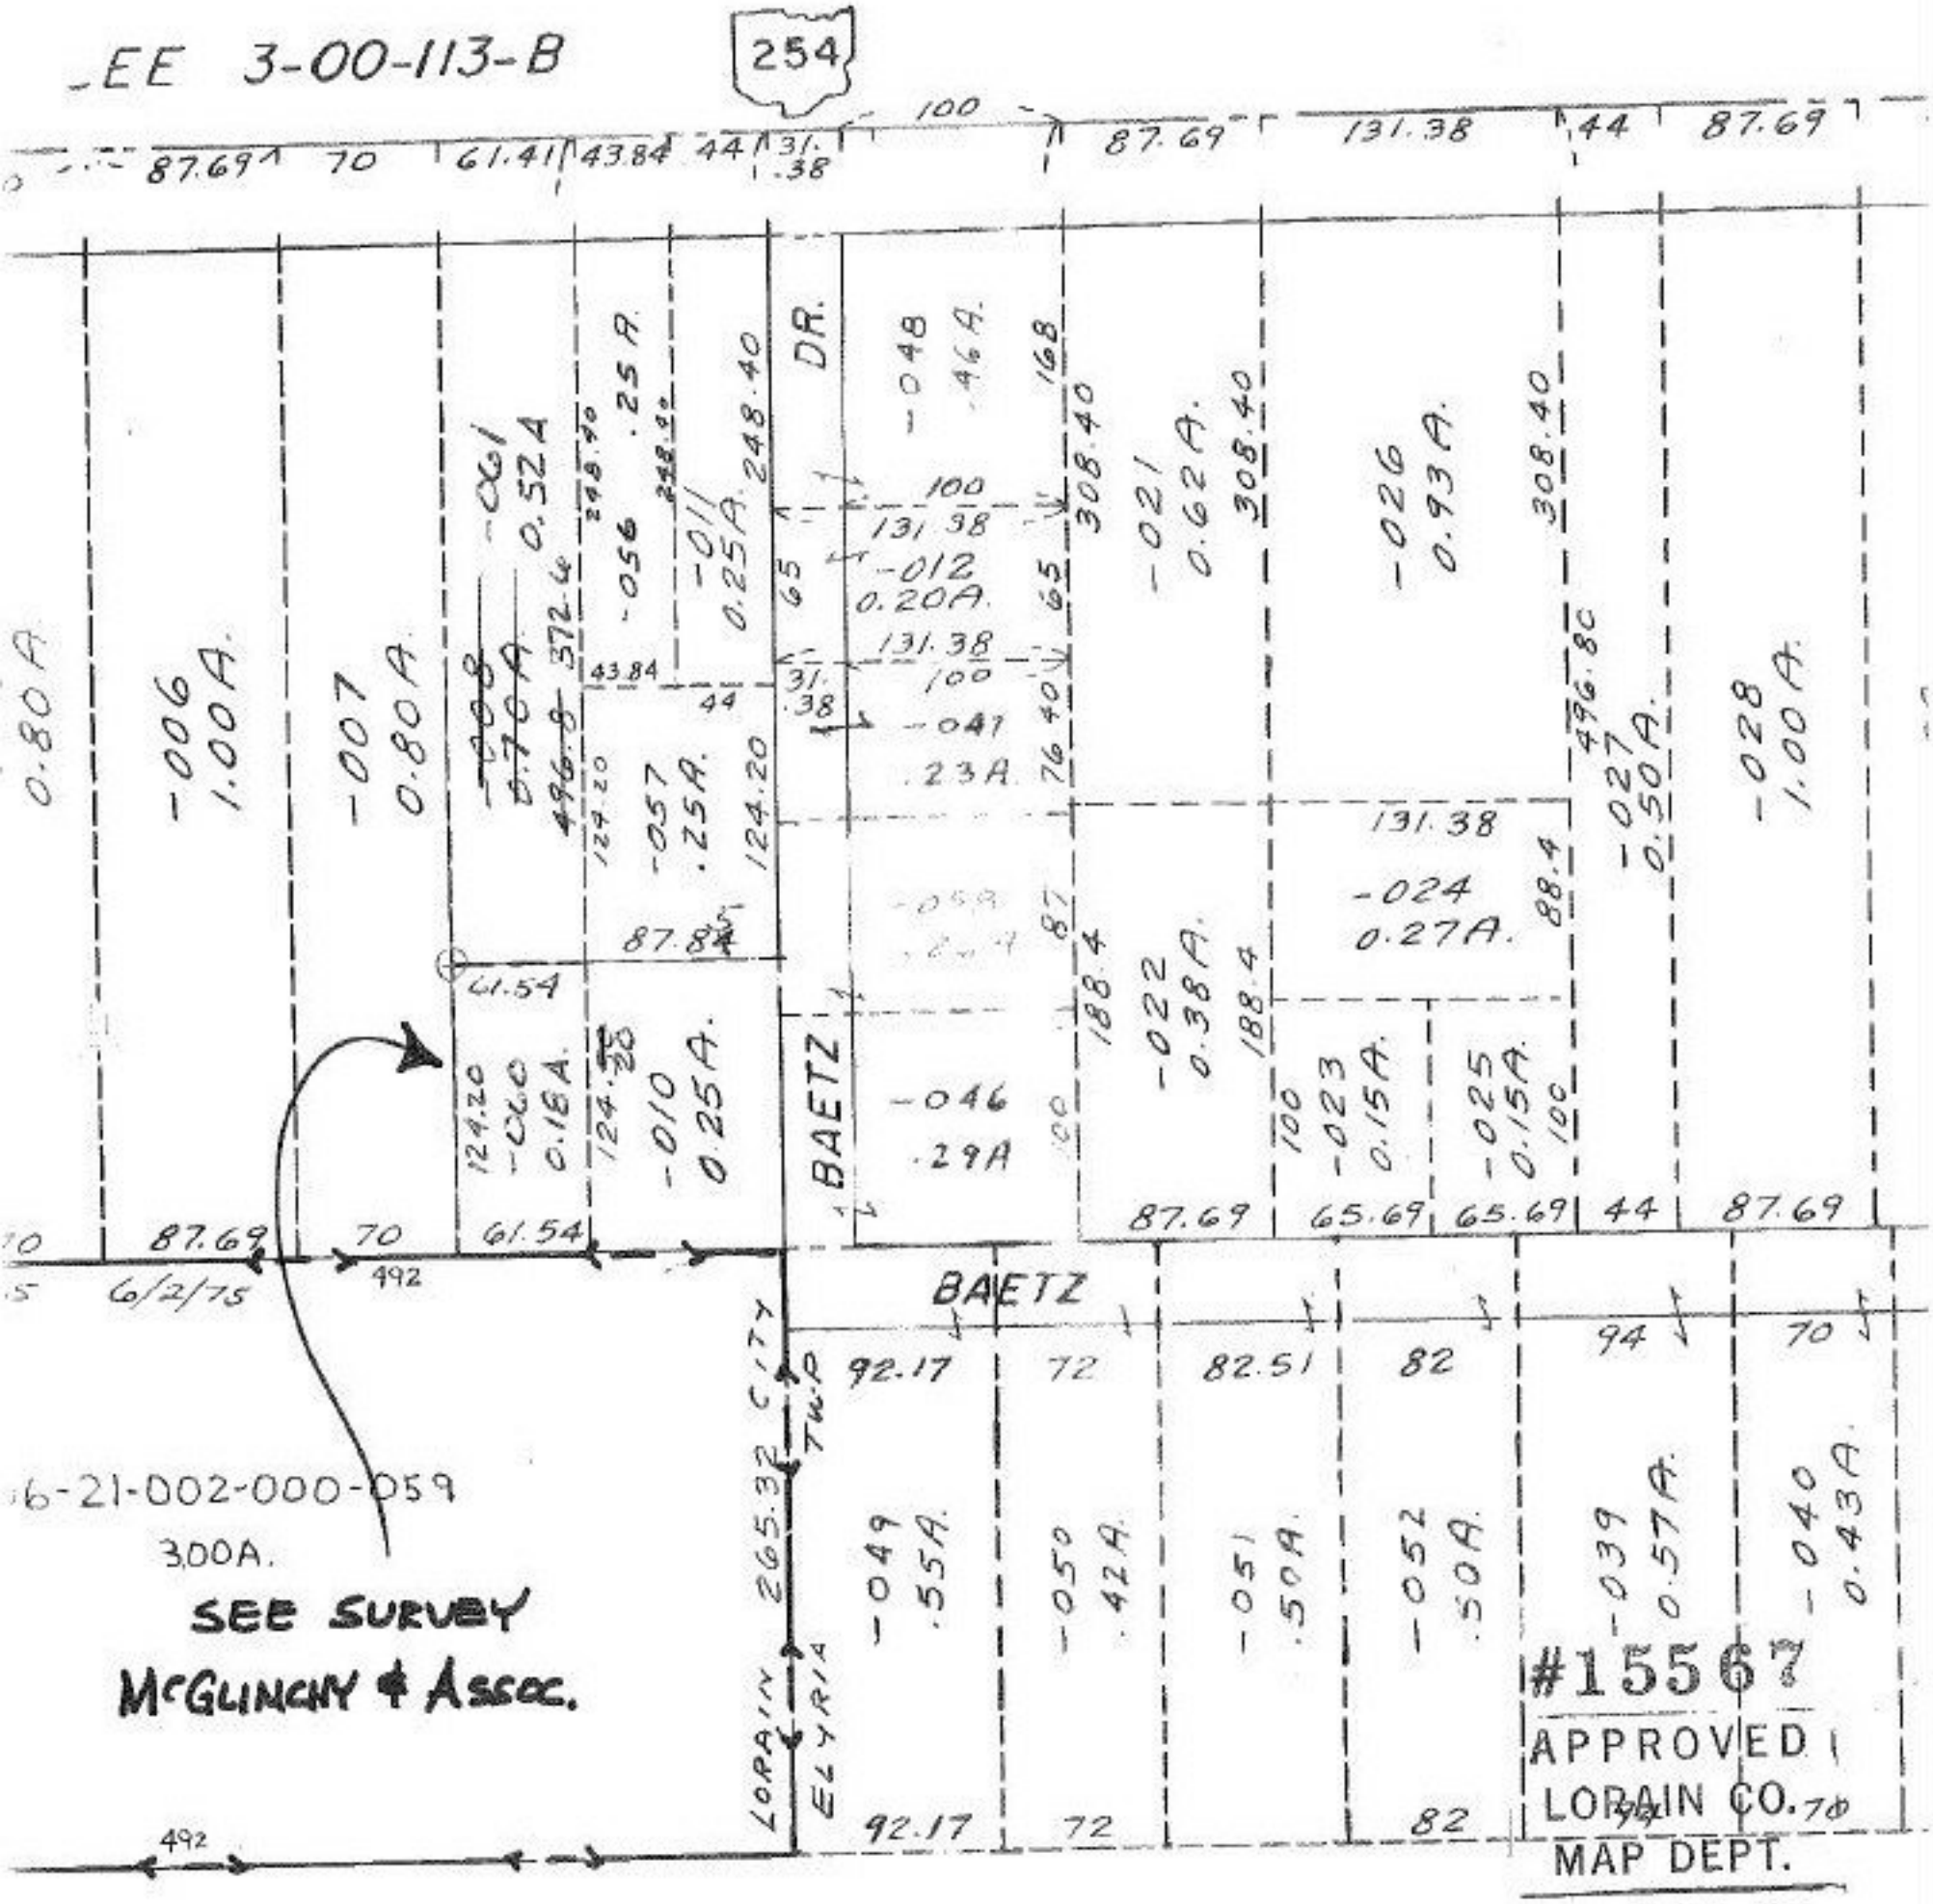

#15567
APPROVED
LORAIN CO.
MAP DEPT.
DATE 5.17.84
PAGE 6.2
BY T. McNair
VOID AFTER
9-10-85