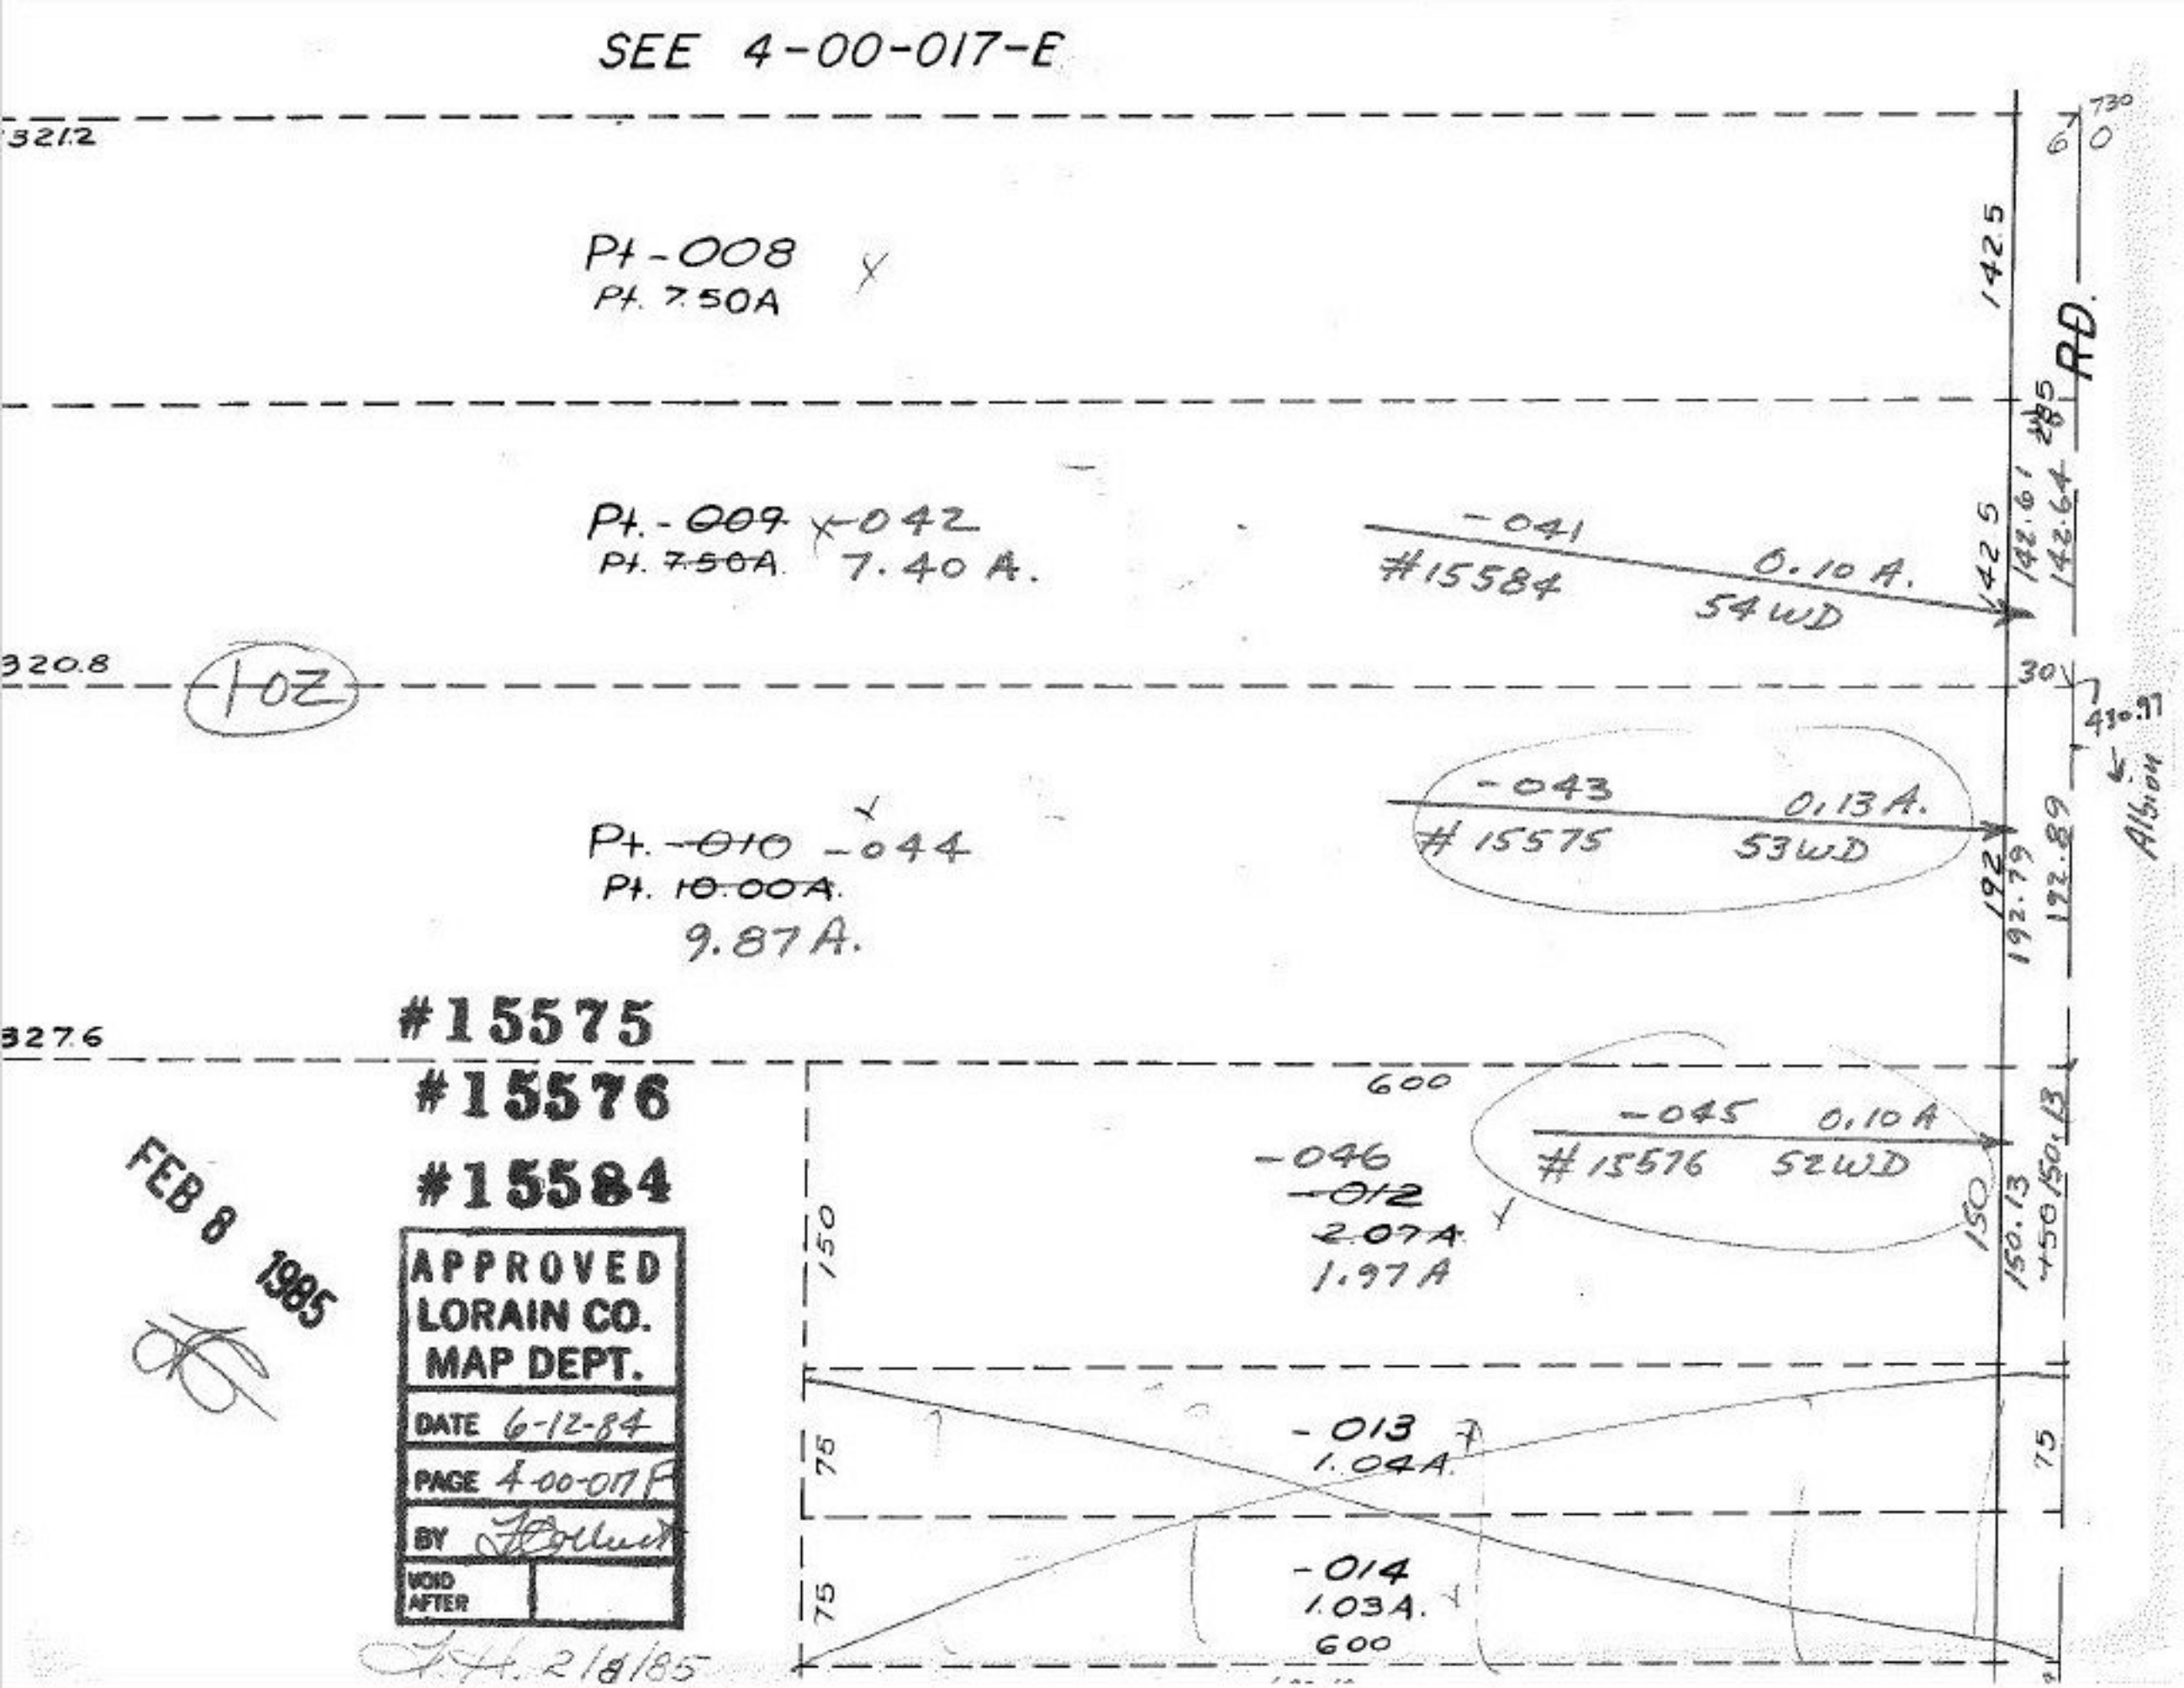
SEE 4-00-017-E
321.2
Pt-008
Pt. 7.50A
Pt.-~~009~~ -042
Pt. ~~7.50A~~ 7.40 A.
-041
#15584
0.10 A.
54 WD
320.8
1 OZ
-043
0.13 A.
#15575
53 WD
Pt. ~~-010~~ -044
Pt. ~~10.00A~~
9.87 A.
327.6
#15575
#15576
#15584
600
-045
0.10 A
#15576
52 WD
-046
~~-012~~
~~2.07A~~
1.97 A
150
-013
1.04A.
75
-014
1.03A.
600
RD.
Albion
FEB 8 1985
APPROVED
LORAIN CO.
MAP DEPT.
DATE 6-12-84
PAGE 4-00-017F
BY
VOID AFTER
2/8/85