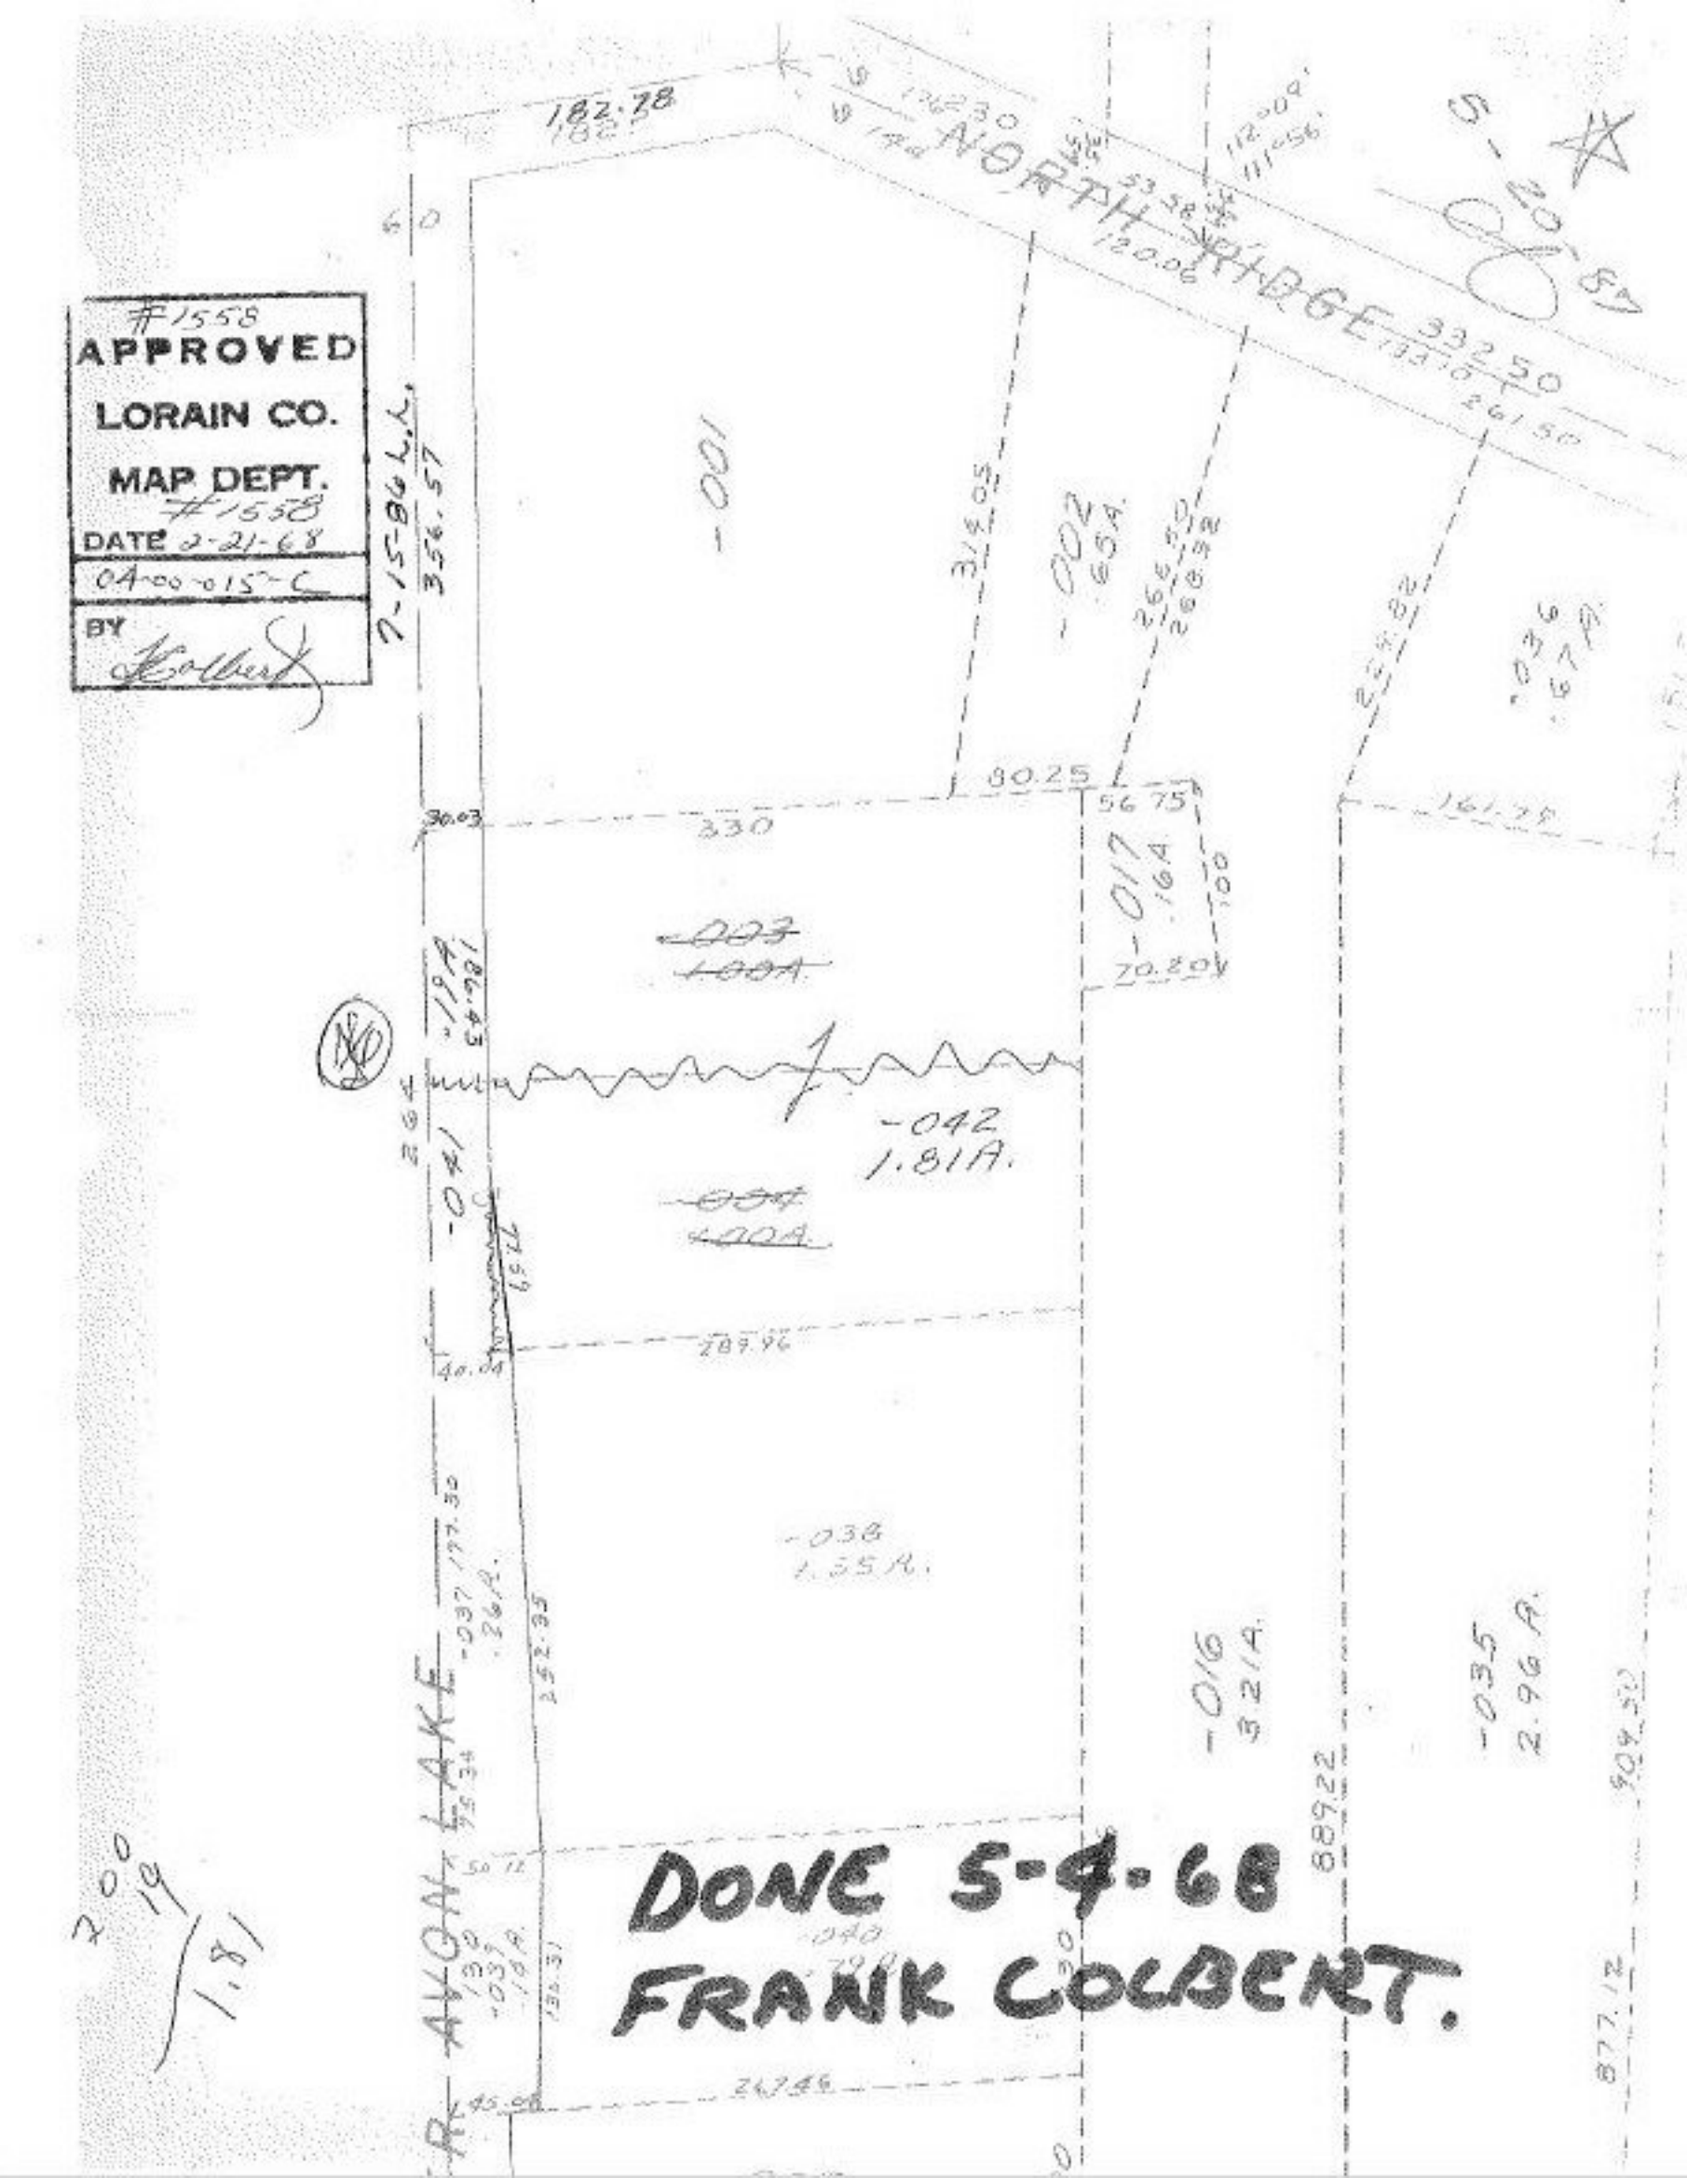
#1558
APPROVED
LORAIN CO.
MAP DEPT.
#1558
DATE 2-21-68
04-00-015-C
BY
Colbert
NORTH RIDGE
182.78
-001
-002
.65A.
-017
1.64
-042
1.81A.
-038
1.55A.
-016
3.21A.
-035
2.96A.
AVON LAKE
DONE 5-4-68
FRANK COLBERT.