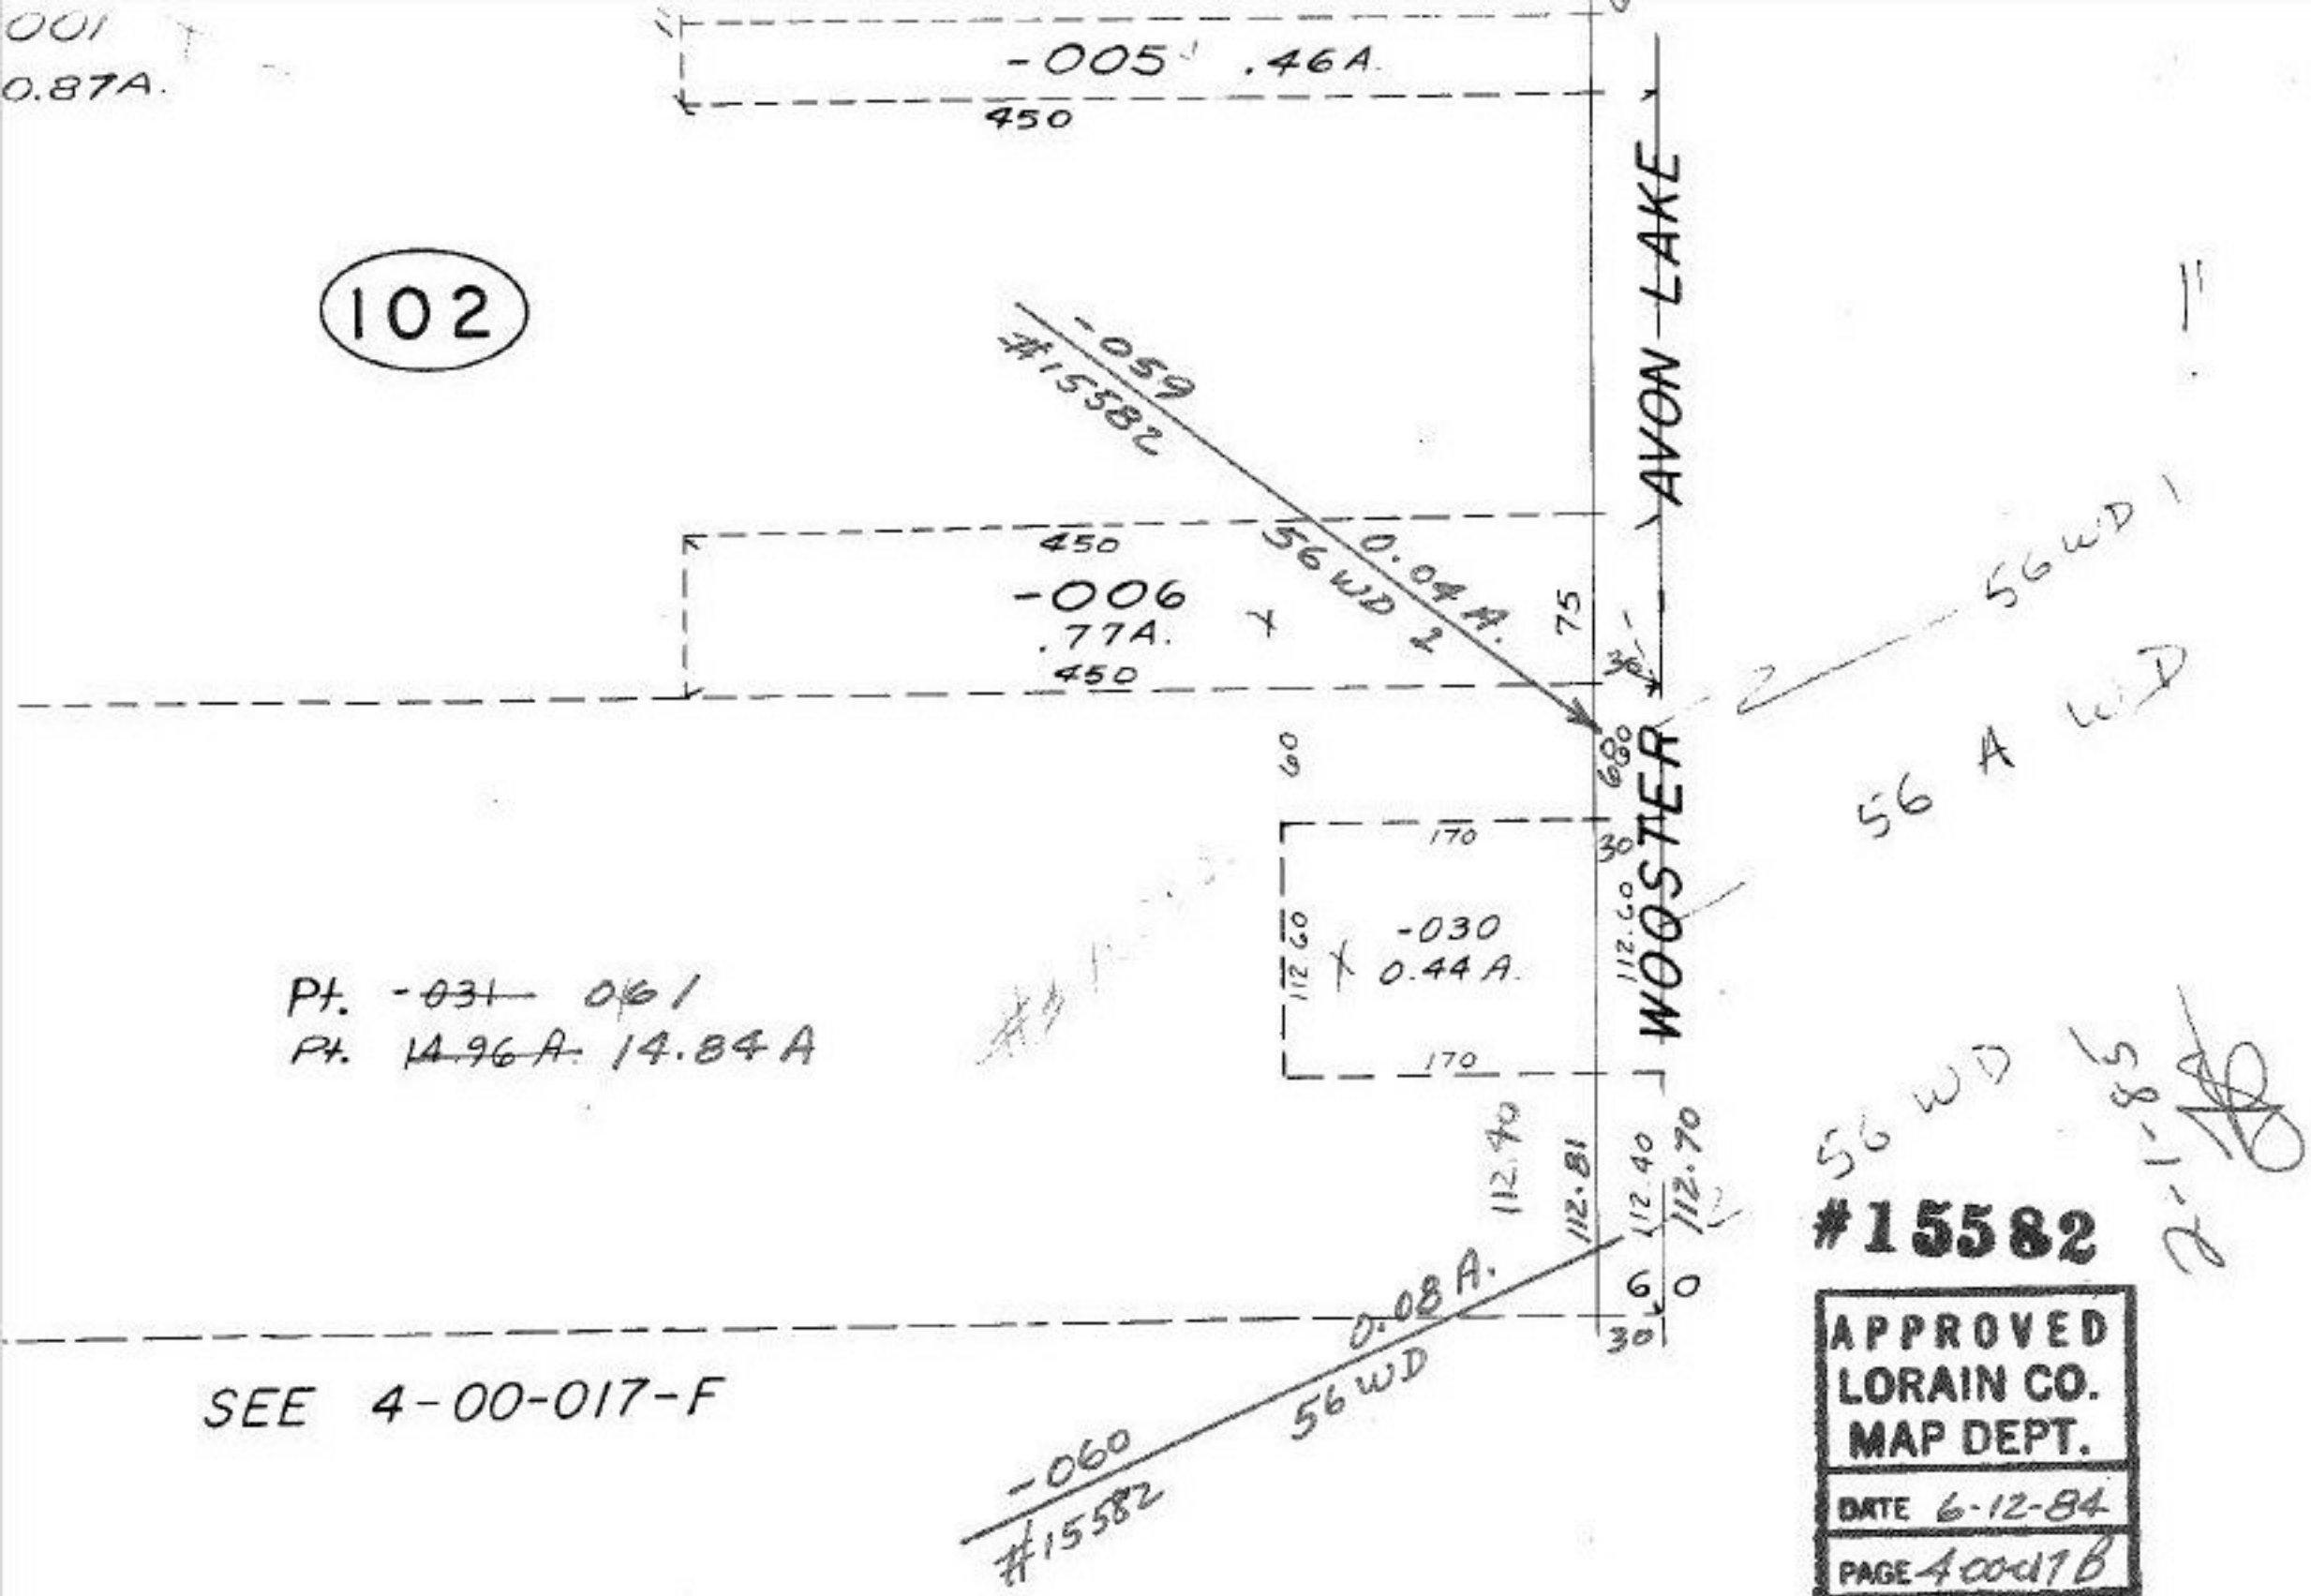

001
0.87A.
-005 .46A.
450
102
-059
#15582
AVON LAKE
450
-006
.77A.
450
56 WD 2
0.04 A.
75
56 WD 1
56 A WD
60
170
-030
0.44 A.
112.60
112.60
WOOSTER
Pt. -031 061
Pt. 14.96 A. 14.84 A
170
112.40
112.81
112.40
112.70
56 WD
2-1-85
#15582
0.08 A.
56 WD
-060
#15582
SEE 4-00-017-F
APPROVED
LORAIN CO.
MAP DEPT.
DATE 6-12-84
PAGE 4-00-017 B
BY
VOID AFTER 15582