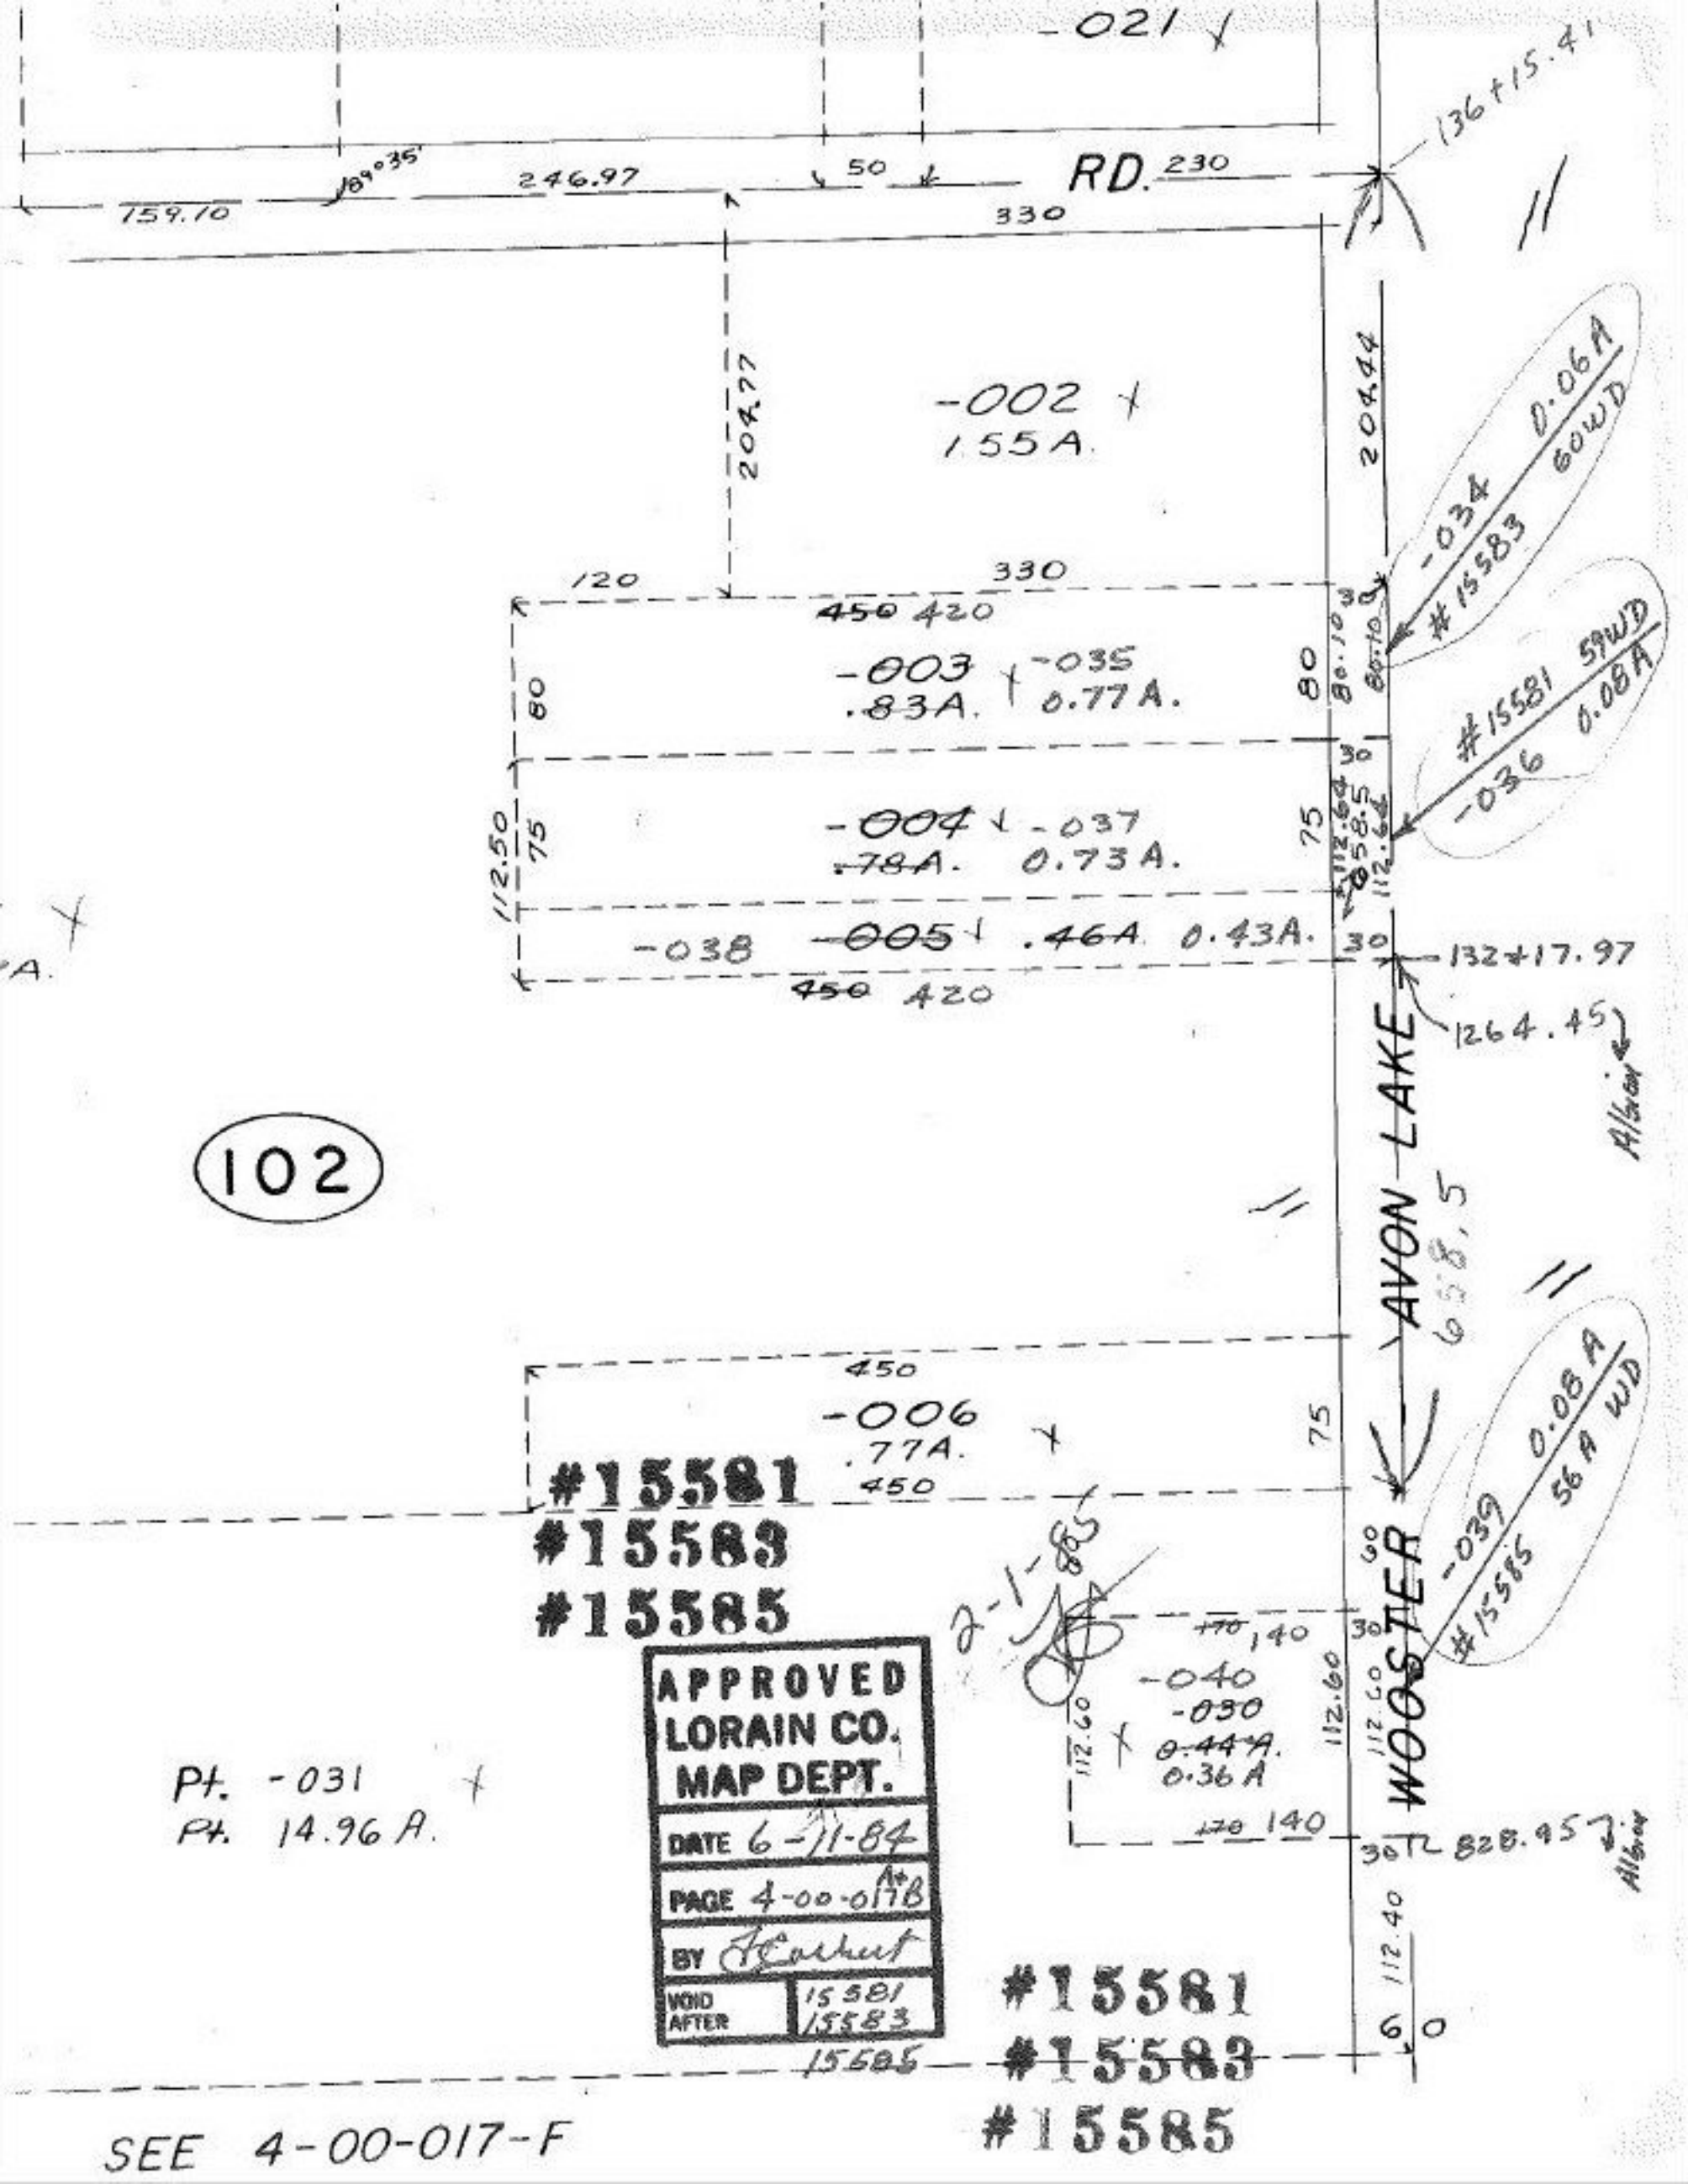

APPROVED
LORAIN CO.
MAP DEPT.
DATE 6-11-84
PAGE 4-00-017B
BY [signature]
VOID AFTER 15581 15583

SEE 4-00-017-F