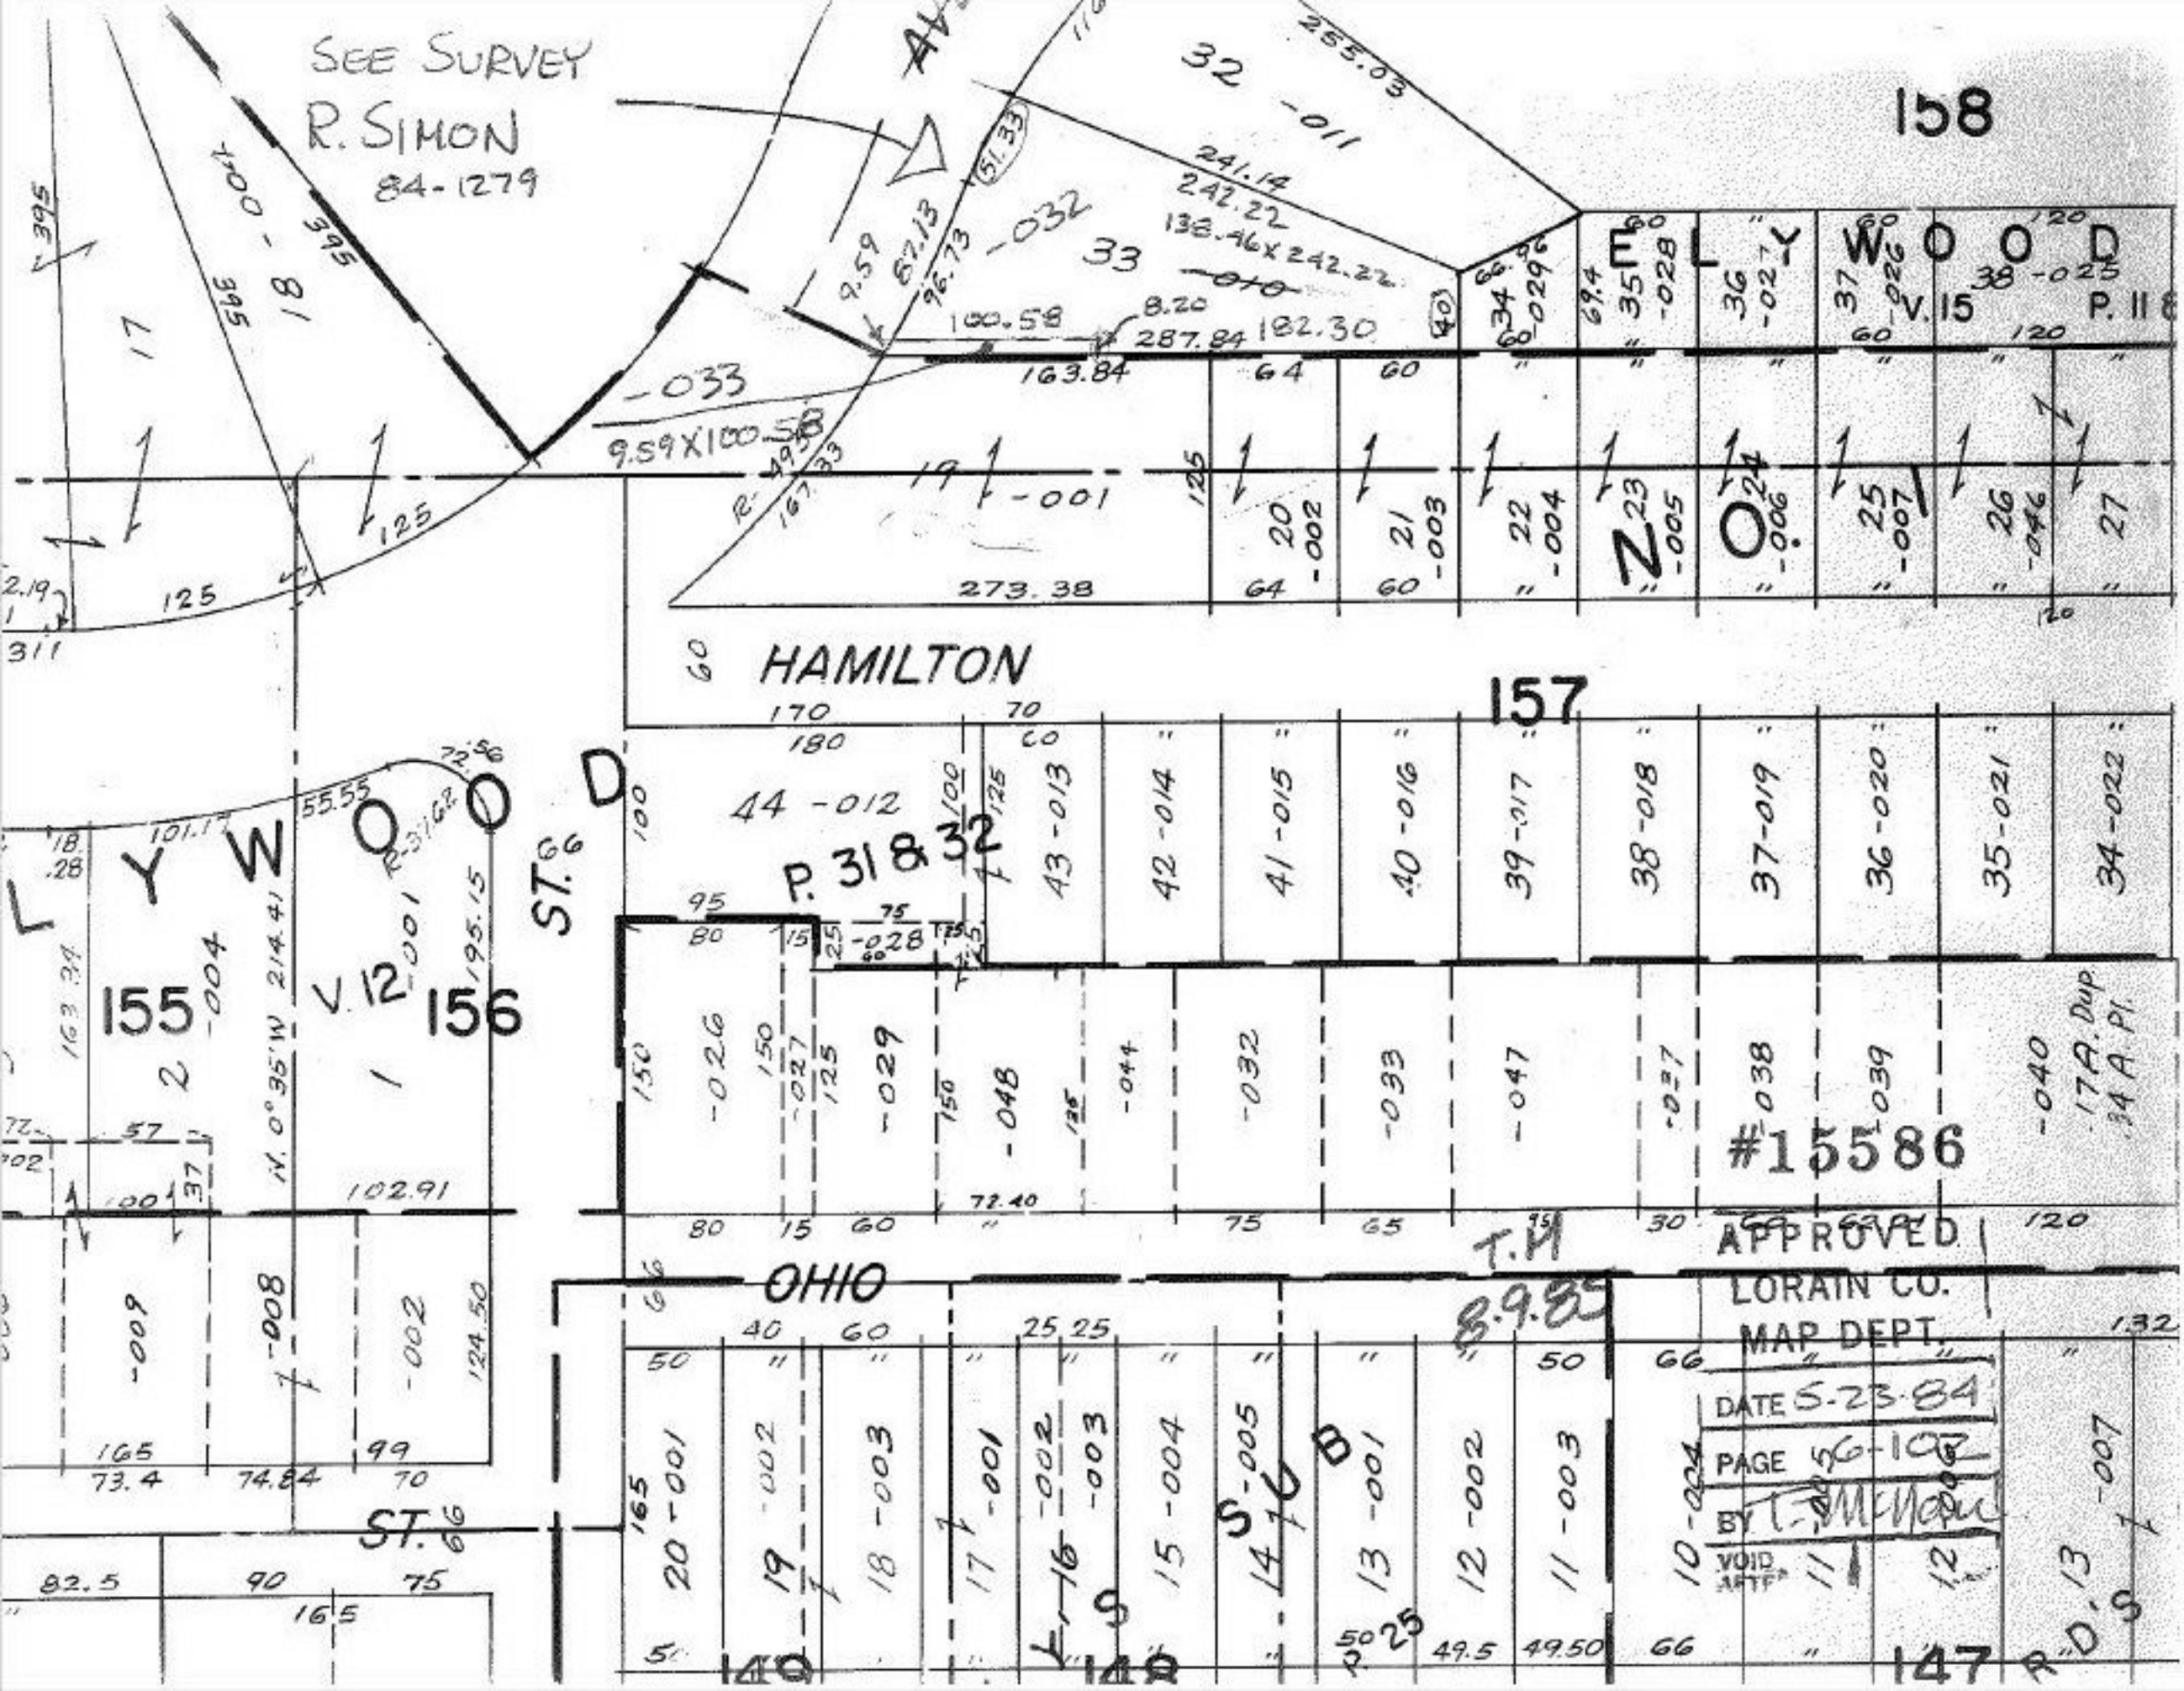
SEE SURVEY
R. SIMON
84-1279
158
ELYWOOD
V. 15
P. 11 &
HAMILTON
157
ZOO
LYWOOD
155
V. 12
156
ST. 66
P. 31 & 32
#15586
OHIO
ST. 66
SUB
149
148
147
APPROVED
LORAIN CO.
MAP DEPT.
DATE 5-23-84
PAGE 6-102
BY
VOID AFTER