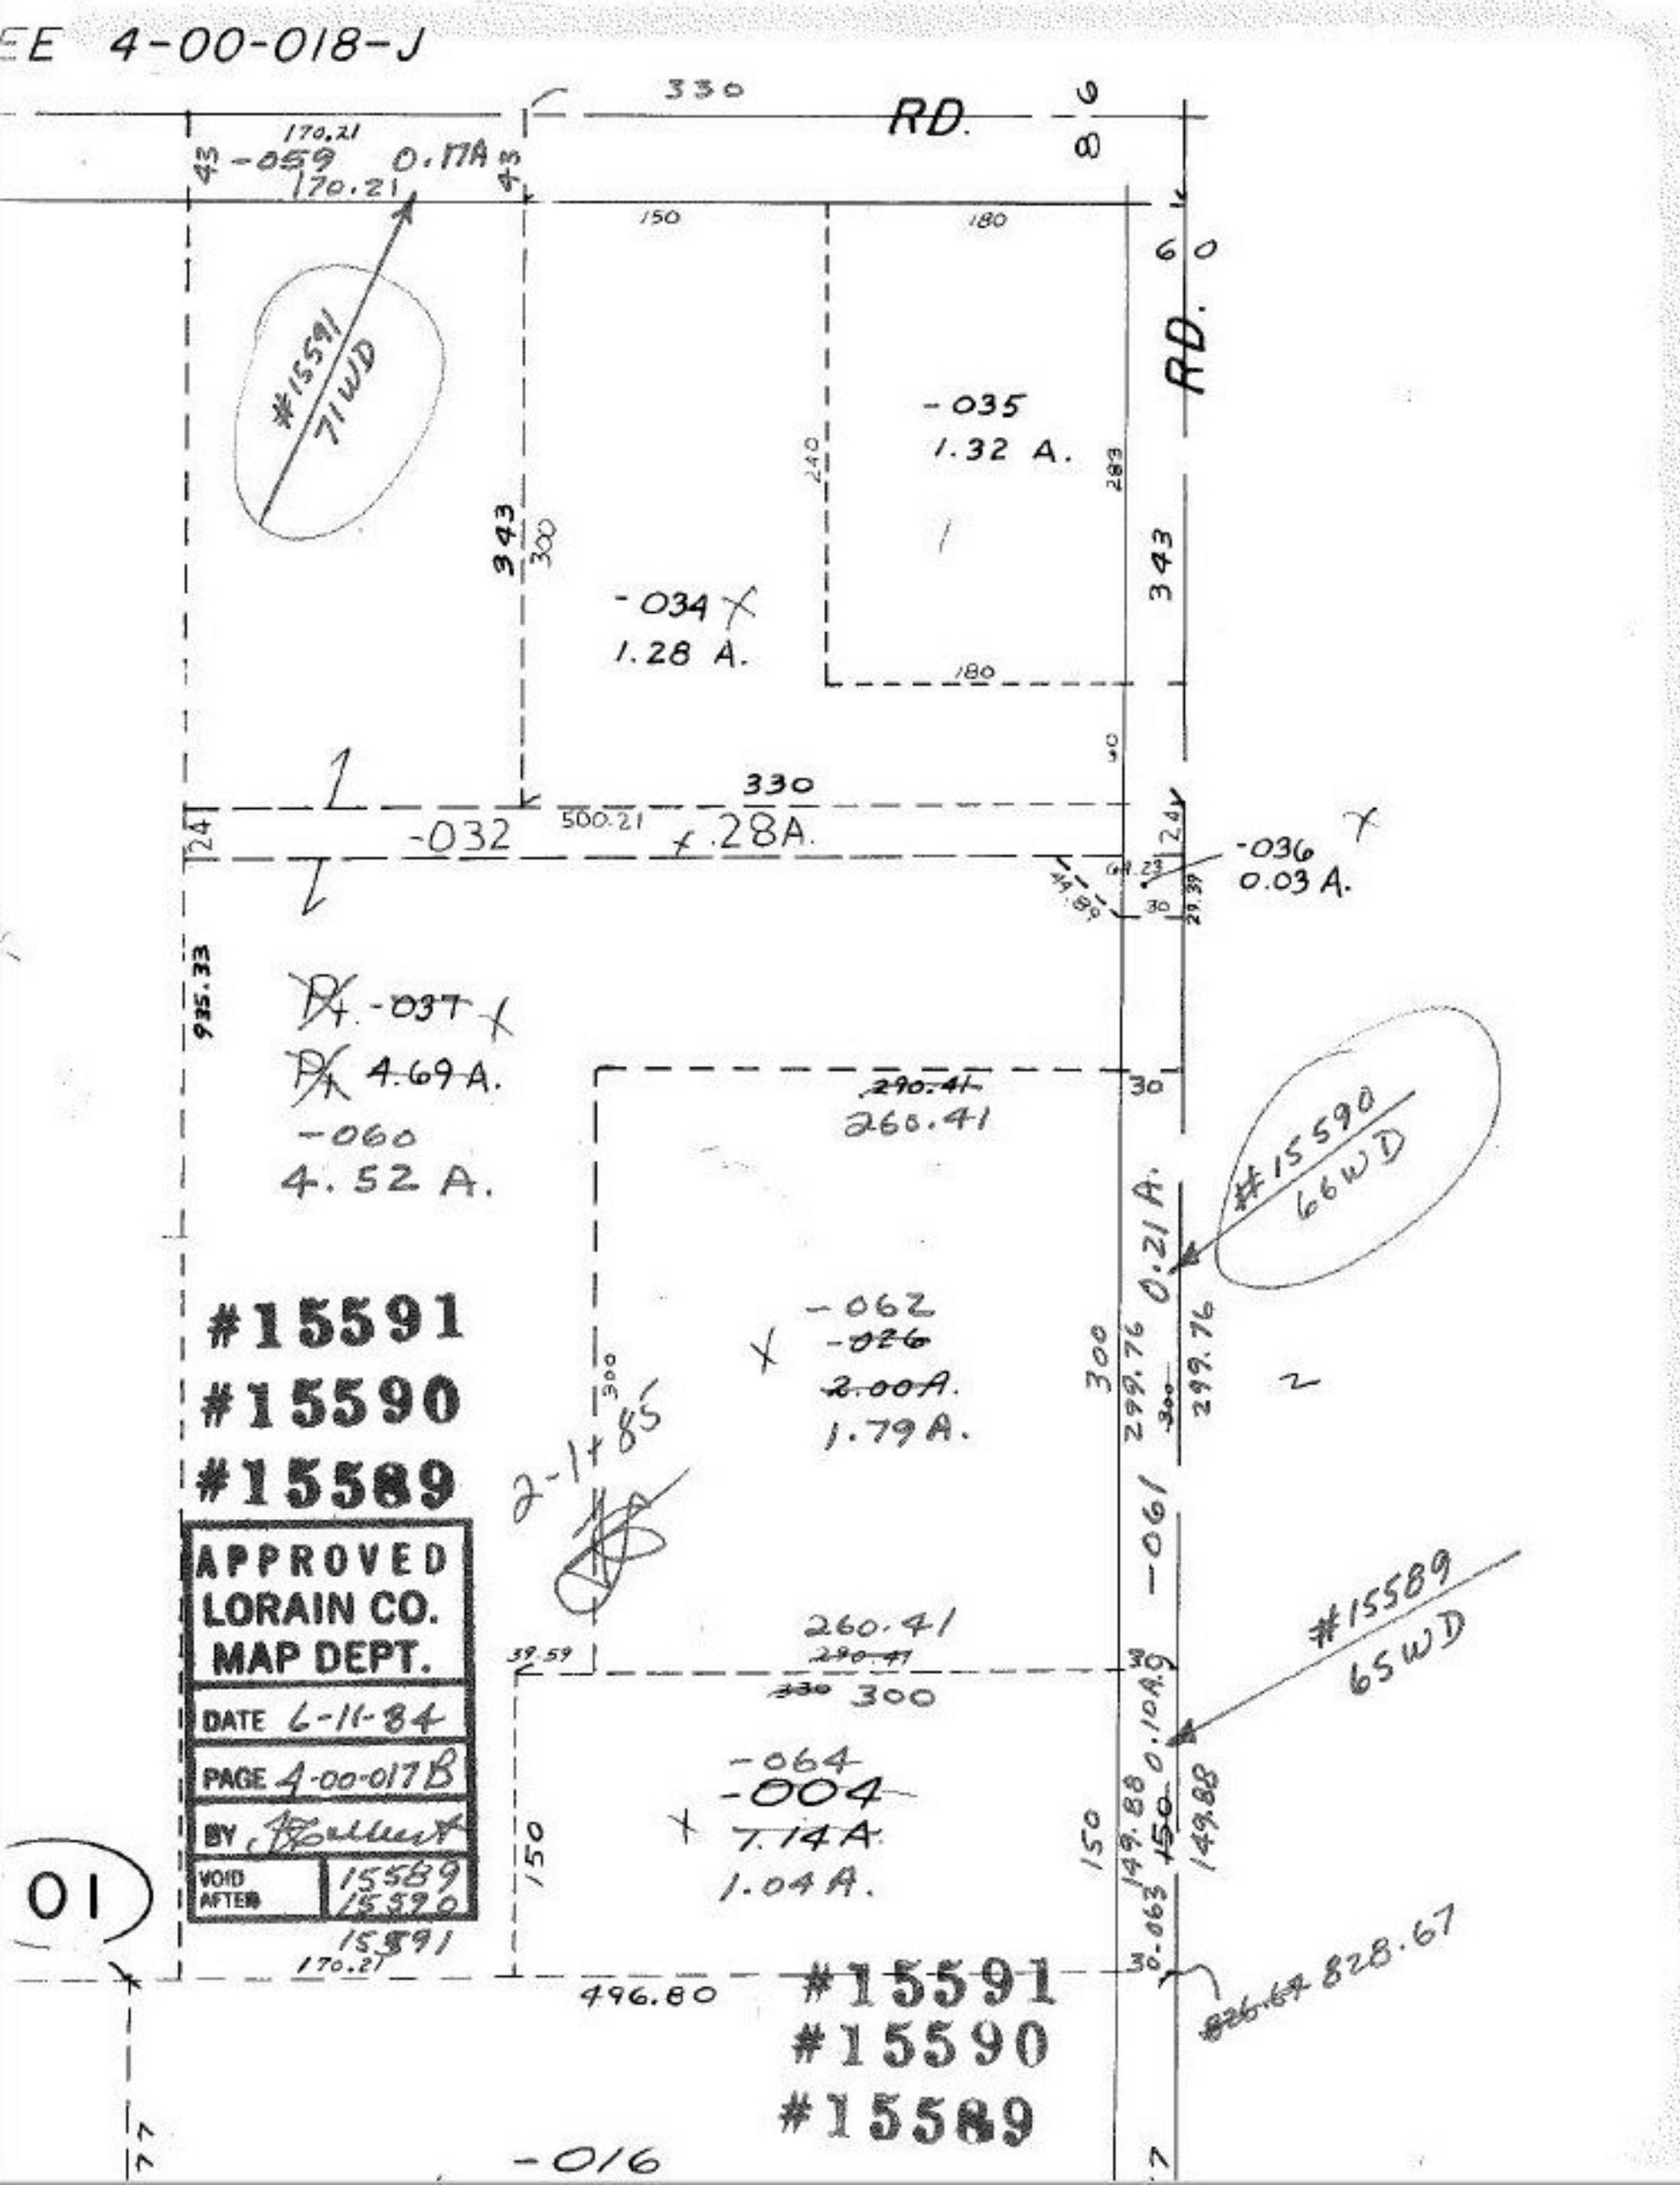

EE 4-00-018-J
330
RD.
170.21
-059
0.17A
170.21
150
180
#15591
71WD
-035
1.32 A.
343
300
-034
1.28 A.
180
330
-032
500.21
.28A.
-036
0.03 A.
935.33
-037
4.69 A.
-060
4.52 A.
290.41
260.41
#15590
66WD
0.21 A.
#15591
#15590
#15589
-062
-026
2.00A.
1.79A.
299.76
299.76
2-1+85
-061
APPROVED
LORAIN CO.
MAP DEPT.
DATE 6-11-84
PAGE 4-00-017B
BY
VOID AFTER 15589 15590
15591
260.41
290.41
300
#15589
65WD
0.10A.
-064
-004
7.14A.
1.04A.
149.88
149.88
150
150
01
170.21
496.80
#15591
#15590
#15589
828.67
-016