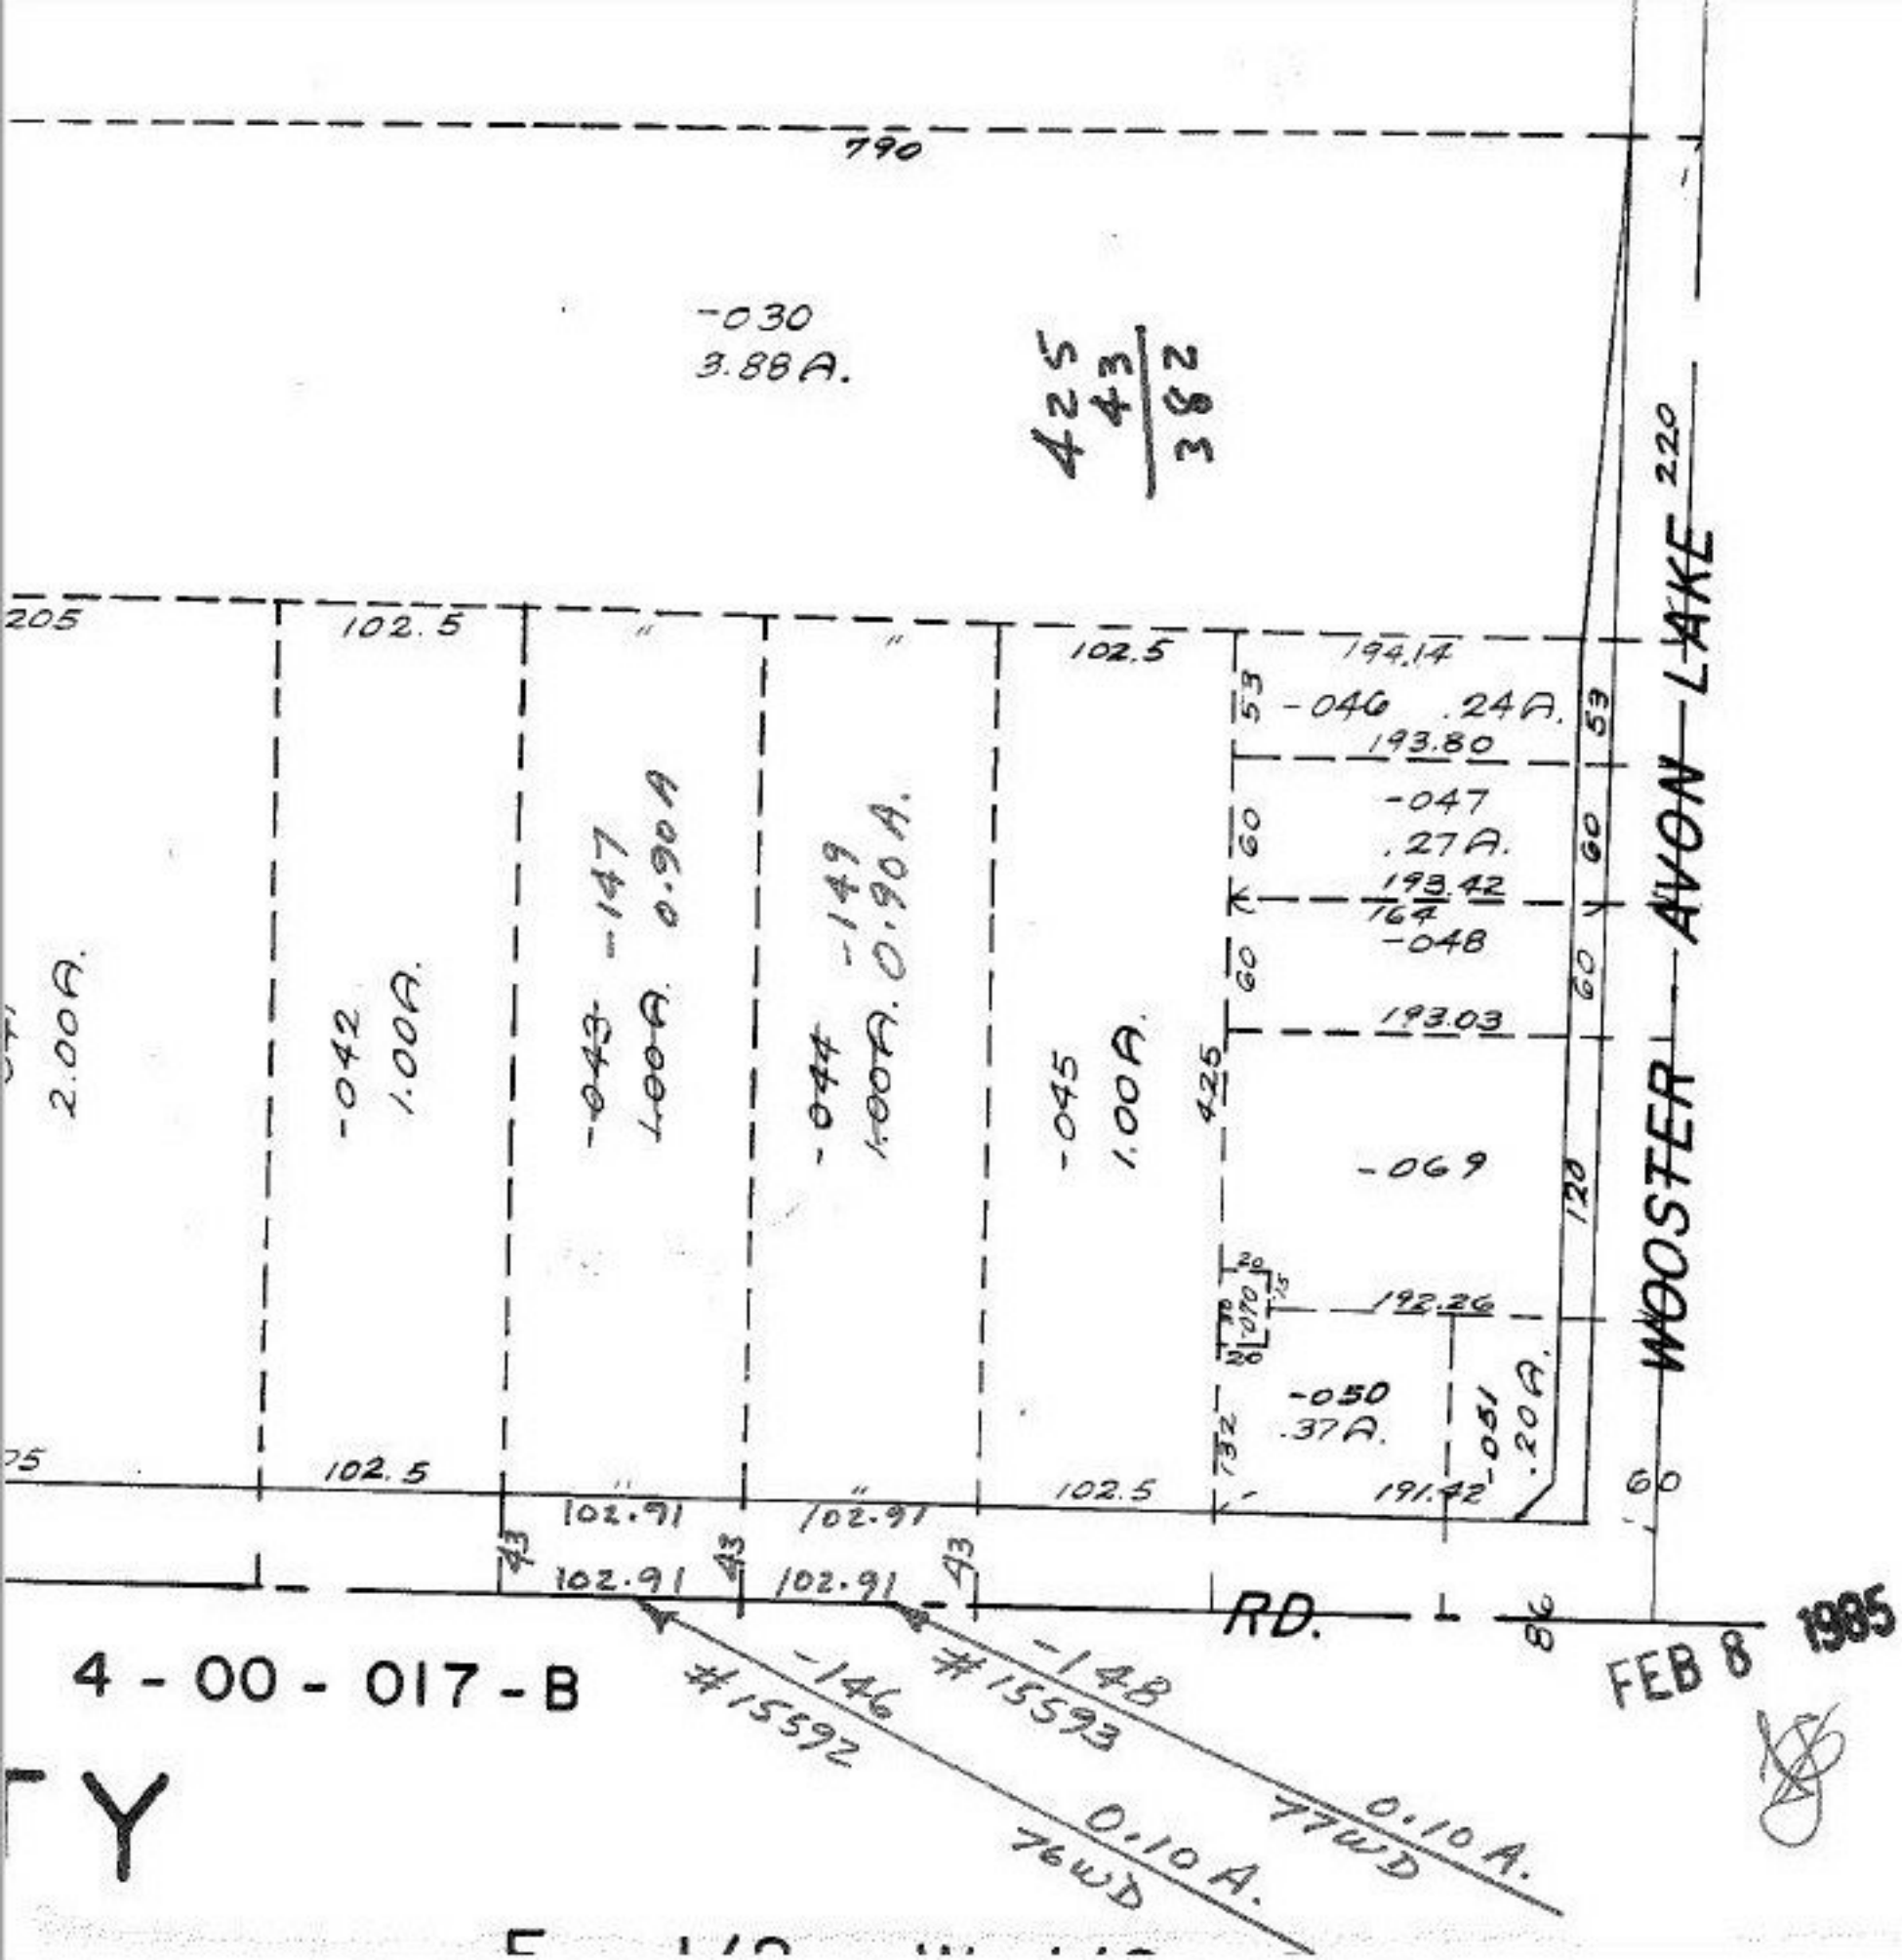

#15592
#15593

APPROVED
LORAIN CO.
MAP DEPT.

DATE 6-12-84
PAGE 4-00-018 J
BY [signature]
VOID AFTER 1559 2/3