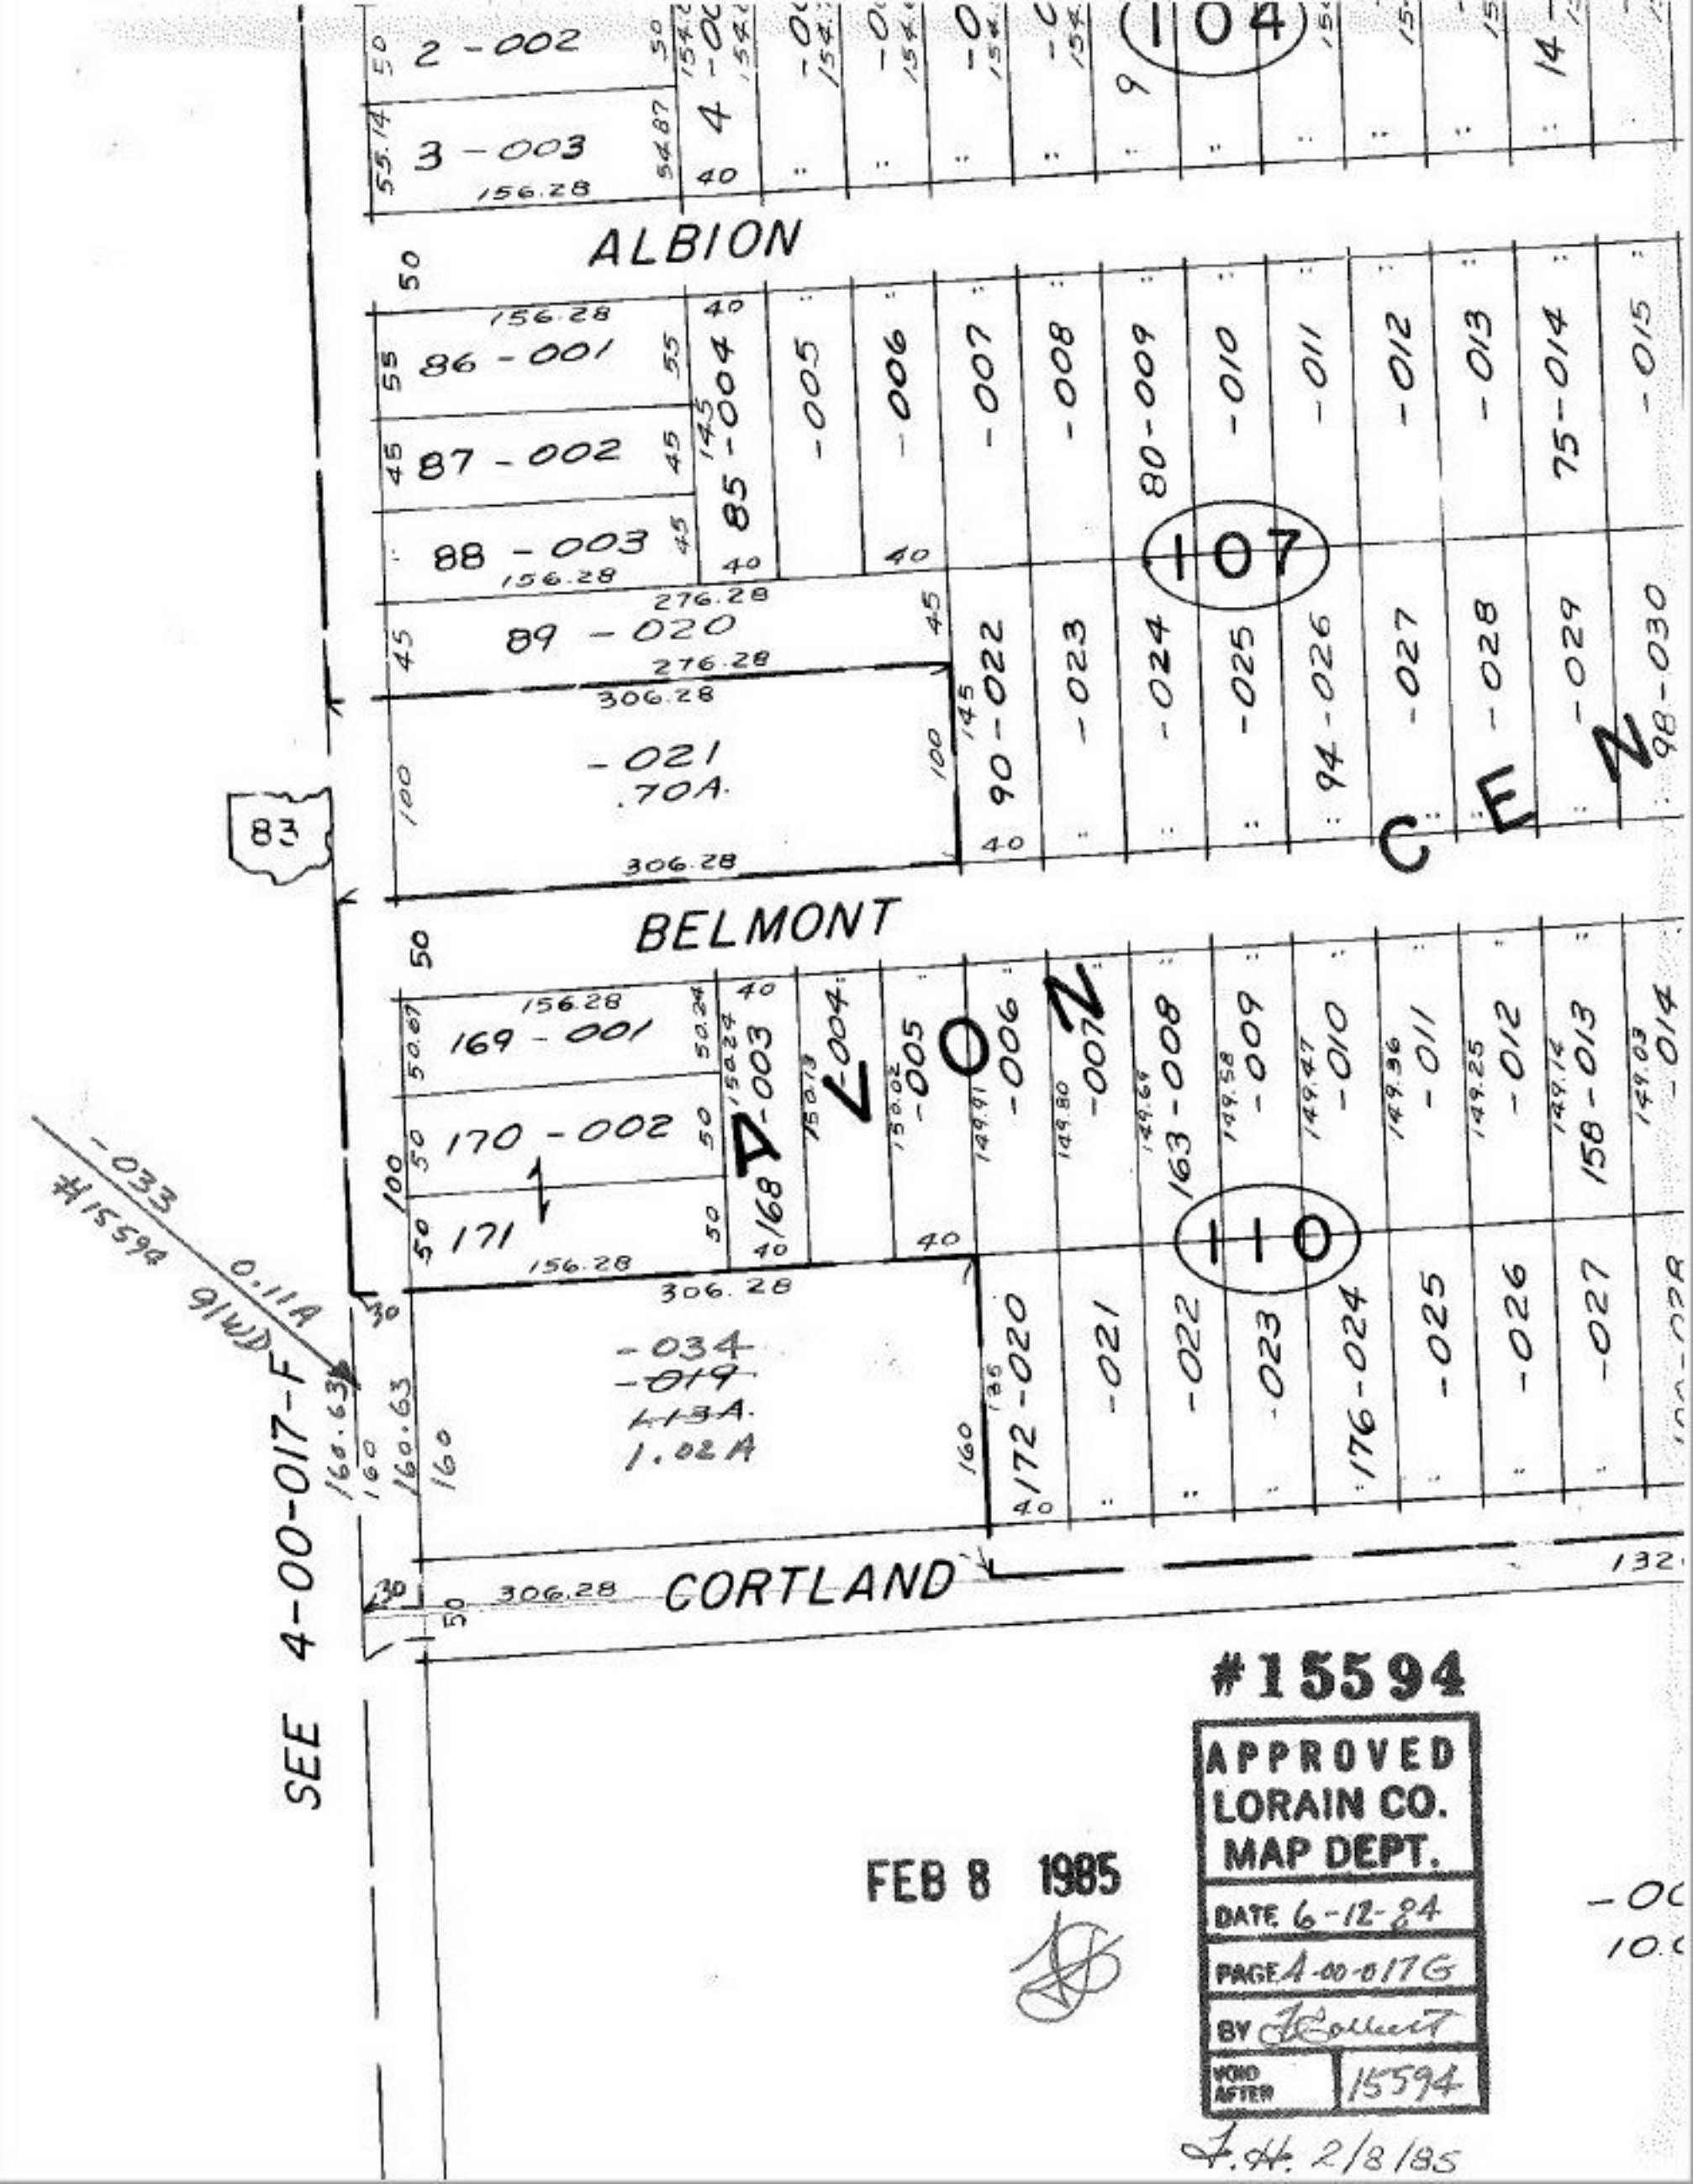

ALBION
BELMONT
CORTLAND
104
107
110
83
SEE 4-00-017-F
#15594
0.11A
91WD
-033
#15594
FEB 8 1985
APPROVED
LORAIN CO.
MAP DEPT.
DATE 6-12-84
PAGE 4-00-017G
BY
VOID AFTER 15594
F.H. 2/8/85