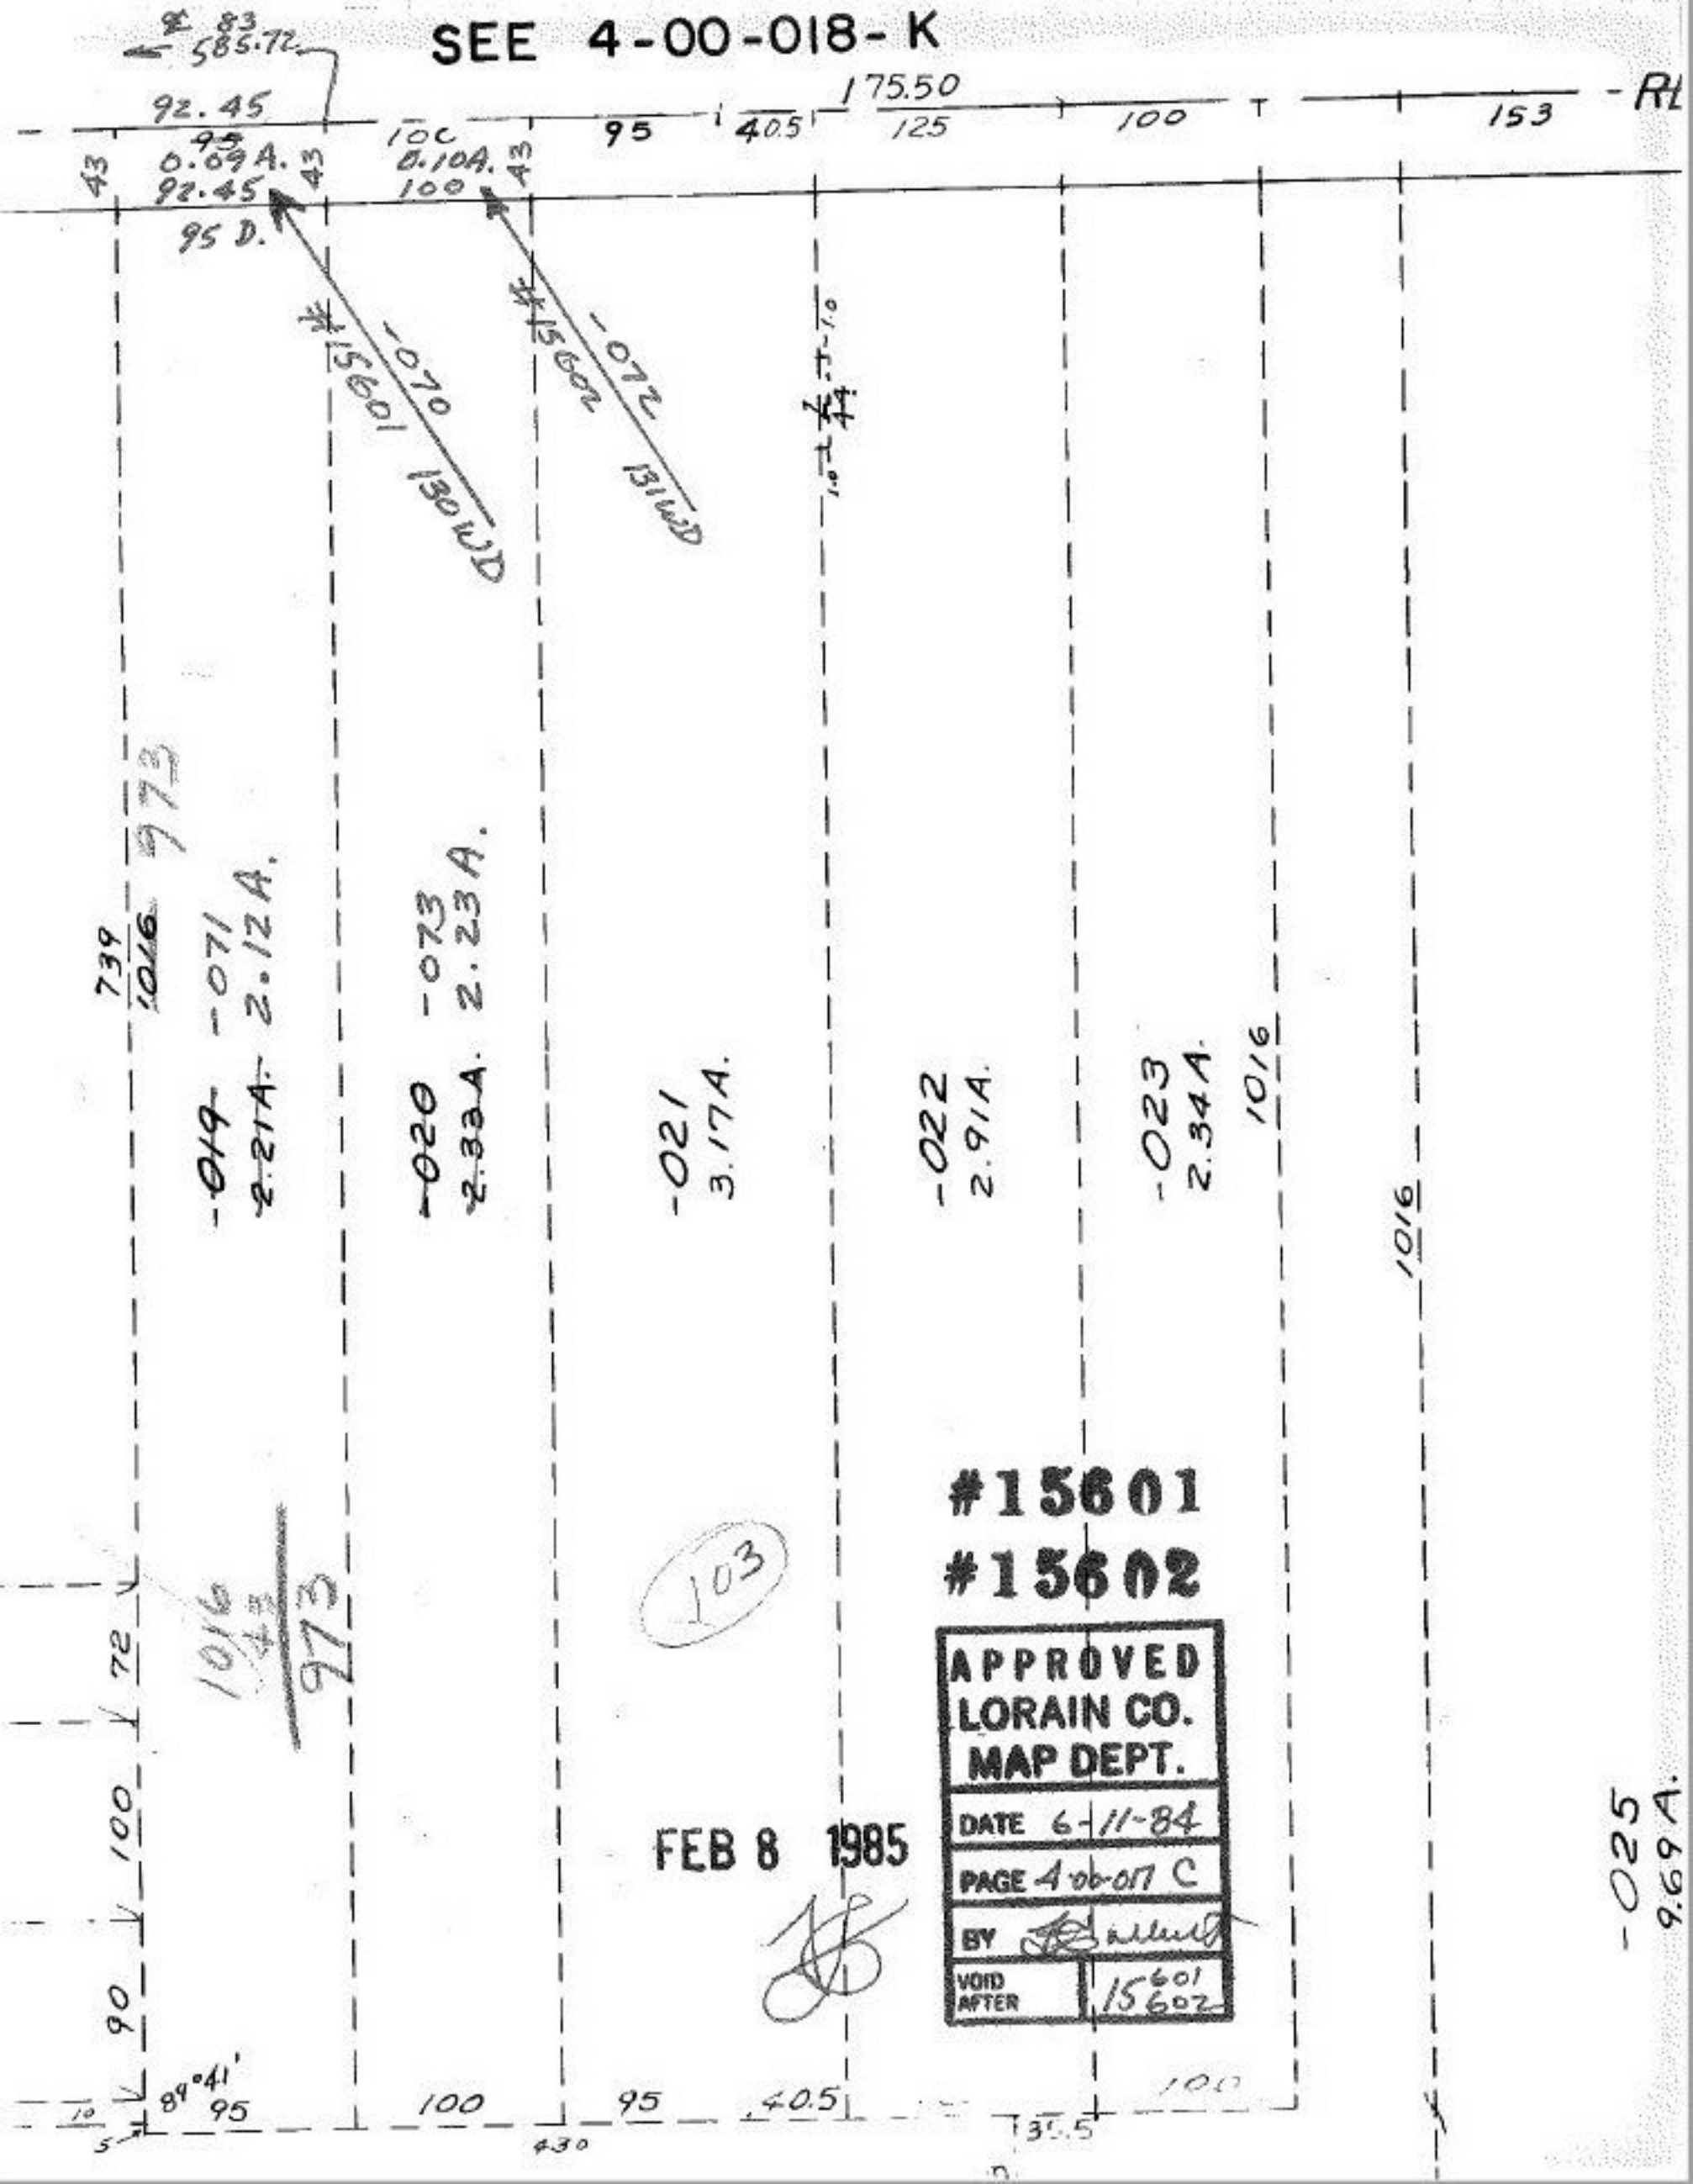
SEE 4-00-018-K
℄ 83
585.72
92.45
175.50
95
40.5
125
100
153
RL
43
0.09 A.
92.45
95 D.
100
0.10A.
100
#15601
-070
130WD
#15602
-072
131WD
739
1016
973
-071
2.12A.
-073
2.23A.
-019
2.21A.
-020
2.33A.
-021
3.17A.
-022
2.91A.
-023
2.34A.
1016
1016
#15601
#15602
103
1016
43
973
72
100
90
APPROVED
LORAIN CO.
MAP DEPT.
DATE 6-11-84
PAGE 4-00-017 C
BY
VOID AFTER 15601 15602
FEB 8 1985
-025
9.69A.
89°41'
95
100
95
40.5
100
430
35.5