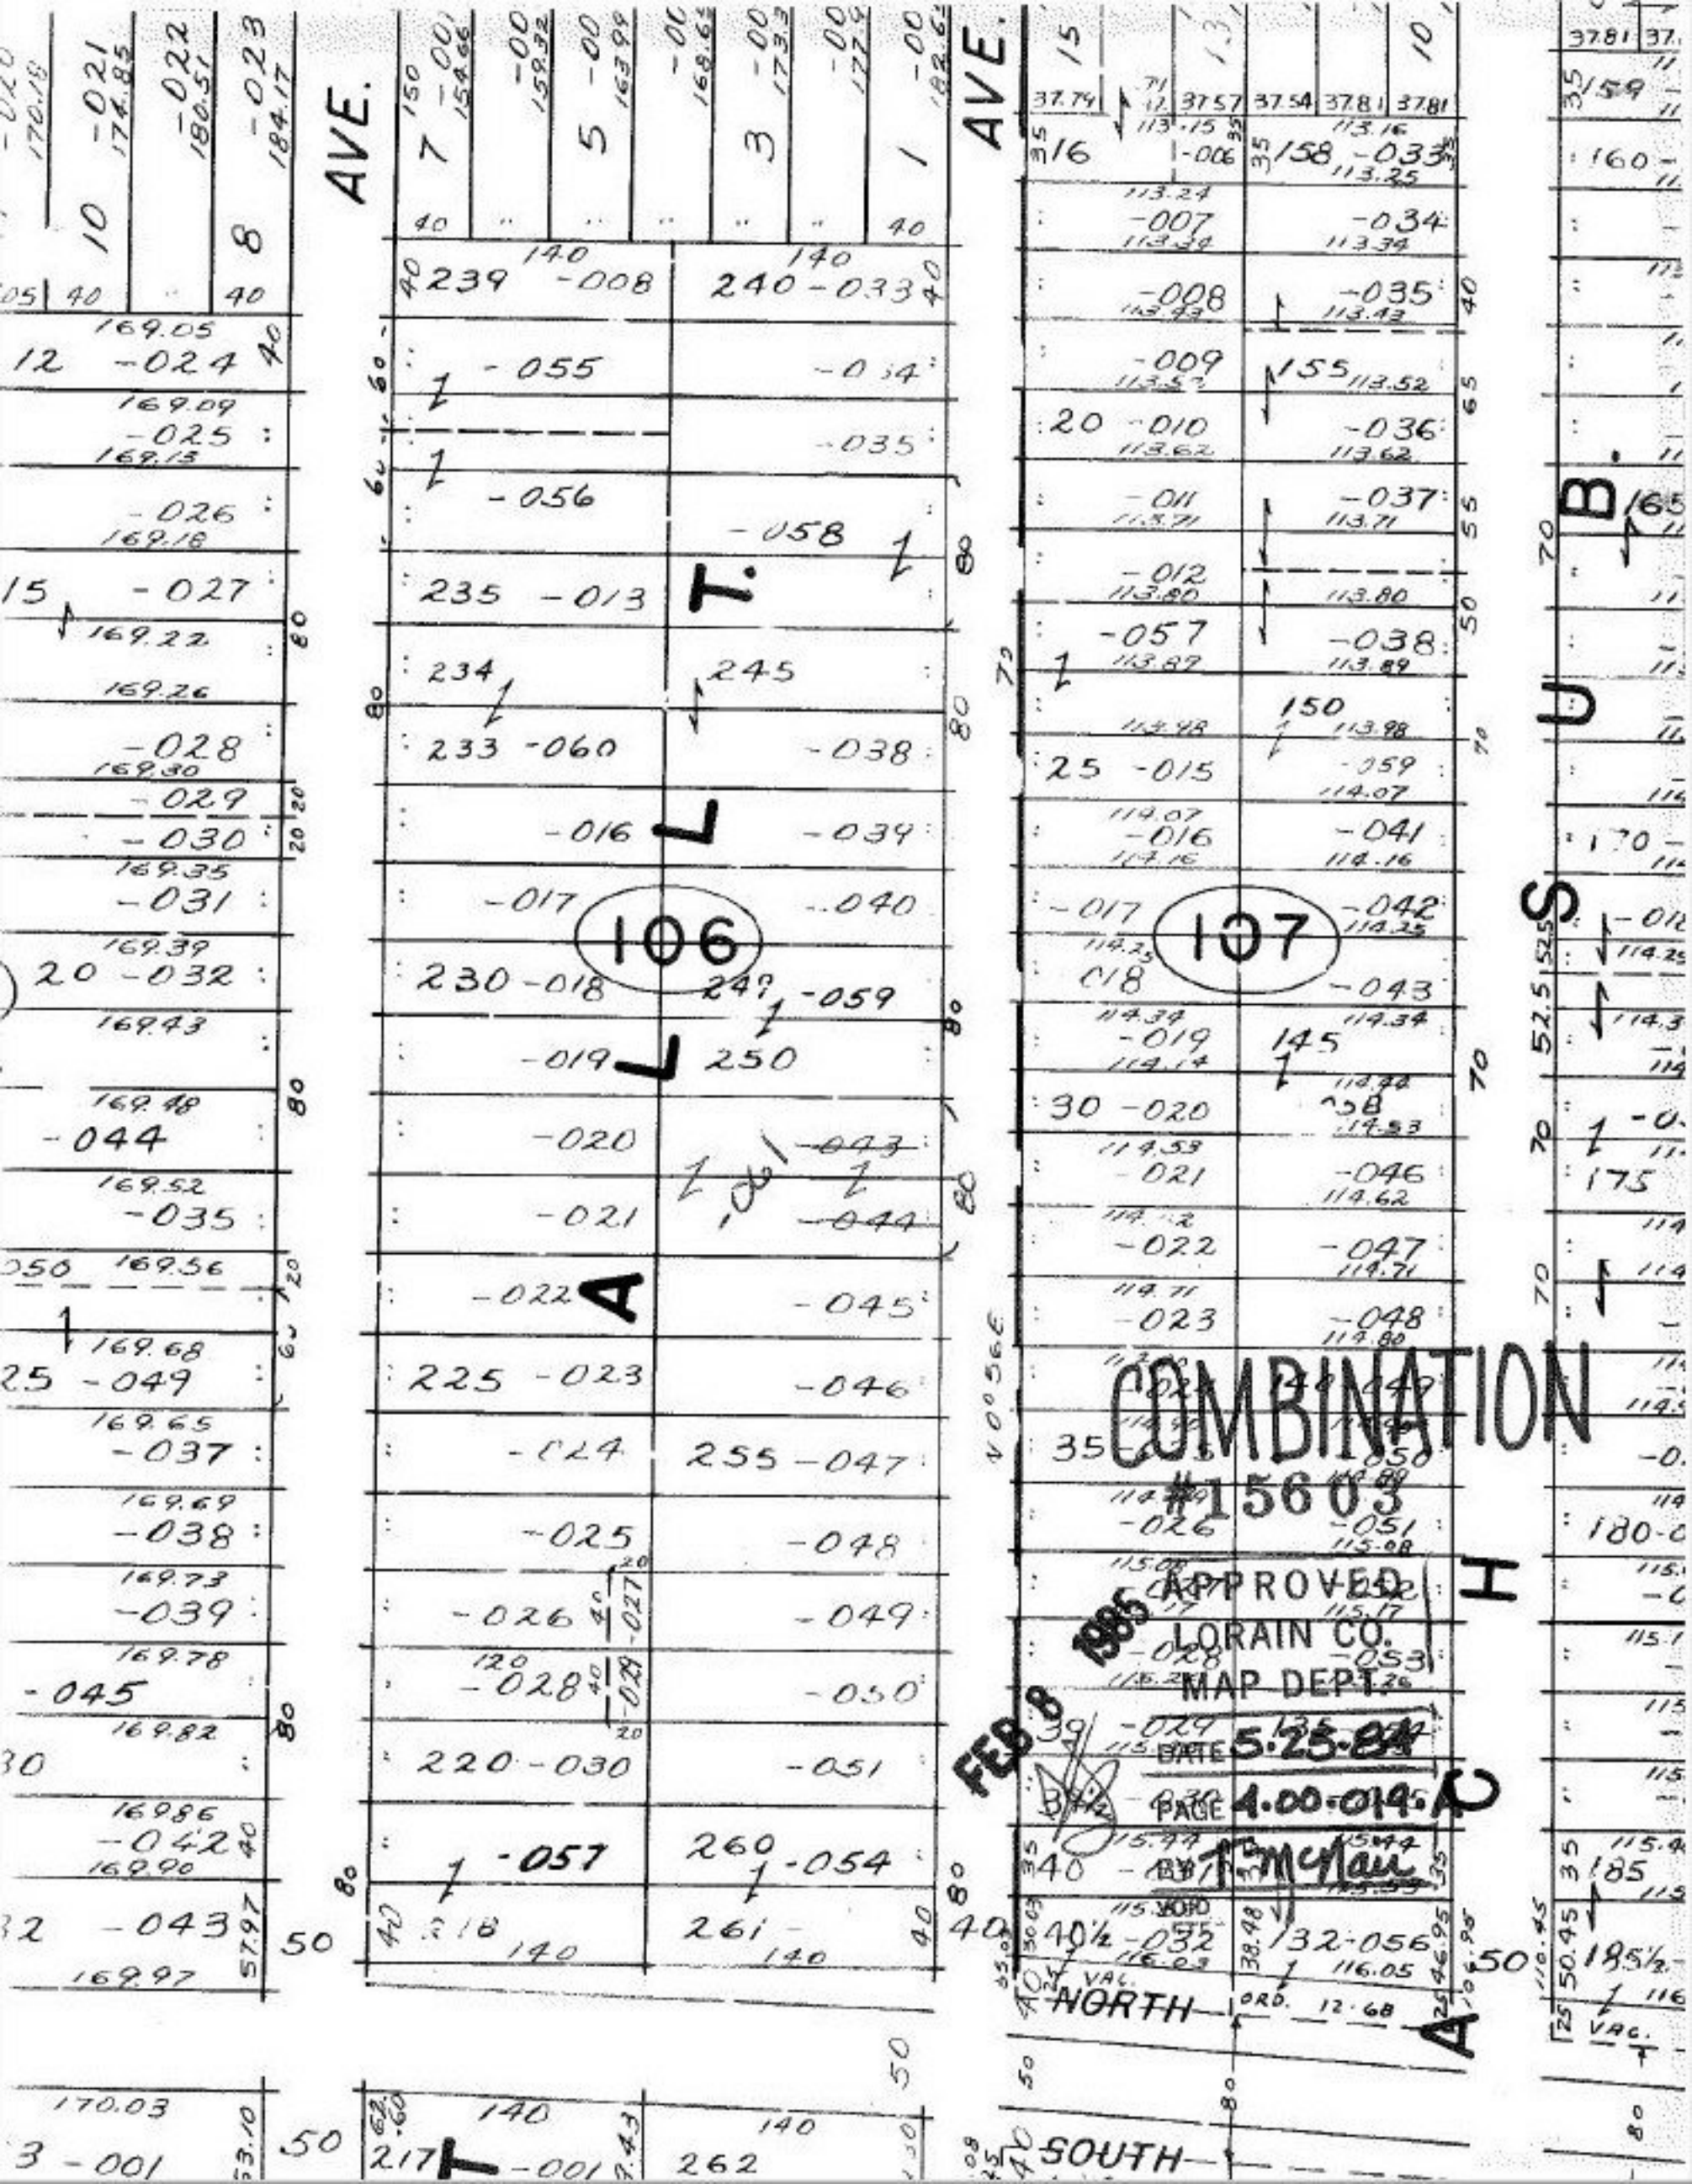
AVE.
AVE.
106
107
NORTH
SOUTH
COMBINATION
#15603
APPROVED
LORAIN CO.
MAP DEPT.
DATE 5-25-84
PAGE 4.00-014.A
BY
VOID
FEB 8 1985
ORD. 12-68
VAC.