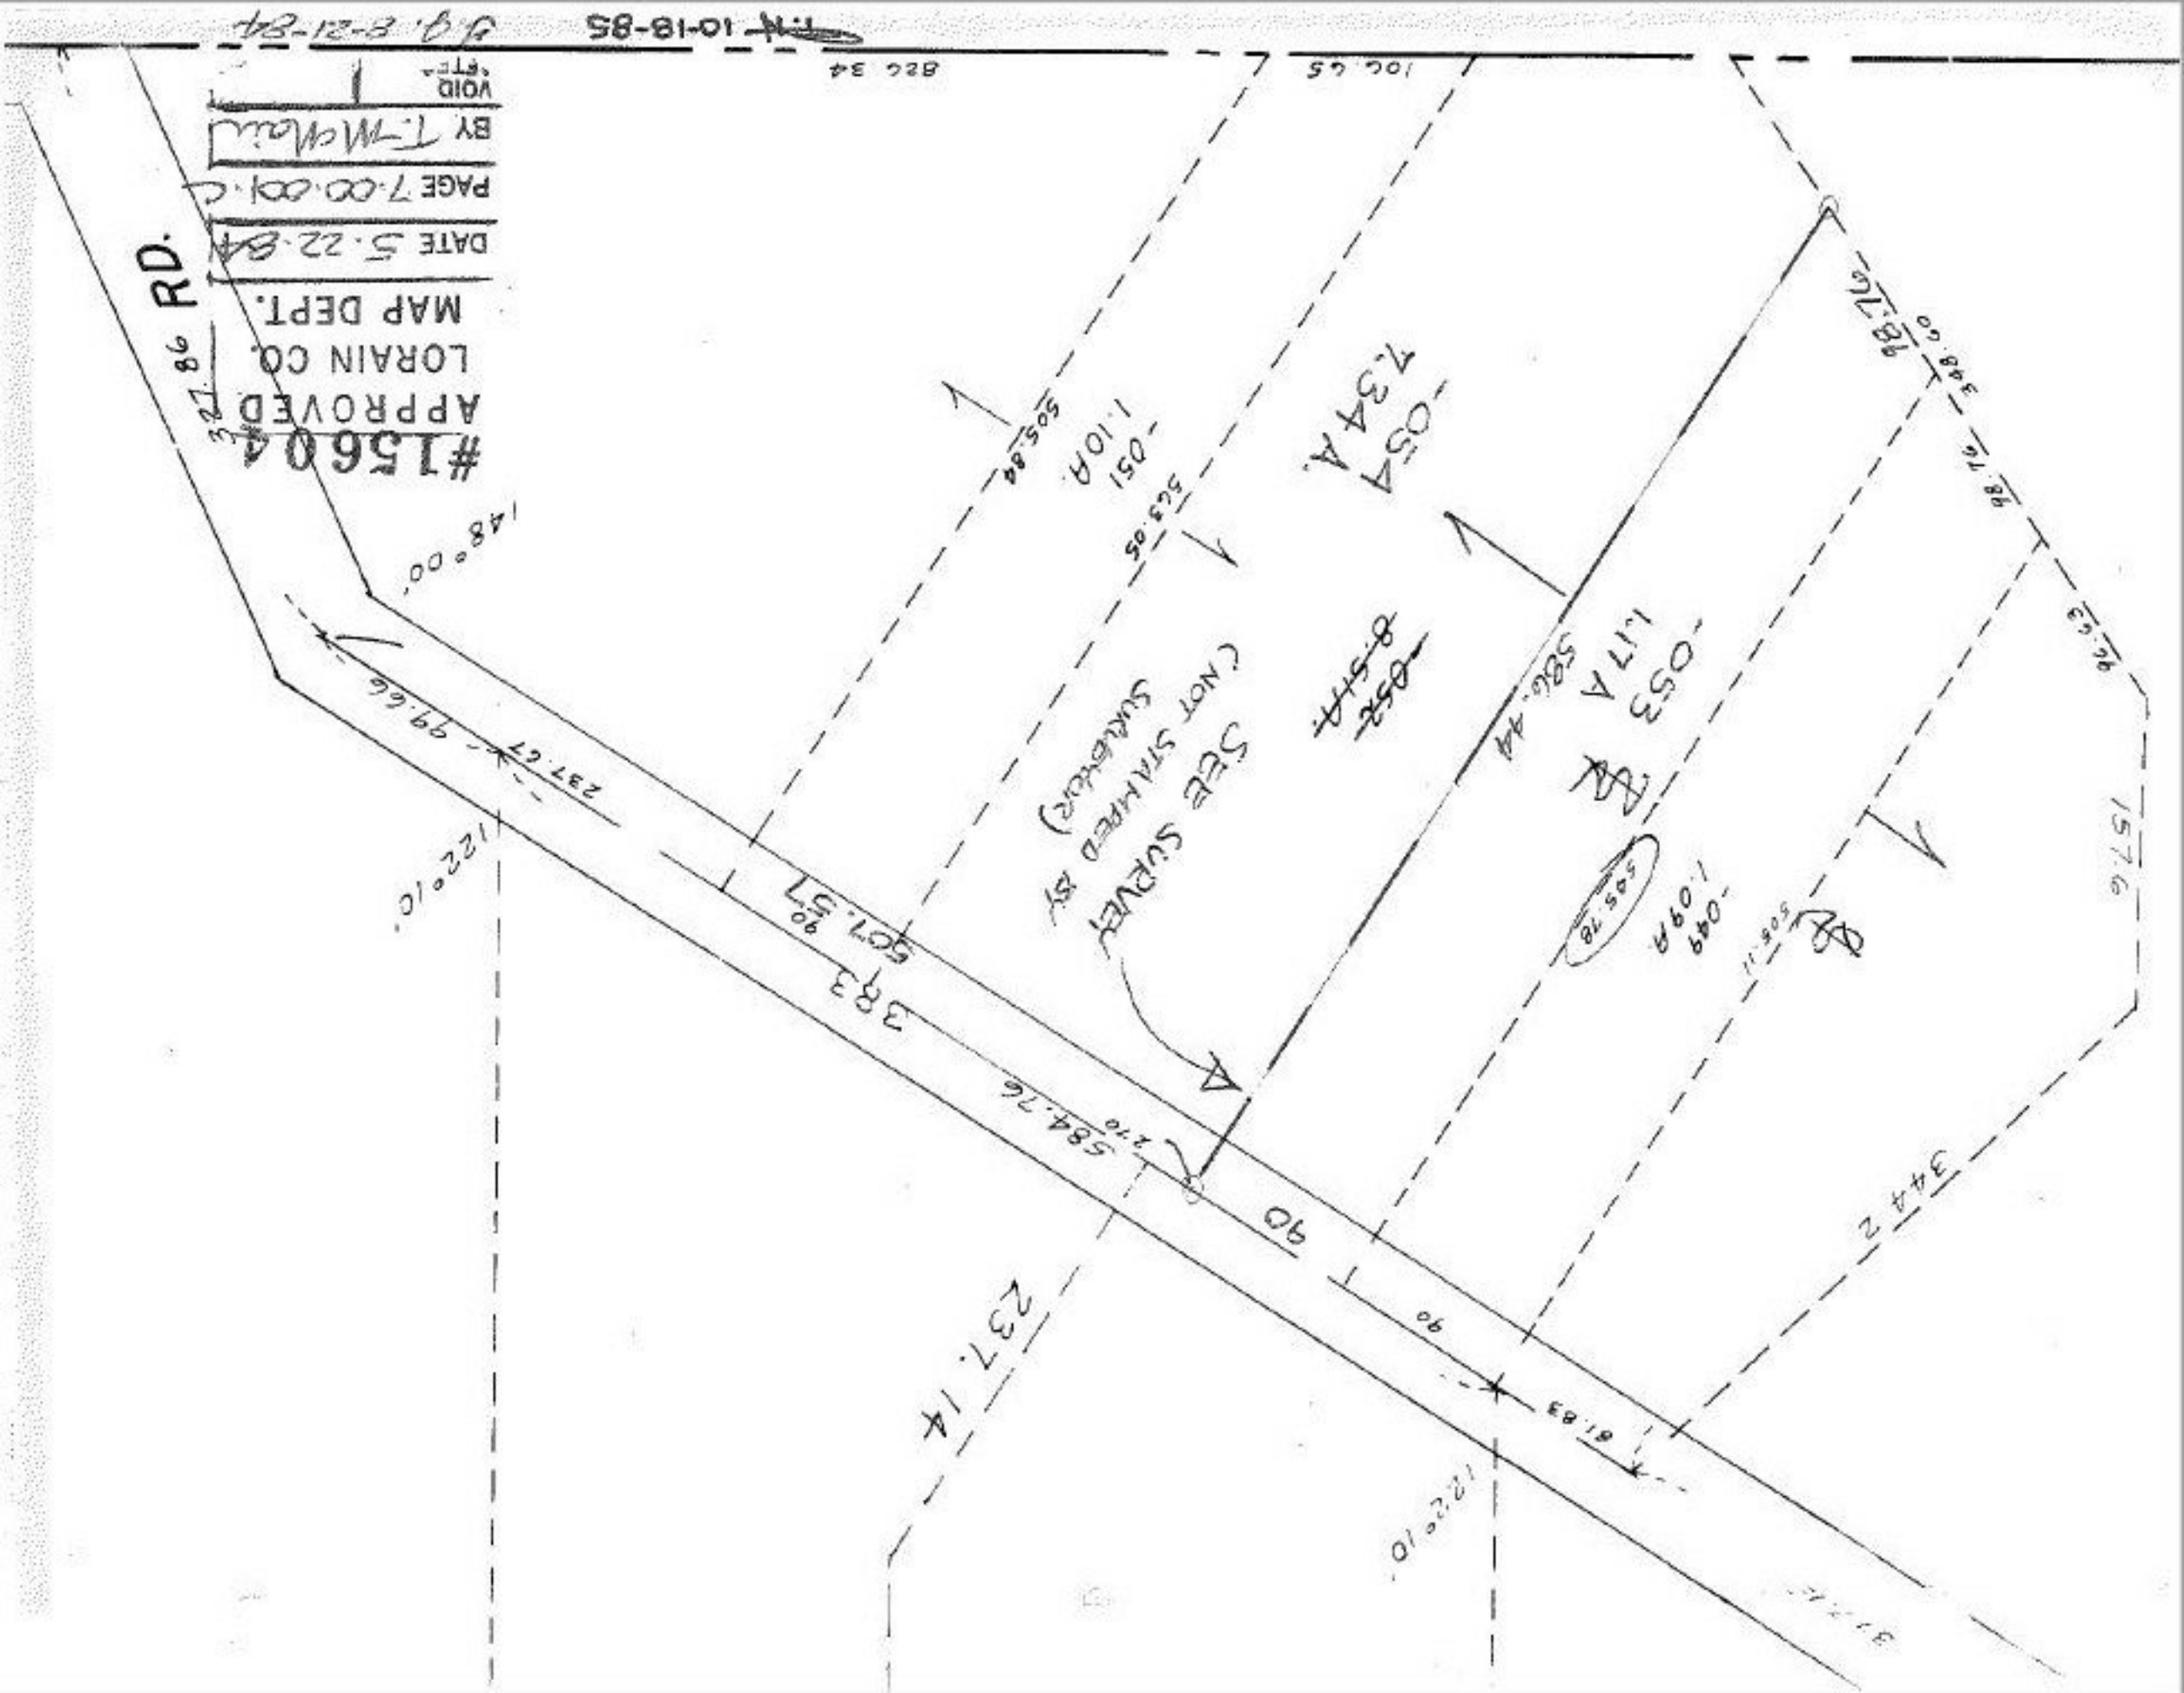
#15604
APPROVED
LORAIN CO.
MAP DEPT.
DATE 5.22.84
PAGE 7.00.001.C
BY T. McNair
VOID
RD.
327.86
SEE SURVEY
(NOT STAMPED BY
SURVEYOR)
-054
7.34A.
-051
1.10A.
-053
1.17A
-049
1.09A
383
507.57
90
237.14
344.2
157.6
98.76
348.60
96.63
586.44
505.78
505.11
584.76
270
81.83
122°10'
148°00'
237.67
99.66
505.84
563.05
10G.65
82G.34