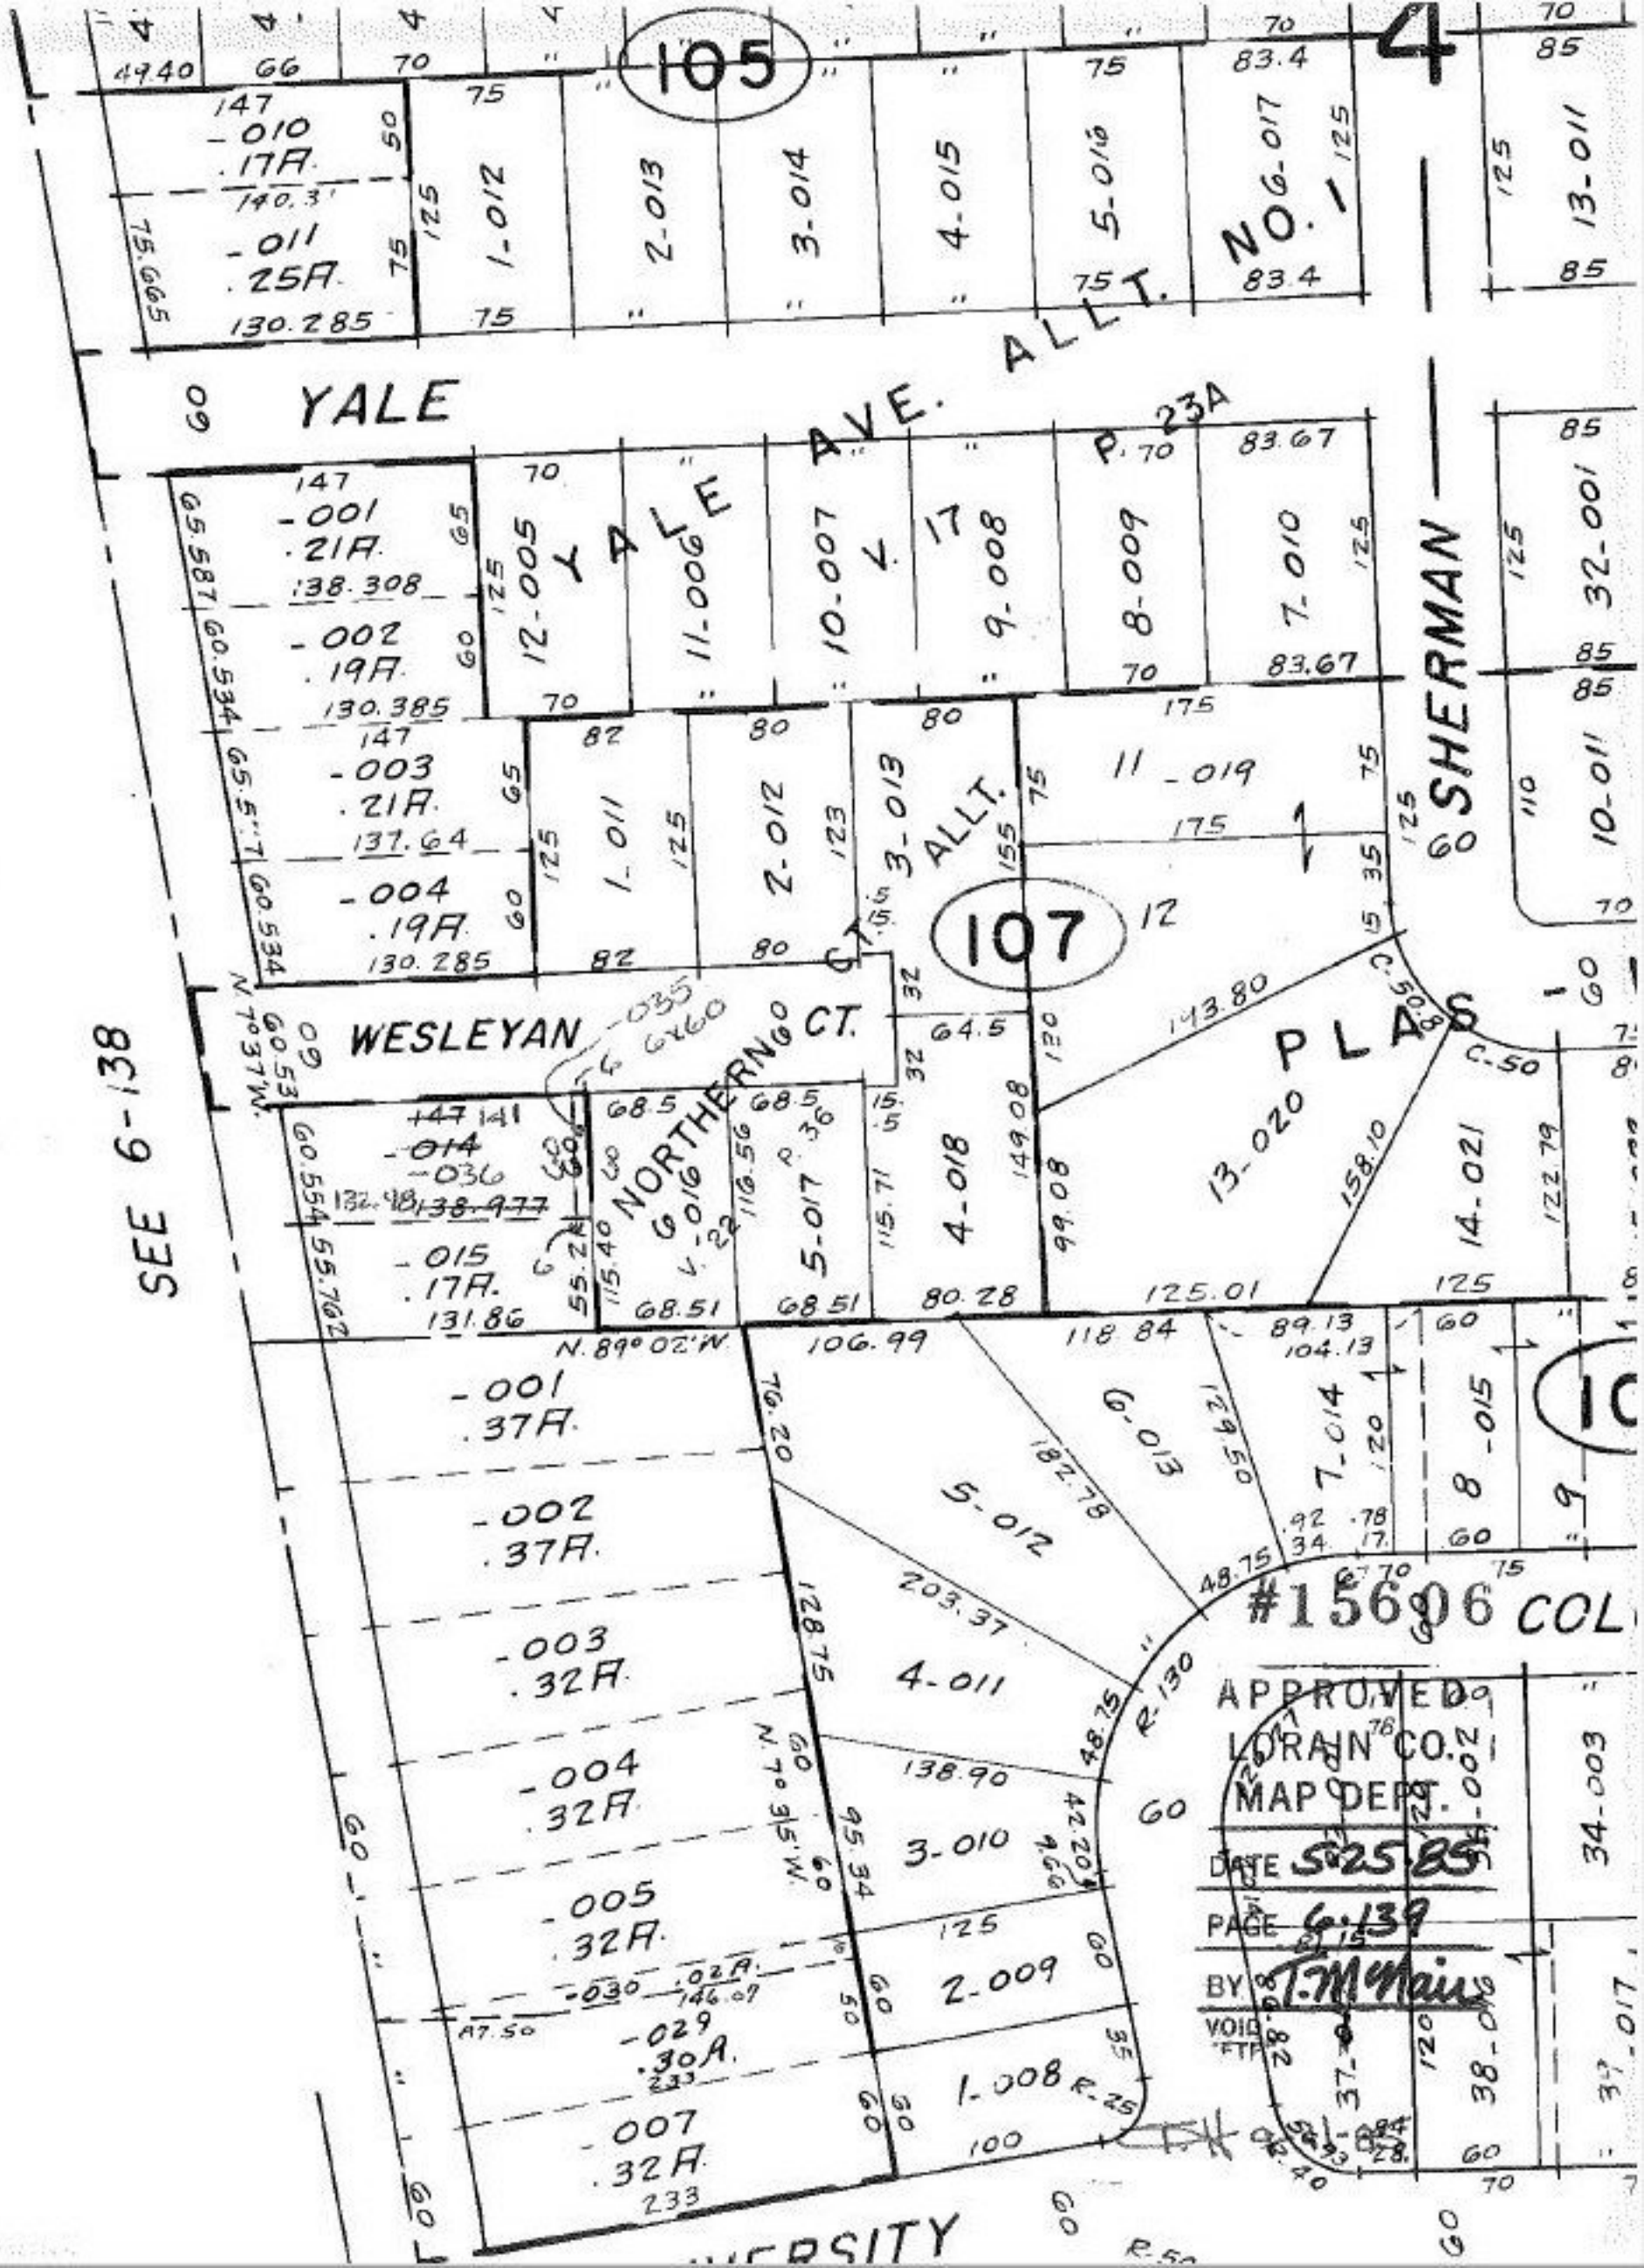

105
4
YALE
YALE AVE. ALLT. NO. 1
P. 23A
SHERMAN
107
WESLEYAN CT.
NORTHERN CT. ALLT.
PLAS
SEE 6-138
#15606 COL
APPROVED
LORAIN CO.
MAP DEPT.
DATE 5-25-85
PAGE 6-139
BY T.M. Main
VOID