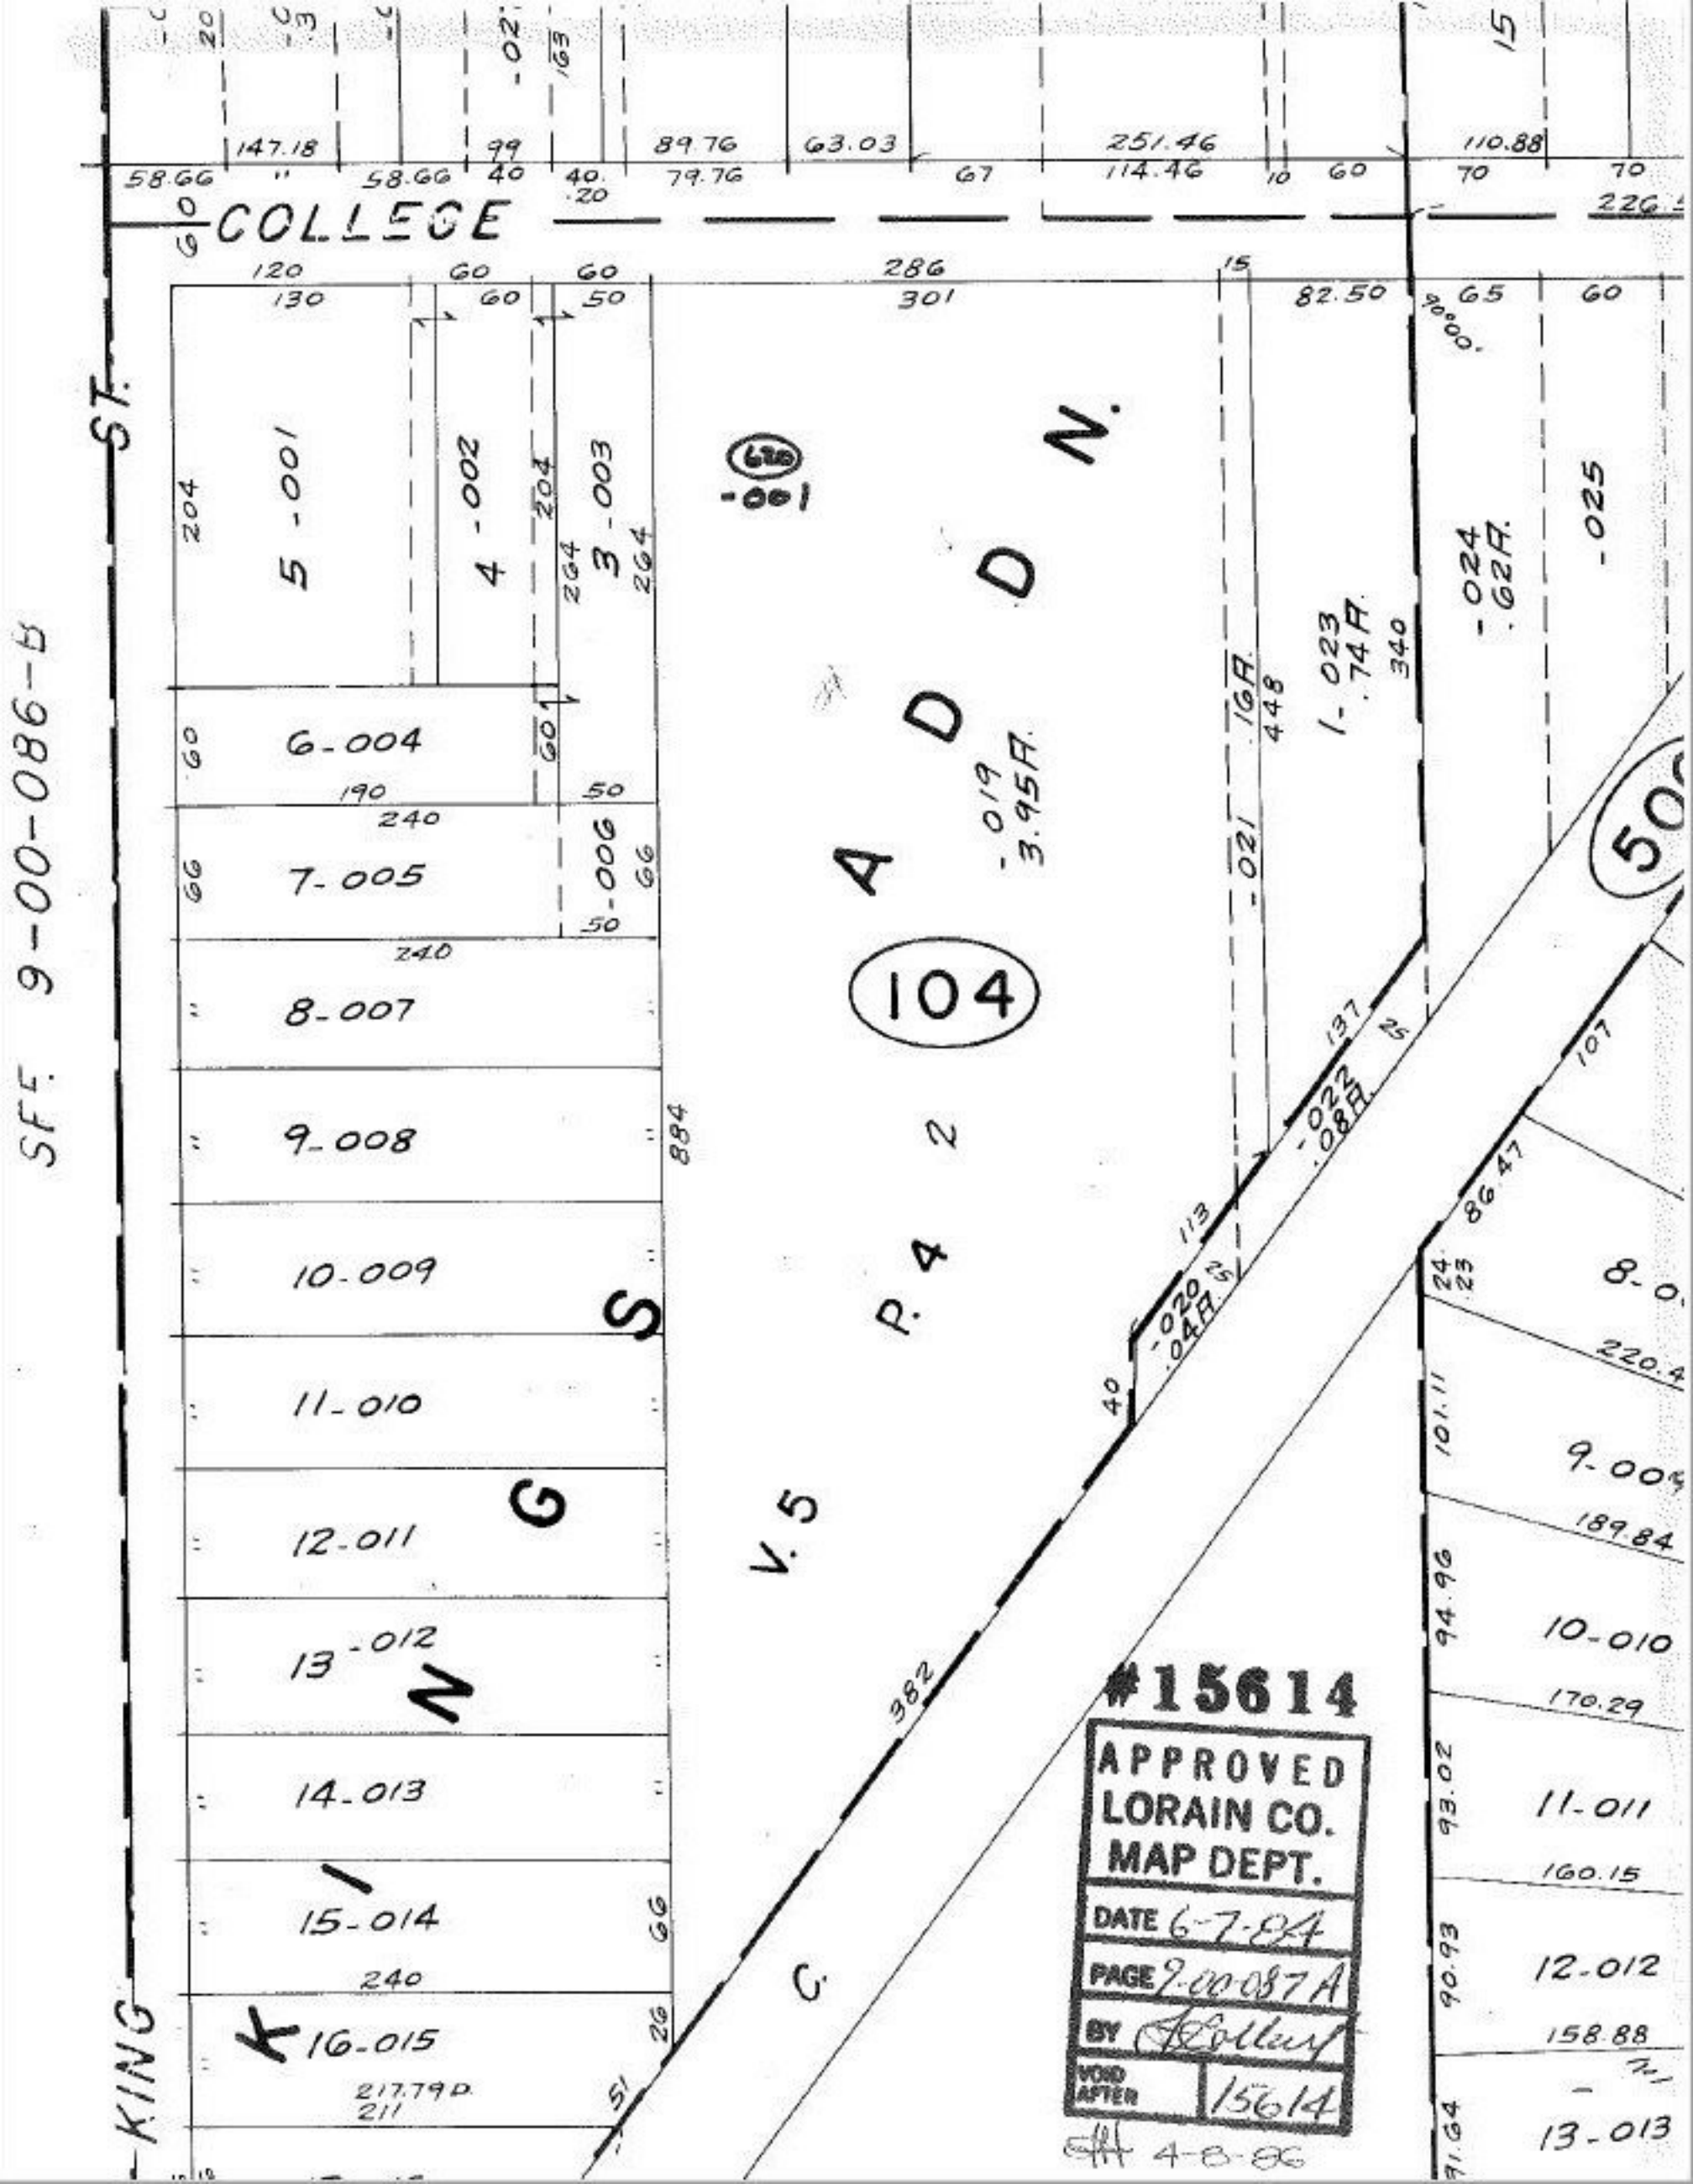
COLLEGE
ST.
KING
SFE. 9-00-086-B
5-001
4-002
3-003
6-004
7-005
8-007
9-008
10-009
11-010
12-011
13-012
14-013
15-014
16-015
-001
-019
3.95A.
-024
.62A.
-025
1-023
.74A.
-022
.08A.
-020
.04A.
104
P. 4
V. 5
C.
#15614
APPROVED
LORAIN CO.
MAP DEPT.
DATE 6-7-84
PAGE 9-00-087A
BY
VOID AFTER 15614
4-8-86