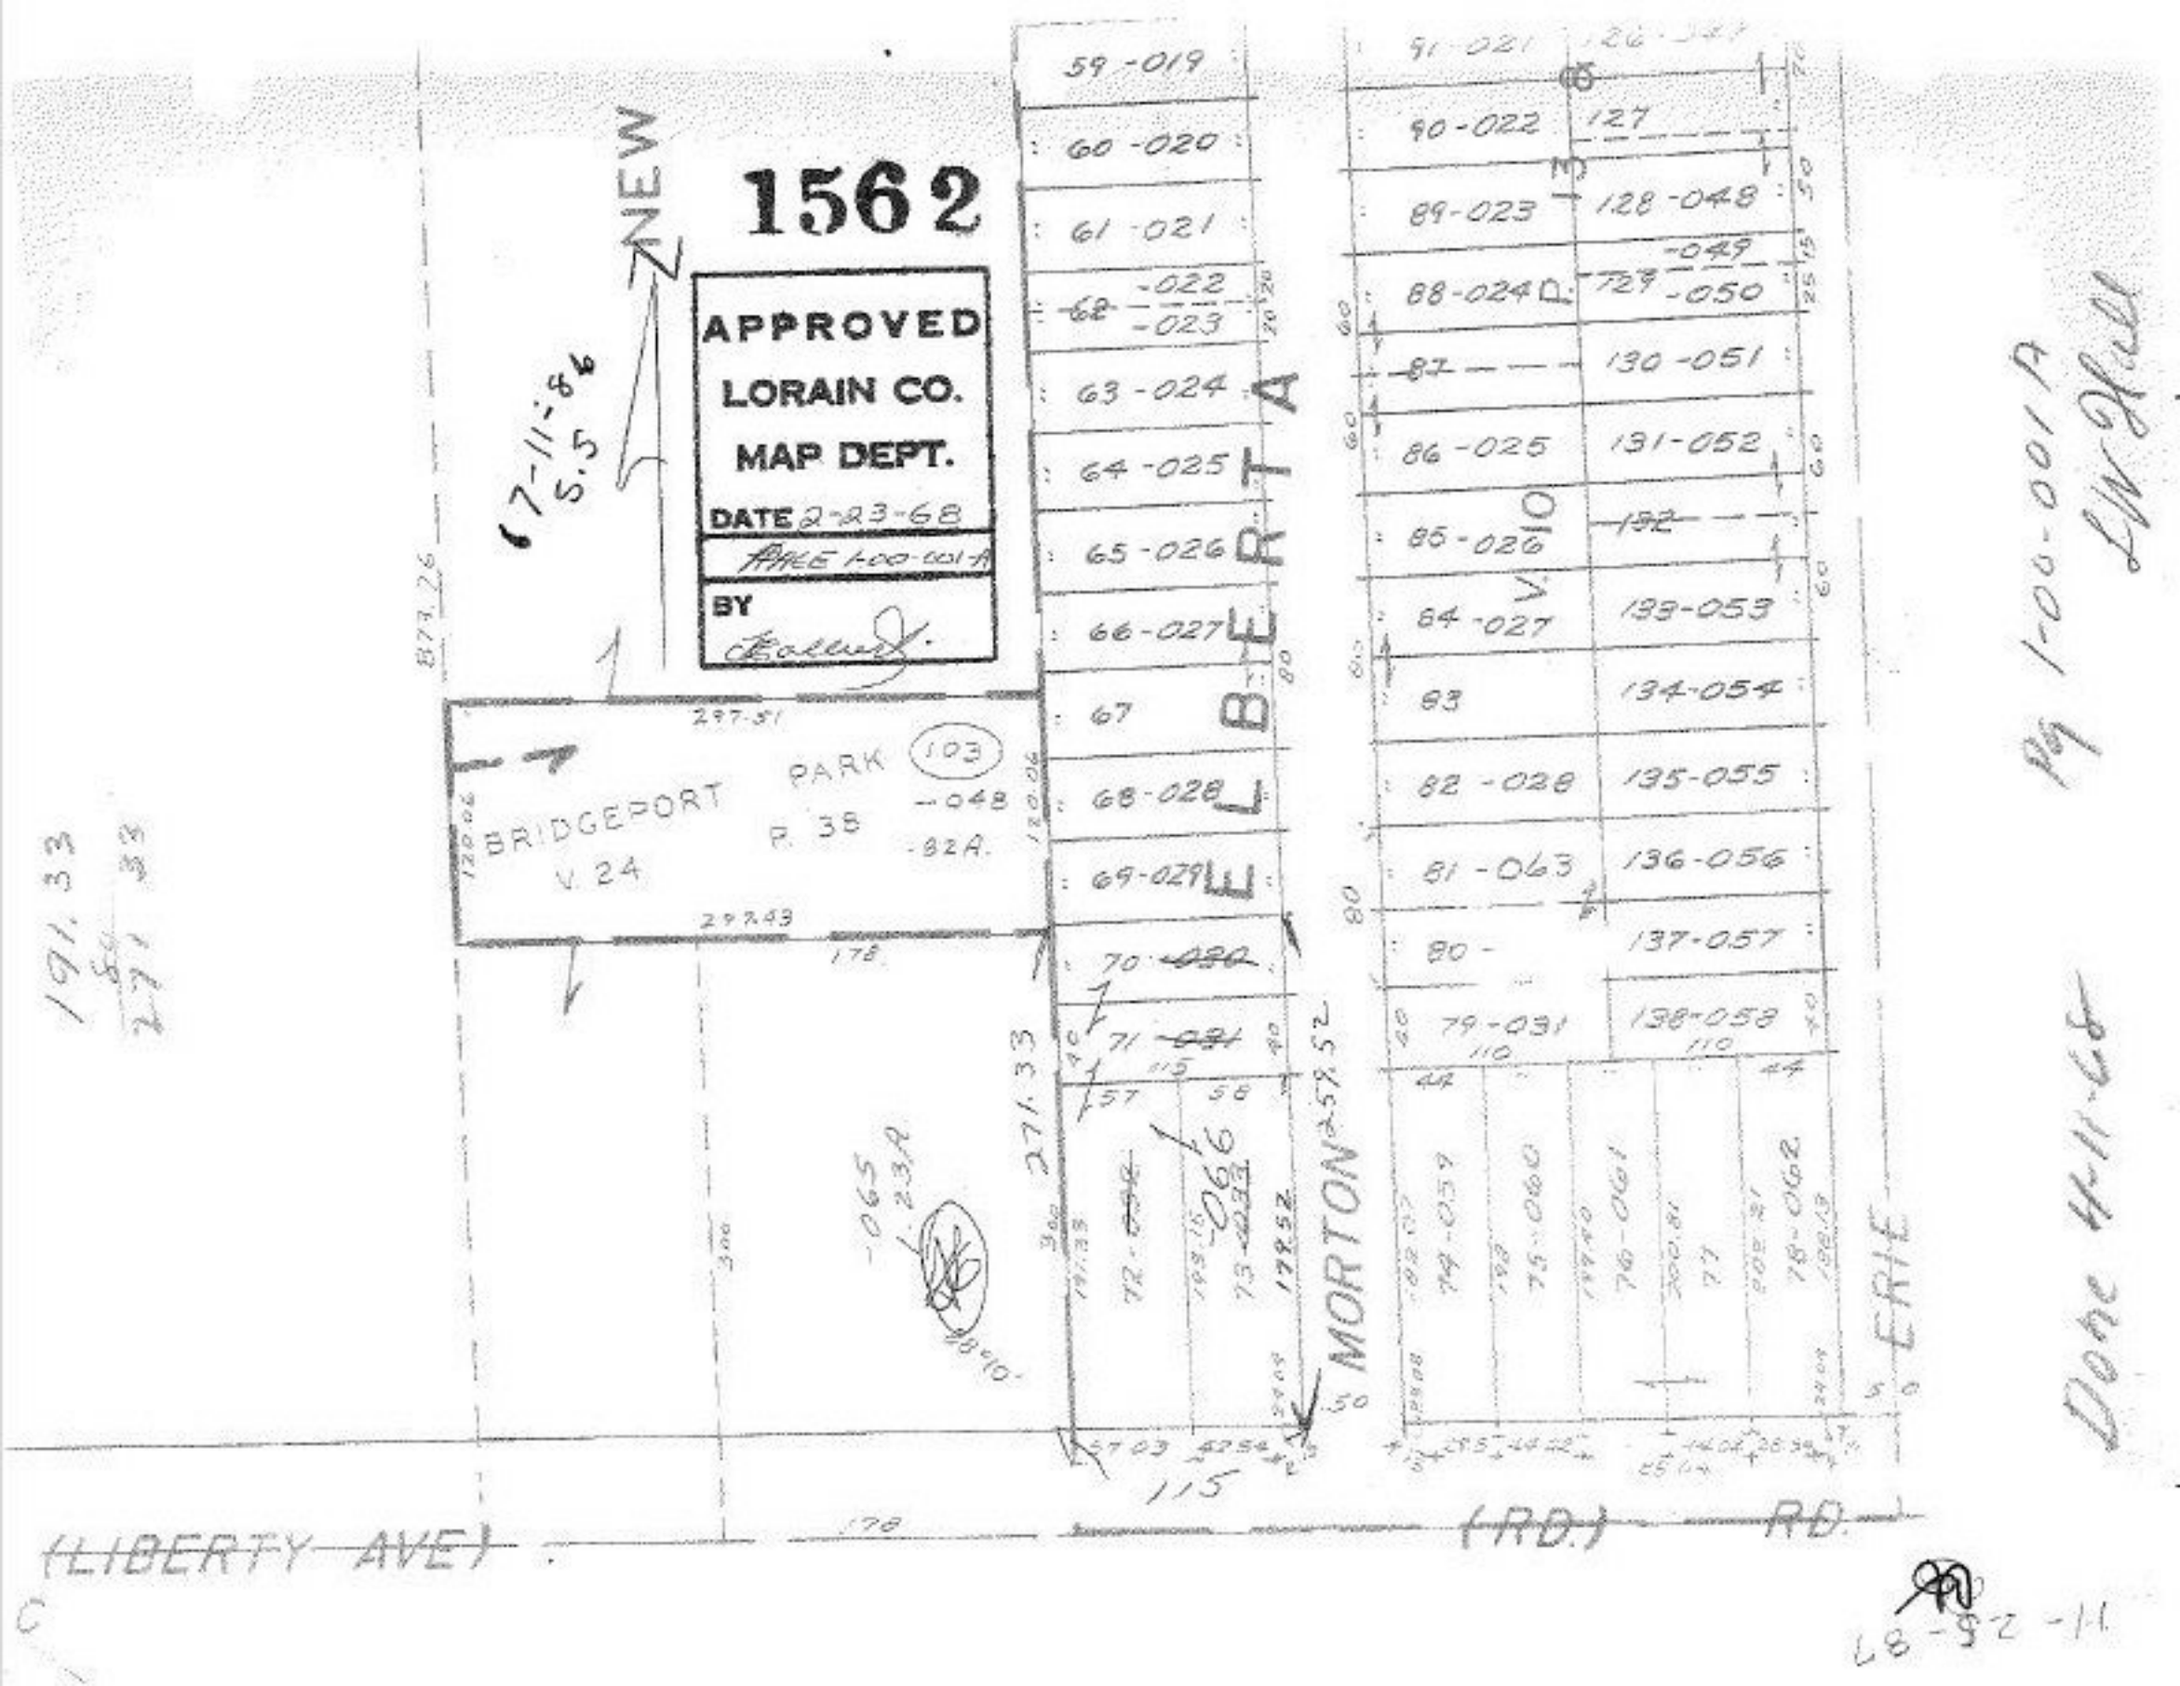
1562
APPROVED
LORAIN CO.
MAP DEPT.
DATE 2-23-68
TAKE 100-001-A
BY
NEW
7-11-86
5.5
BRIDGEPORT
V. 24
PARK
P. 38
103
-048
-82A.
297.51
297.43
178
879.26
300
271.33
191.33
271.33
59-019
60-020
61-021
62 -022 -023
63-024
64-025
65-026
66-027
67
68-028
69-029
70 -030
71 -031
72 -034
73 -033
-065
1.23A
-066
17852
ALBERTA
MORTON
57.52
115
91-021
90-022
89-023
88-024
87
86-025
85-026
84-027
83
82-028
81-063
80
79-031
V. 10
P. 13
127
128-048
-049
129 -050
130-051
131-052
132
133-053
134-054
135-055
136-056
137-057
138-058
110
74-059
75-060
76-001
77
78-062
ERIE
(LIBERTY AVE)
(RD.)
RD.
100-001-A
Lin Ave
Dove 4-11-68
68-92-11