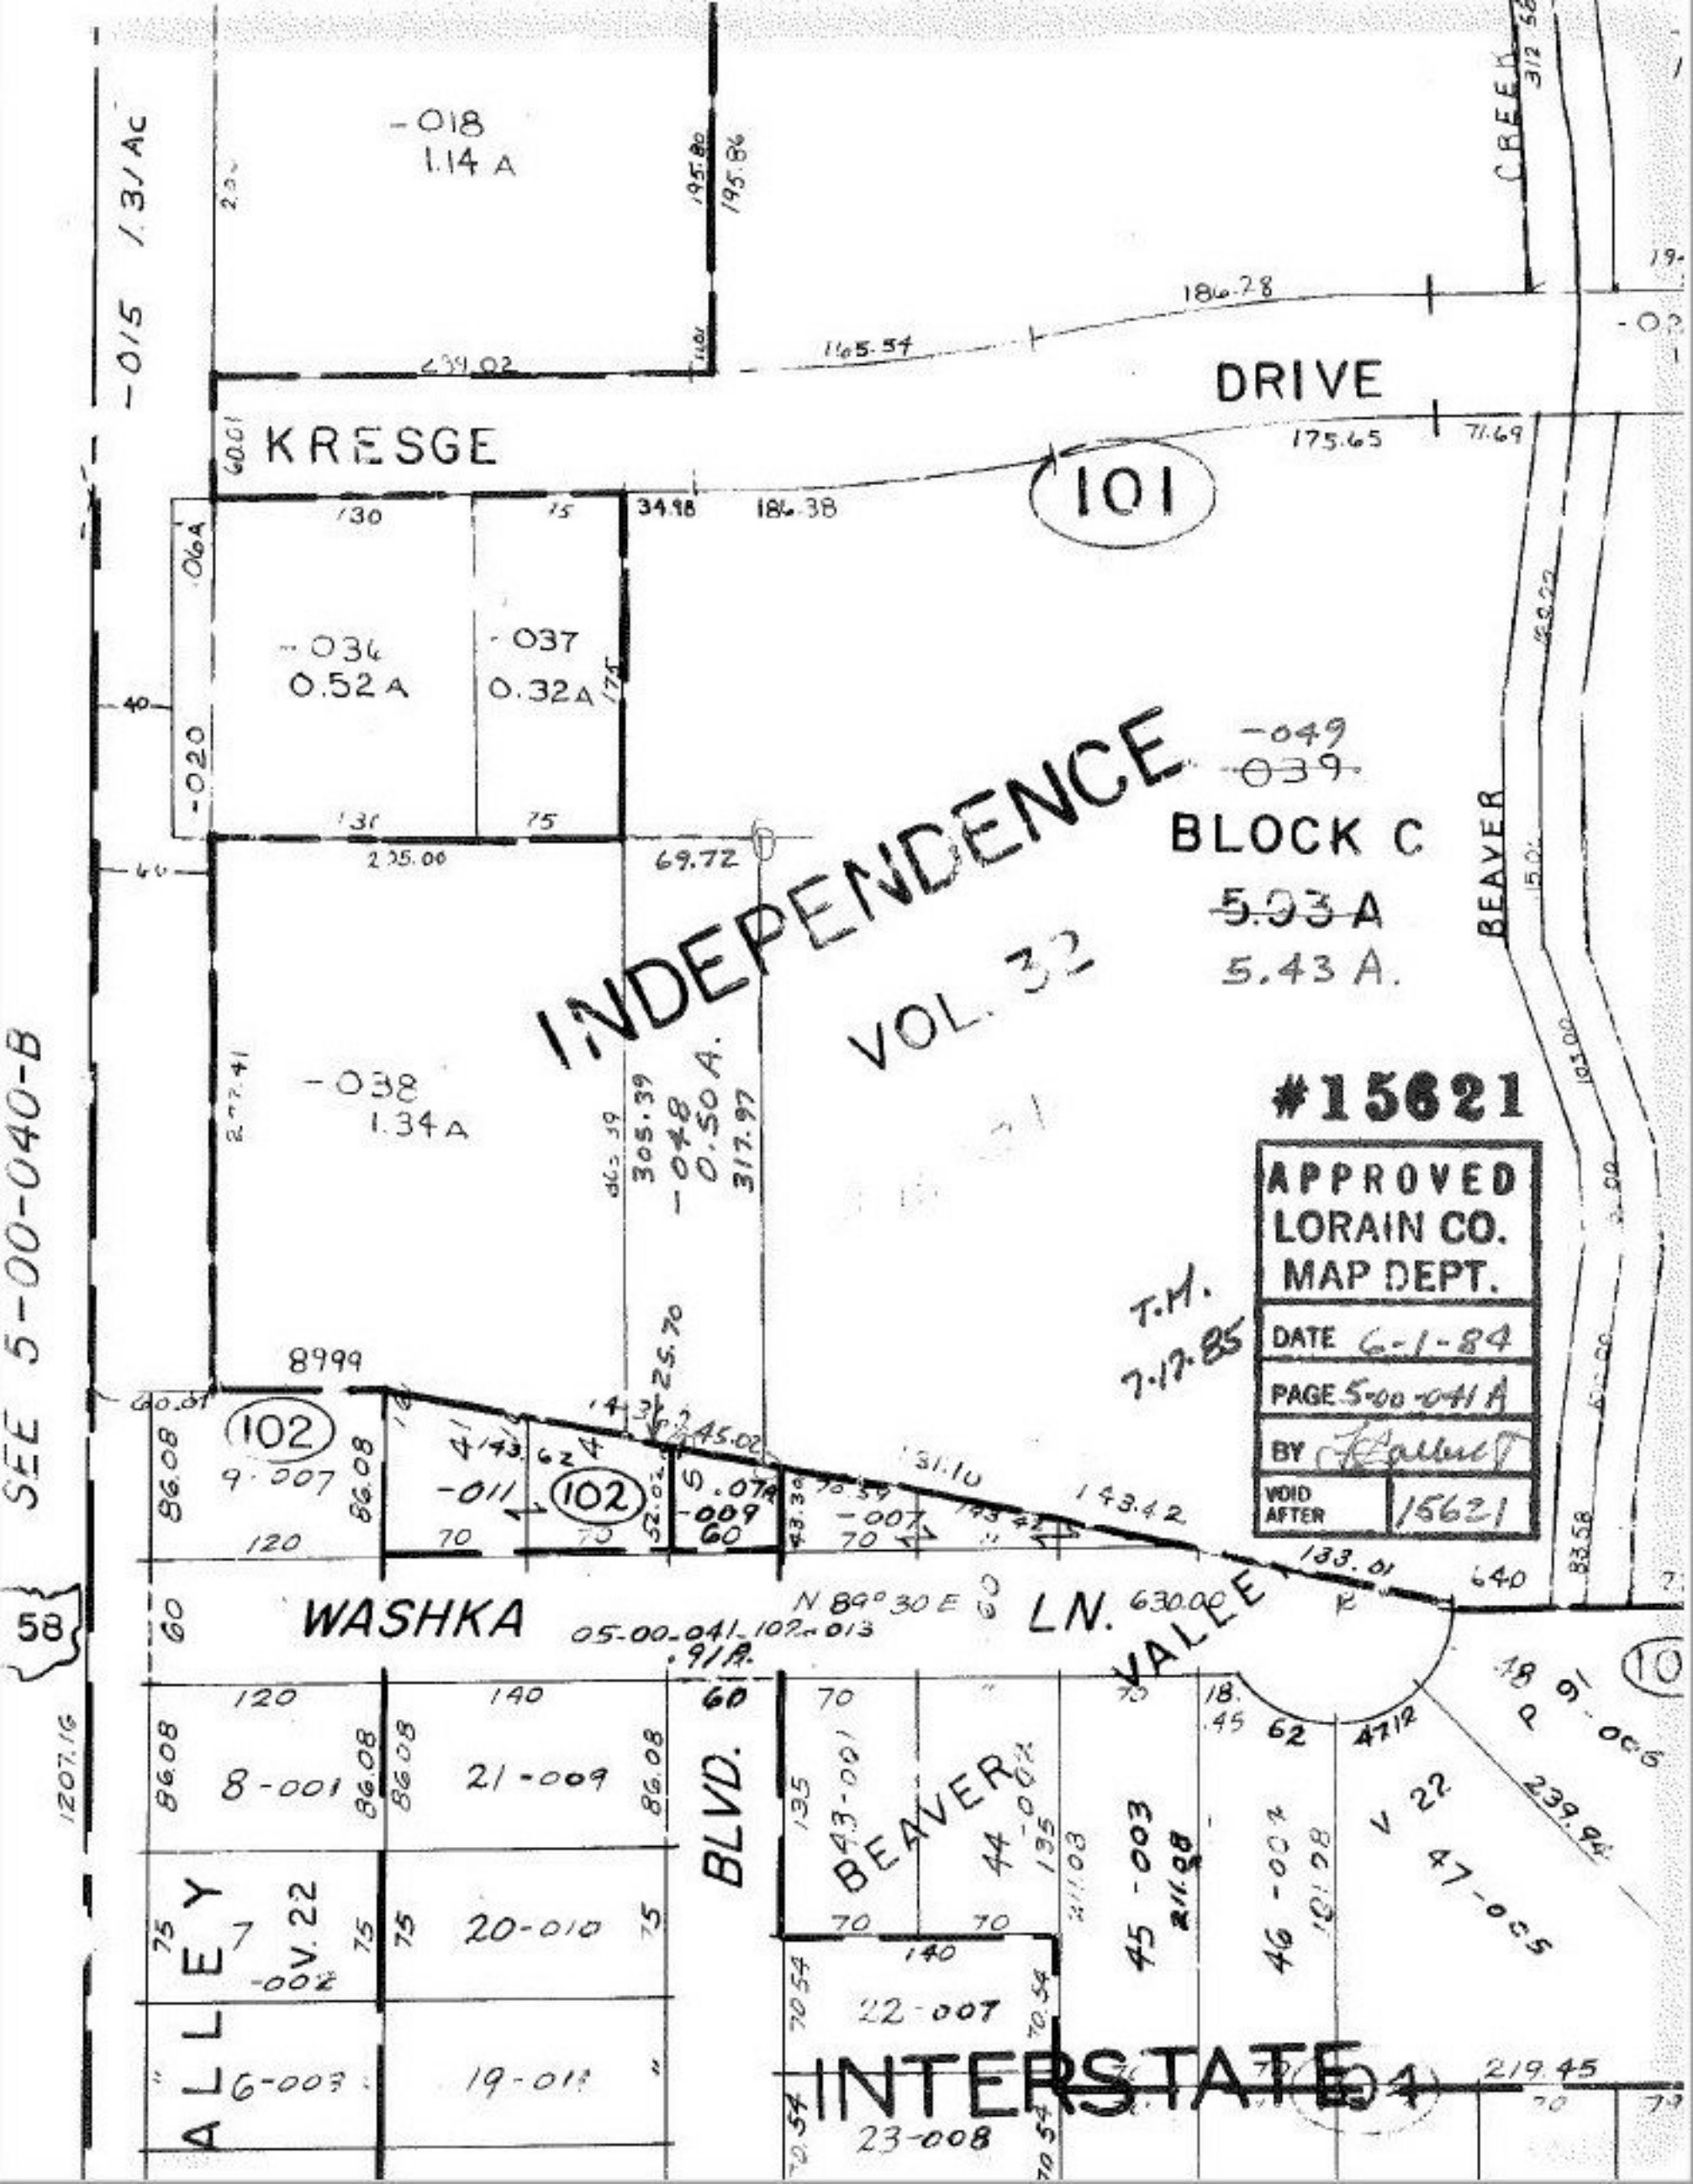

-018
1.14 A
-015 1.31 Ac
KRESGE
DRIVE
101
-036
0.52 A
-037
0.32 A
-020
-049
~~-039~~
BLOCK C
~~5.93 A~~
5.43 A.
INDEPENDENCE
VOL. 32
BEAVER
-038
1.34 A
SEE 5-00-040-B
#15621
APPROVED
LORAIN CO.
MAP DEPT.
DATE 6-1-84
PAGE 5-00-041 A
BY
VOID AFTER 15621
T.M.
7-17-85
102
9-007
-011
102
-009
-007
WASHKA
LN.
05-00-041-102-013
.91 A.
N 89° 30 E
VALLEY
BLVD.
BEAVER
8-001
21-009
20-010
22-007
23-008
6-003
19-011
ALLEY
V. 22
-002
45-003
46-004
47-005
P 91-006
V 22
INTERSTATE
58