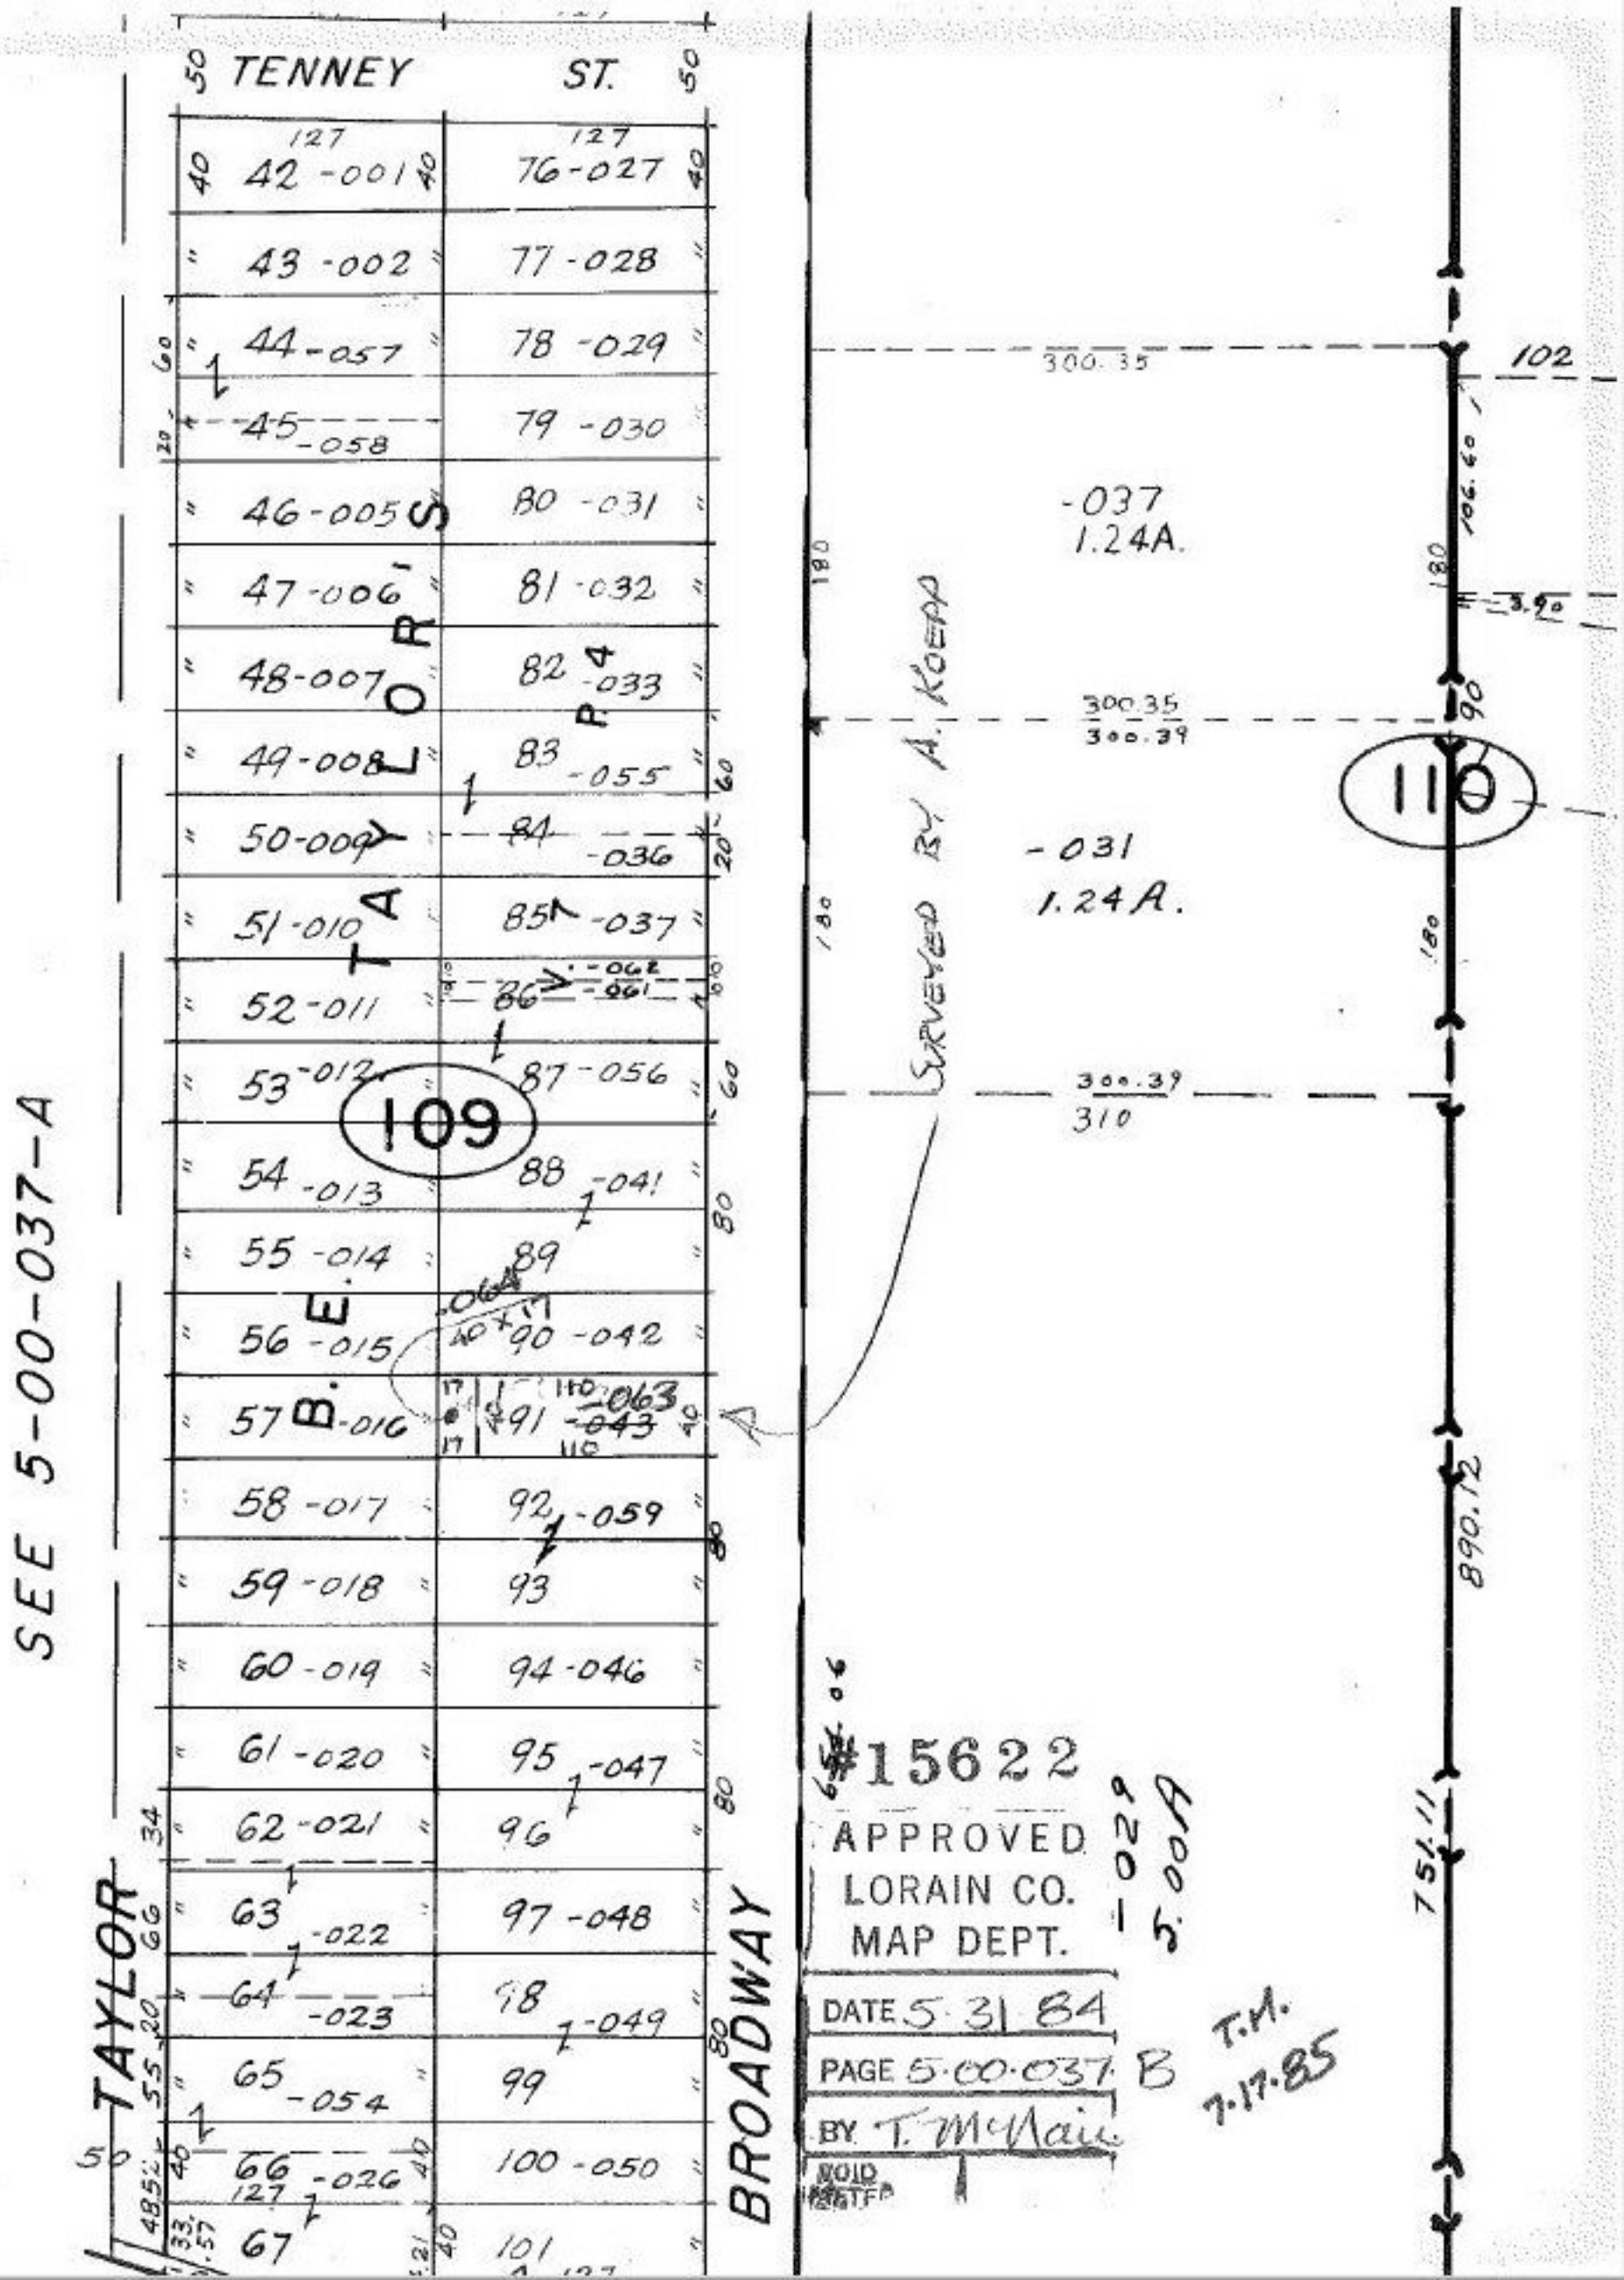

TENNEY ST.
TAYLOR'S
B. E.
R 4
TAYLOR
BROADWAY
SEE 5-00-037-A
42-001
43-002
44-057
45-058
46-005
47-006
48-007
49-008
50-009
51-010
52-011
53-012
54-013
55-014
56-015
57-016
58-017
59-018
60-019
61-020
62-021
63-022
64-023
65-054
66-026
67
76-027
77-028
78-029
79-030
80-031
81-032
82-033
83-055
84-036
85-037
86-062
-061
87-056
88-041
89
90-042
91-063
-043
92-059
93
94-046
95-047
96
97-048
98-049
99
100-050
101
109
110
300.35
102
-037
1.24A.
300.35
300.39
-031
1.24A.
300.39
310
SURVEYED BY A. KOEPP
890.12
751.11
#15622
APPROVED
LORAIN CO.
MAP DEPT.
DATE 5-31-84
PAGE 5-00-037 B
BY T. McNair
T.M.
7.17.85