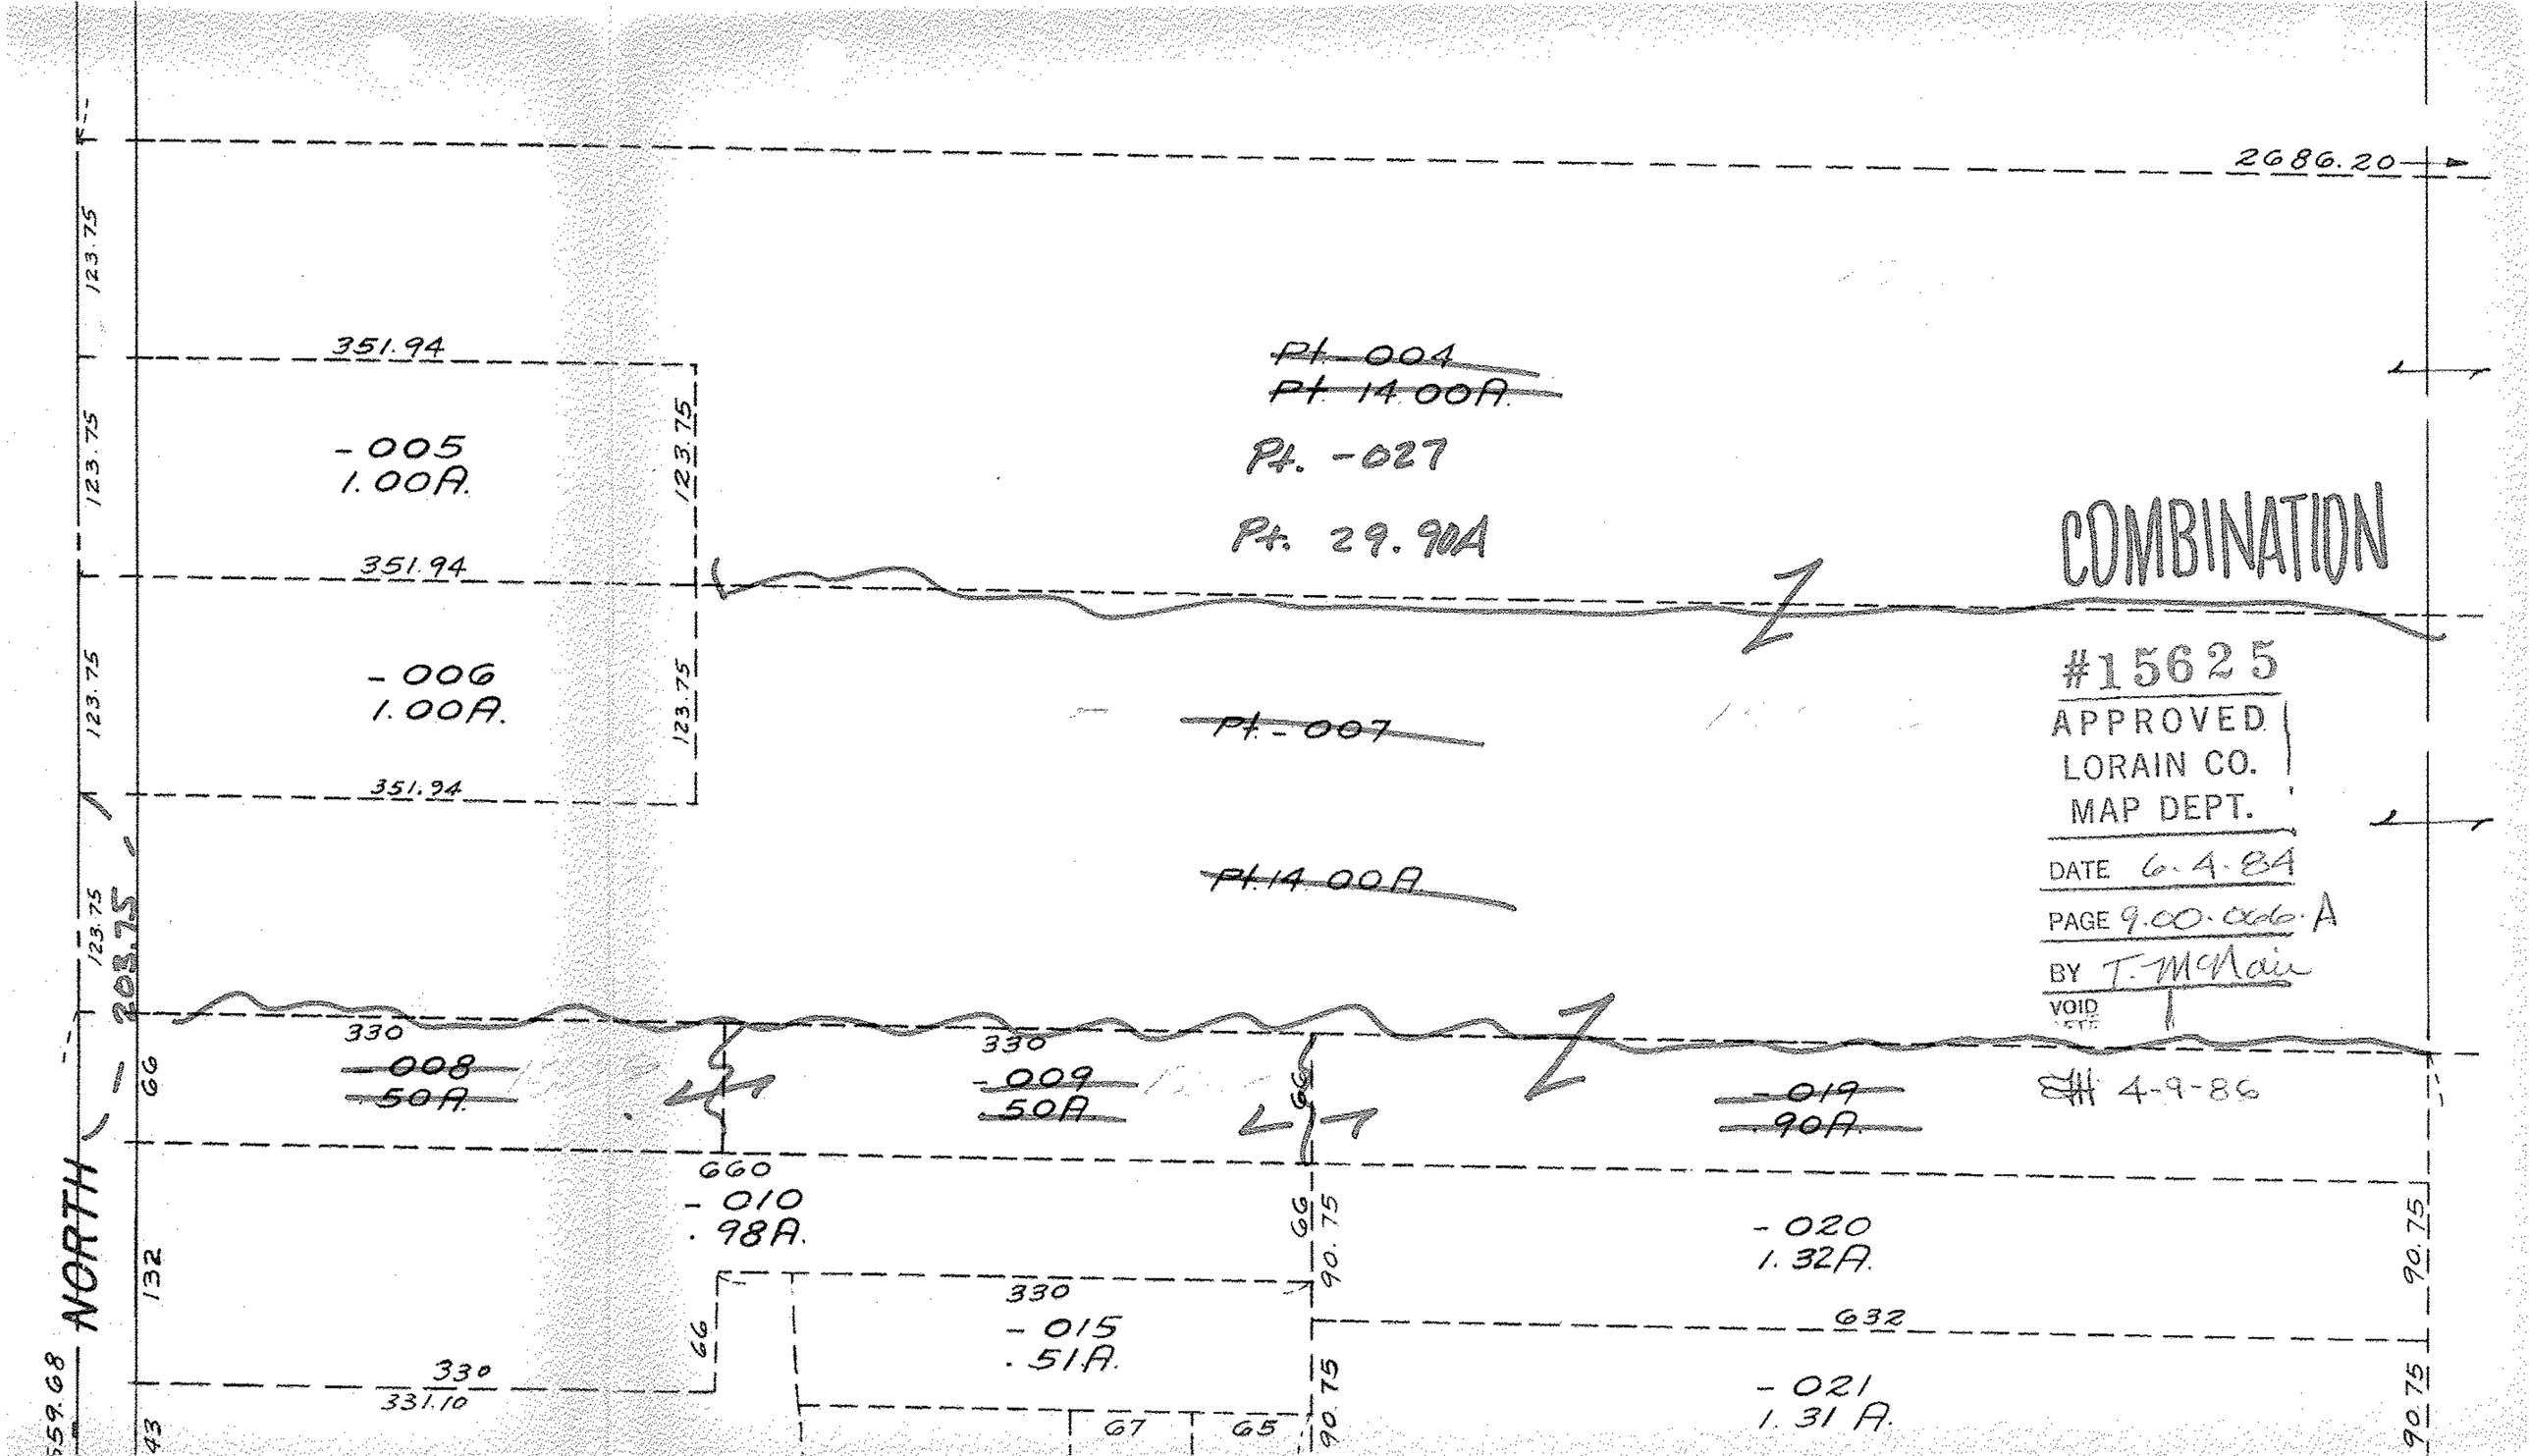
2686.20
123.75
351.94
-005
1.00A.
123.75
351.94
-006
1.00A.
123.75
351.94
123.75
203.75
NORTH
Pt. 004
Pt. 14.00A.
Pt. -027
Pt. 29.90A
Pt. -007
Pt. 14.00A.
COMBINATION
#15625
APPROVED
LORAIN CO.
MAP DEPT.
DATE 6.4.84
PAGE 9.00.066.A
BY T. McNair
VOID
4-9-86
330
-008
.50A.
330
-009
.50A.
-019
.90A.
66
660
-010
.98A.
66
90.75
-020
1.32A.
90.75
132
330
-015
.51A.
632
66
330
331.10
-021
1.31 A.
90.75
67
65
90.75
559.68
43