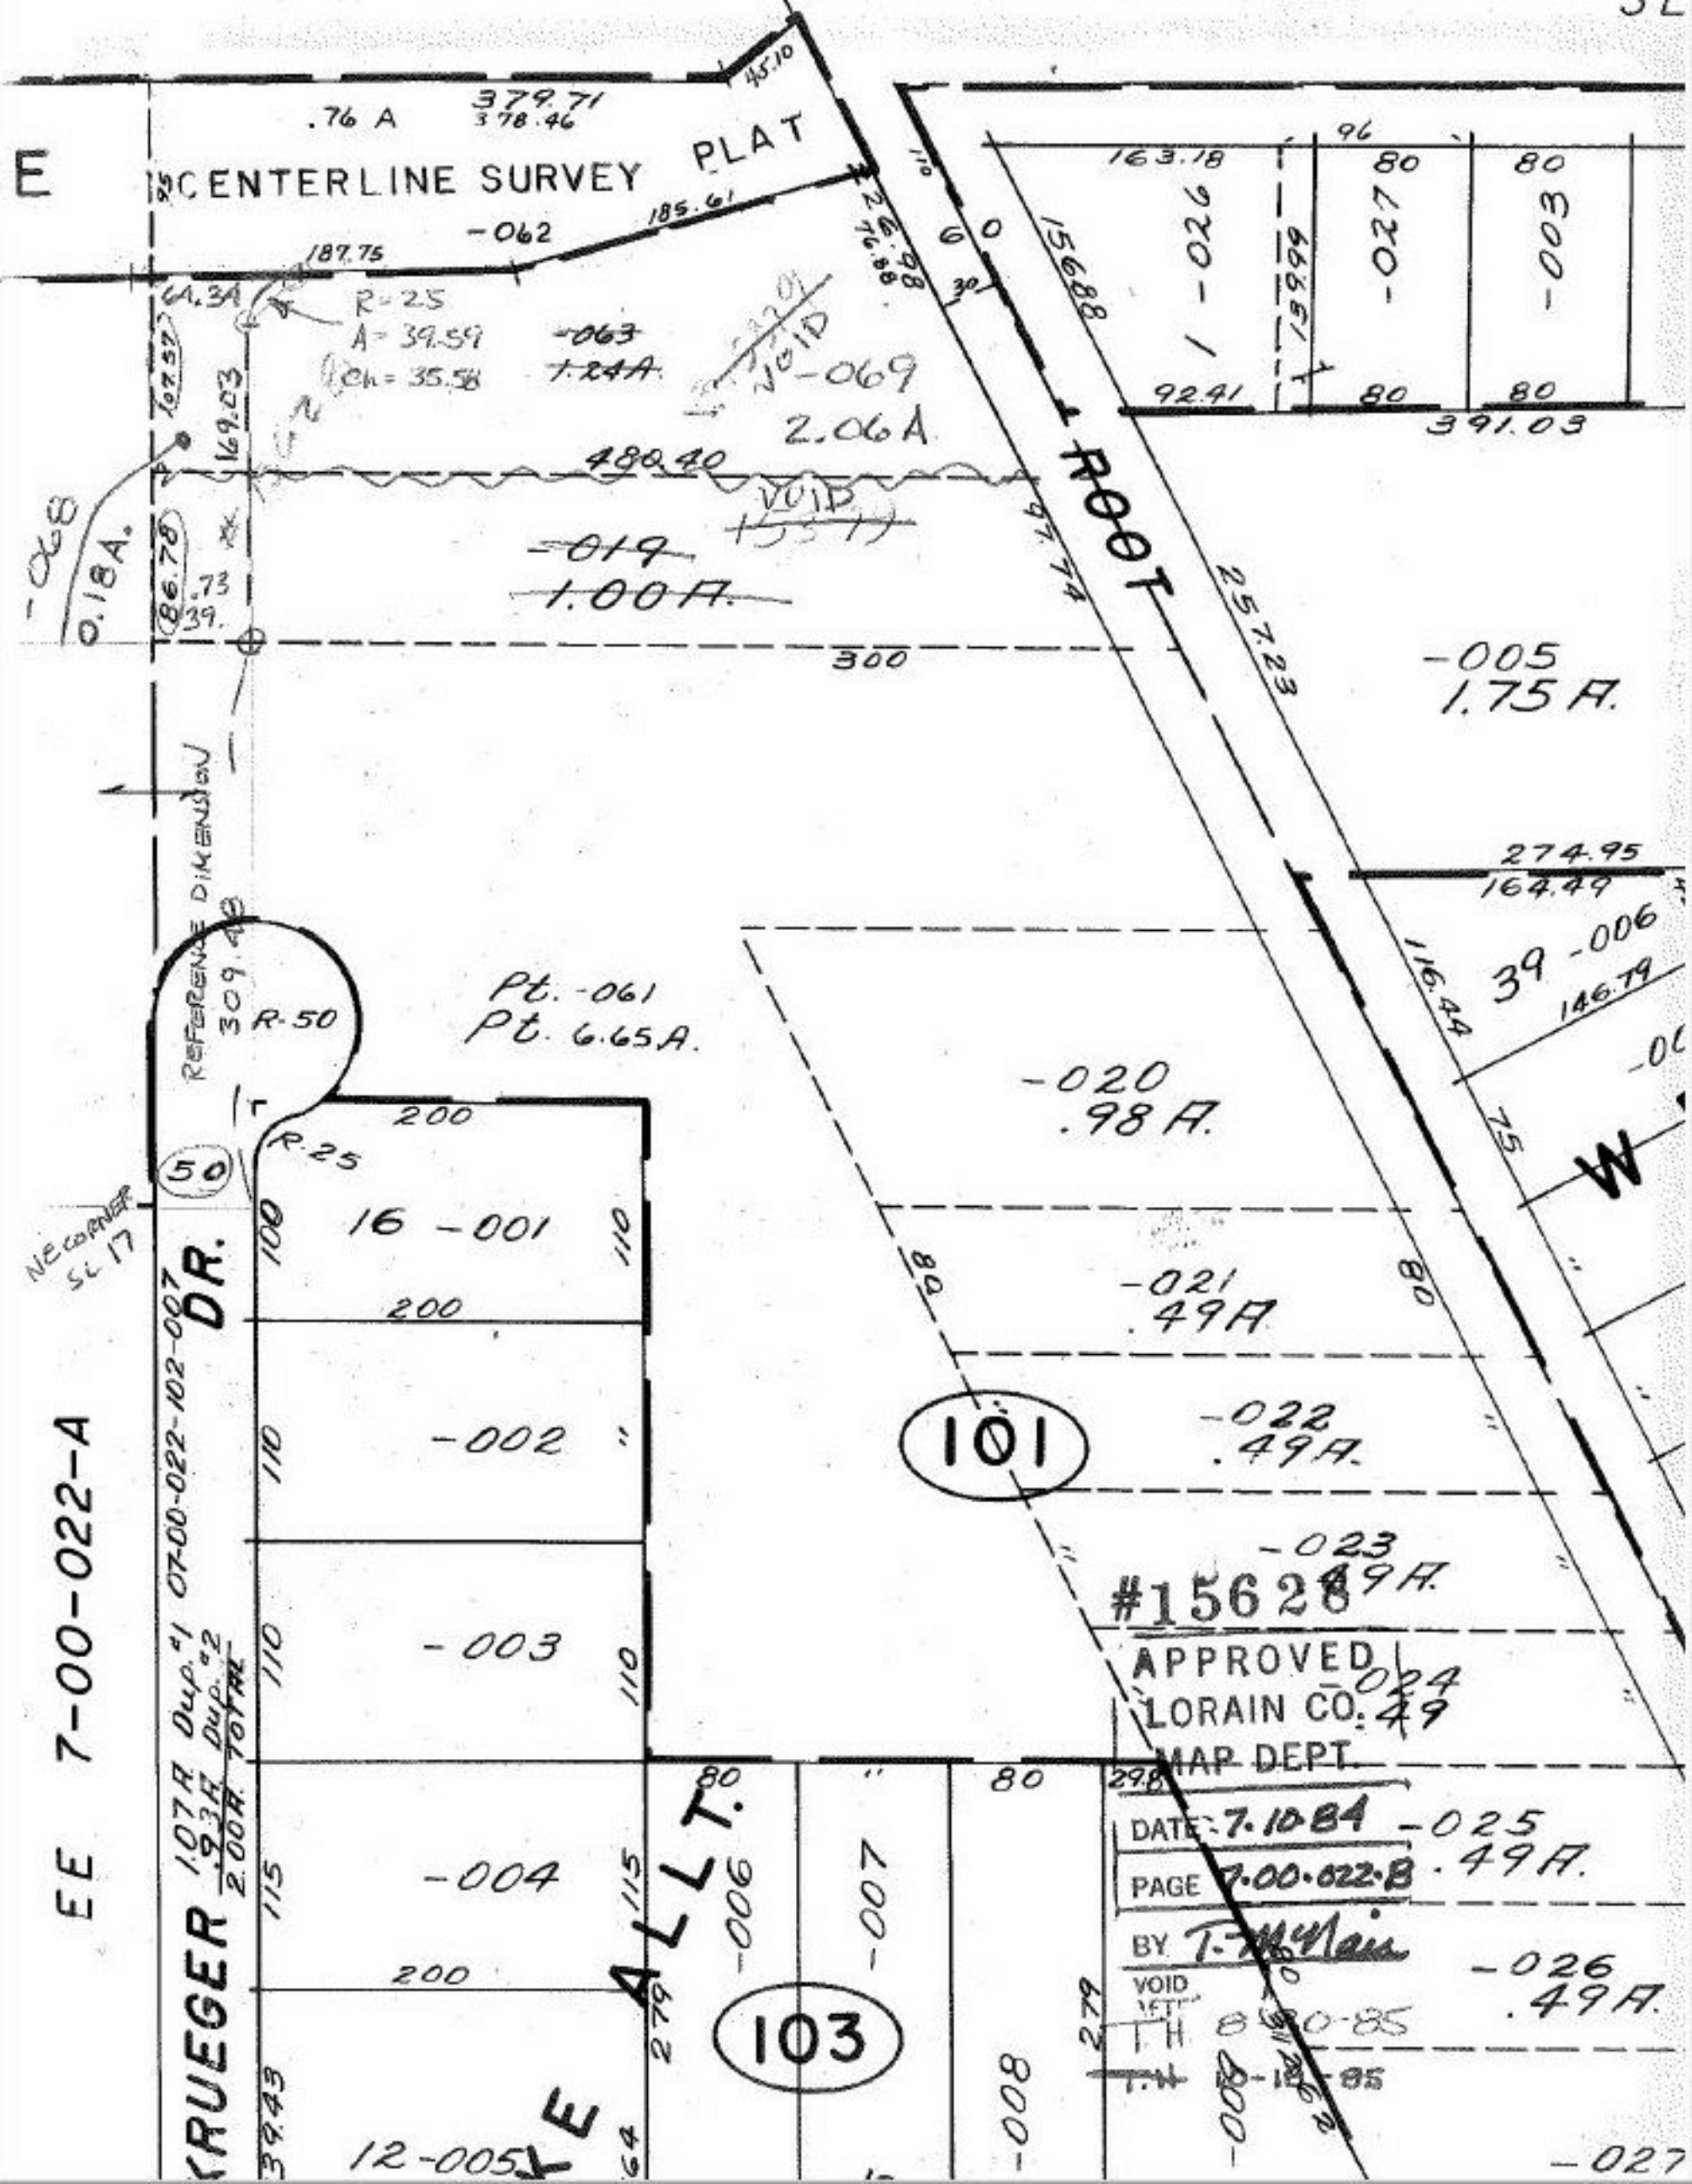

CENTERLINE SURVEY PLAT
.76 A
379.71
378.46
45.10
-062
185.61
187.75
64.34
R=25
A=39.59
Ch=35.58
-063
1.24A
VOID
-069
2.06A
480.40
VOID
-019
1.00A.
-068
0.18A.
86.78
.73
39.
169.03
107.57
300
ROOT
163.18
96
80
80
1-026
-027
-003
139.99
156.88
92.41
80
80
391.03
257.23
-005
1.75A.
274.95
164.49
39-006
146.79
116.44
75
W
Pt.-061
Pt. 6.65A.
REFERENCE DIMENSION
309.48
R-50
R-25
200
50
NE CORNER SL 17
16-001
100
110
200
-002
110
-003
110
-004
115
200
-020
.98A.
-021
.49A
-022
.49A.
-023
.49A.
-024
.49
-025
.49A.
-026
.49A.
101
#15628
APPROVED
LORAIN CO.
MAP DEPT.
DATE 7.10.84
PAGE 7.00.022.B
BY T. McNair
VOID
T.H. 8-30-85
T.H. 10-18-85
EE 7-00-022-A
KRUEGER DR.
1.07A Dup. #1 07-00-022-102-007
.93A Dup. #2
2.00A TOTAL
ALLT.
-006
-007
-008
-009
103
279
12-005
39.43
-027