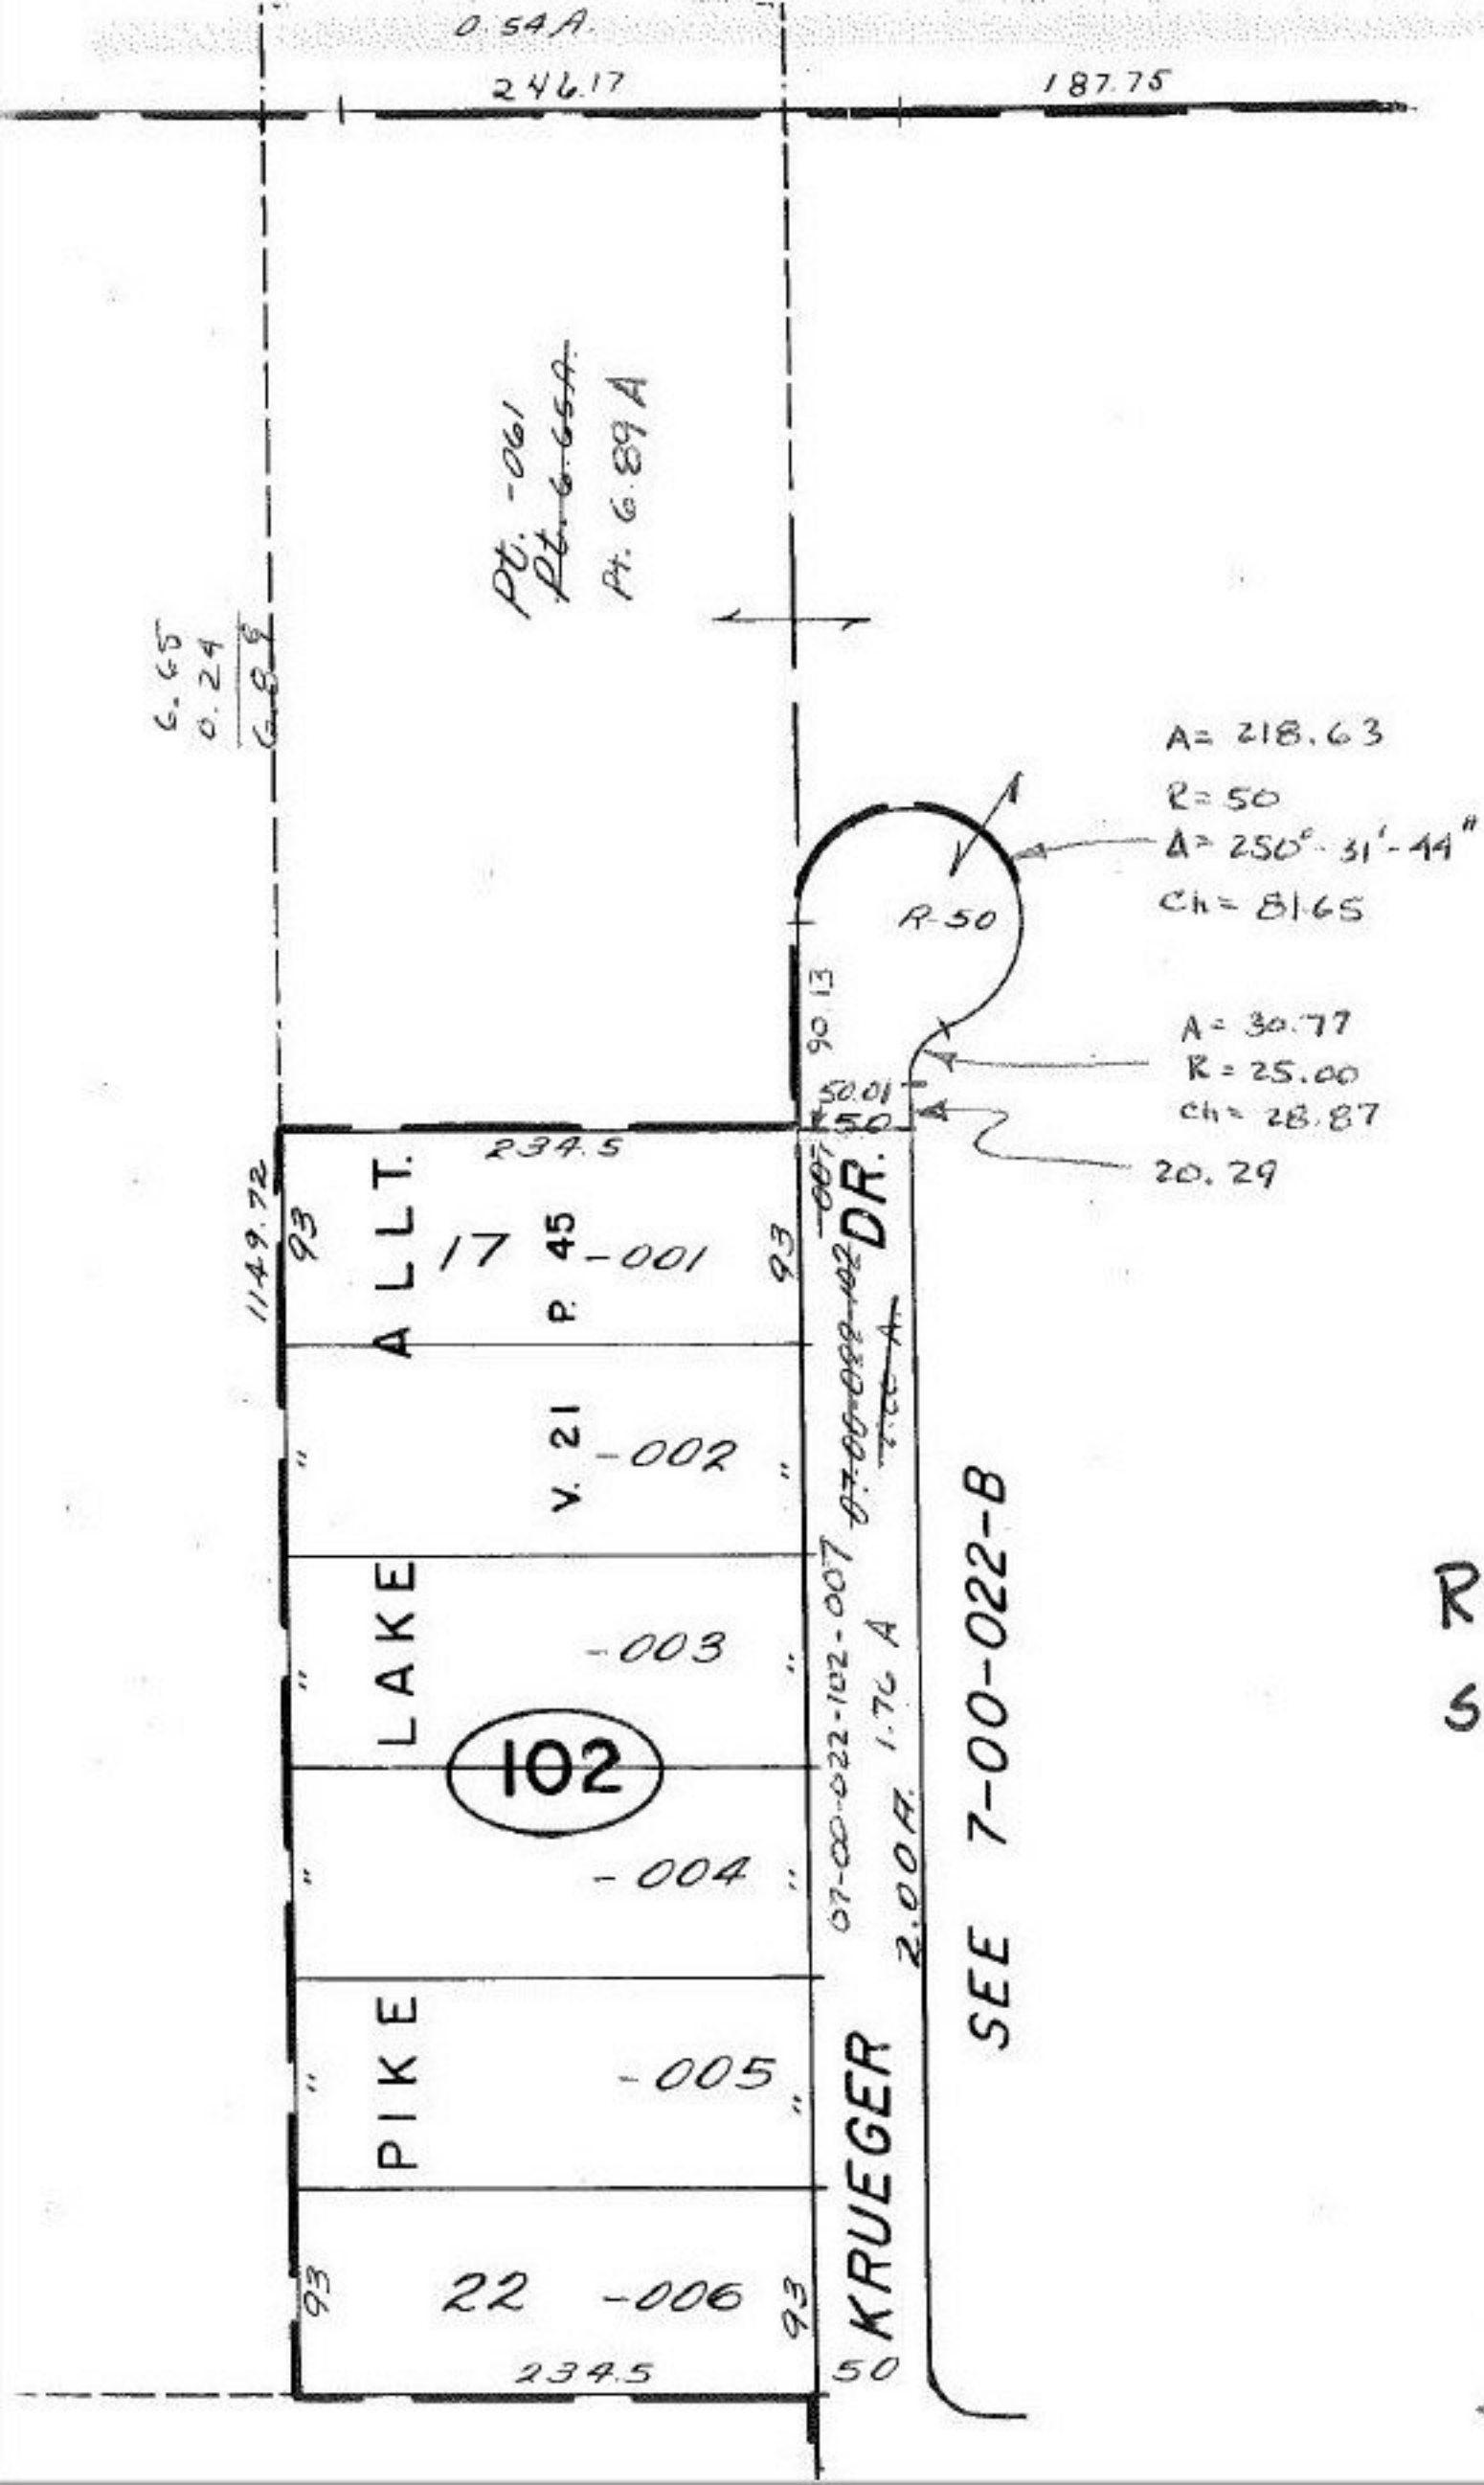

ROAD VACATION
SIZE CORRECTION

#15630

APPROVED
LORAIN CO.
MAP DEPT.

DATE 7.9.84
PAGE 7.00.022.A
BY T. McNair
VOID
AFTER
TH 10-18-85