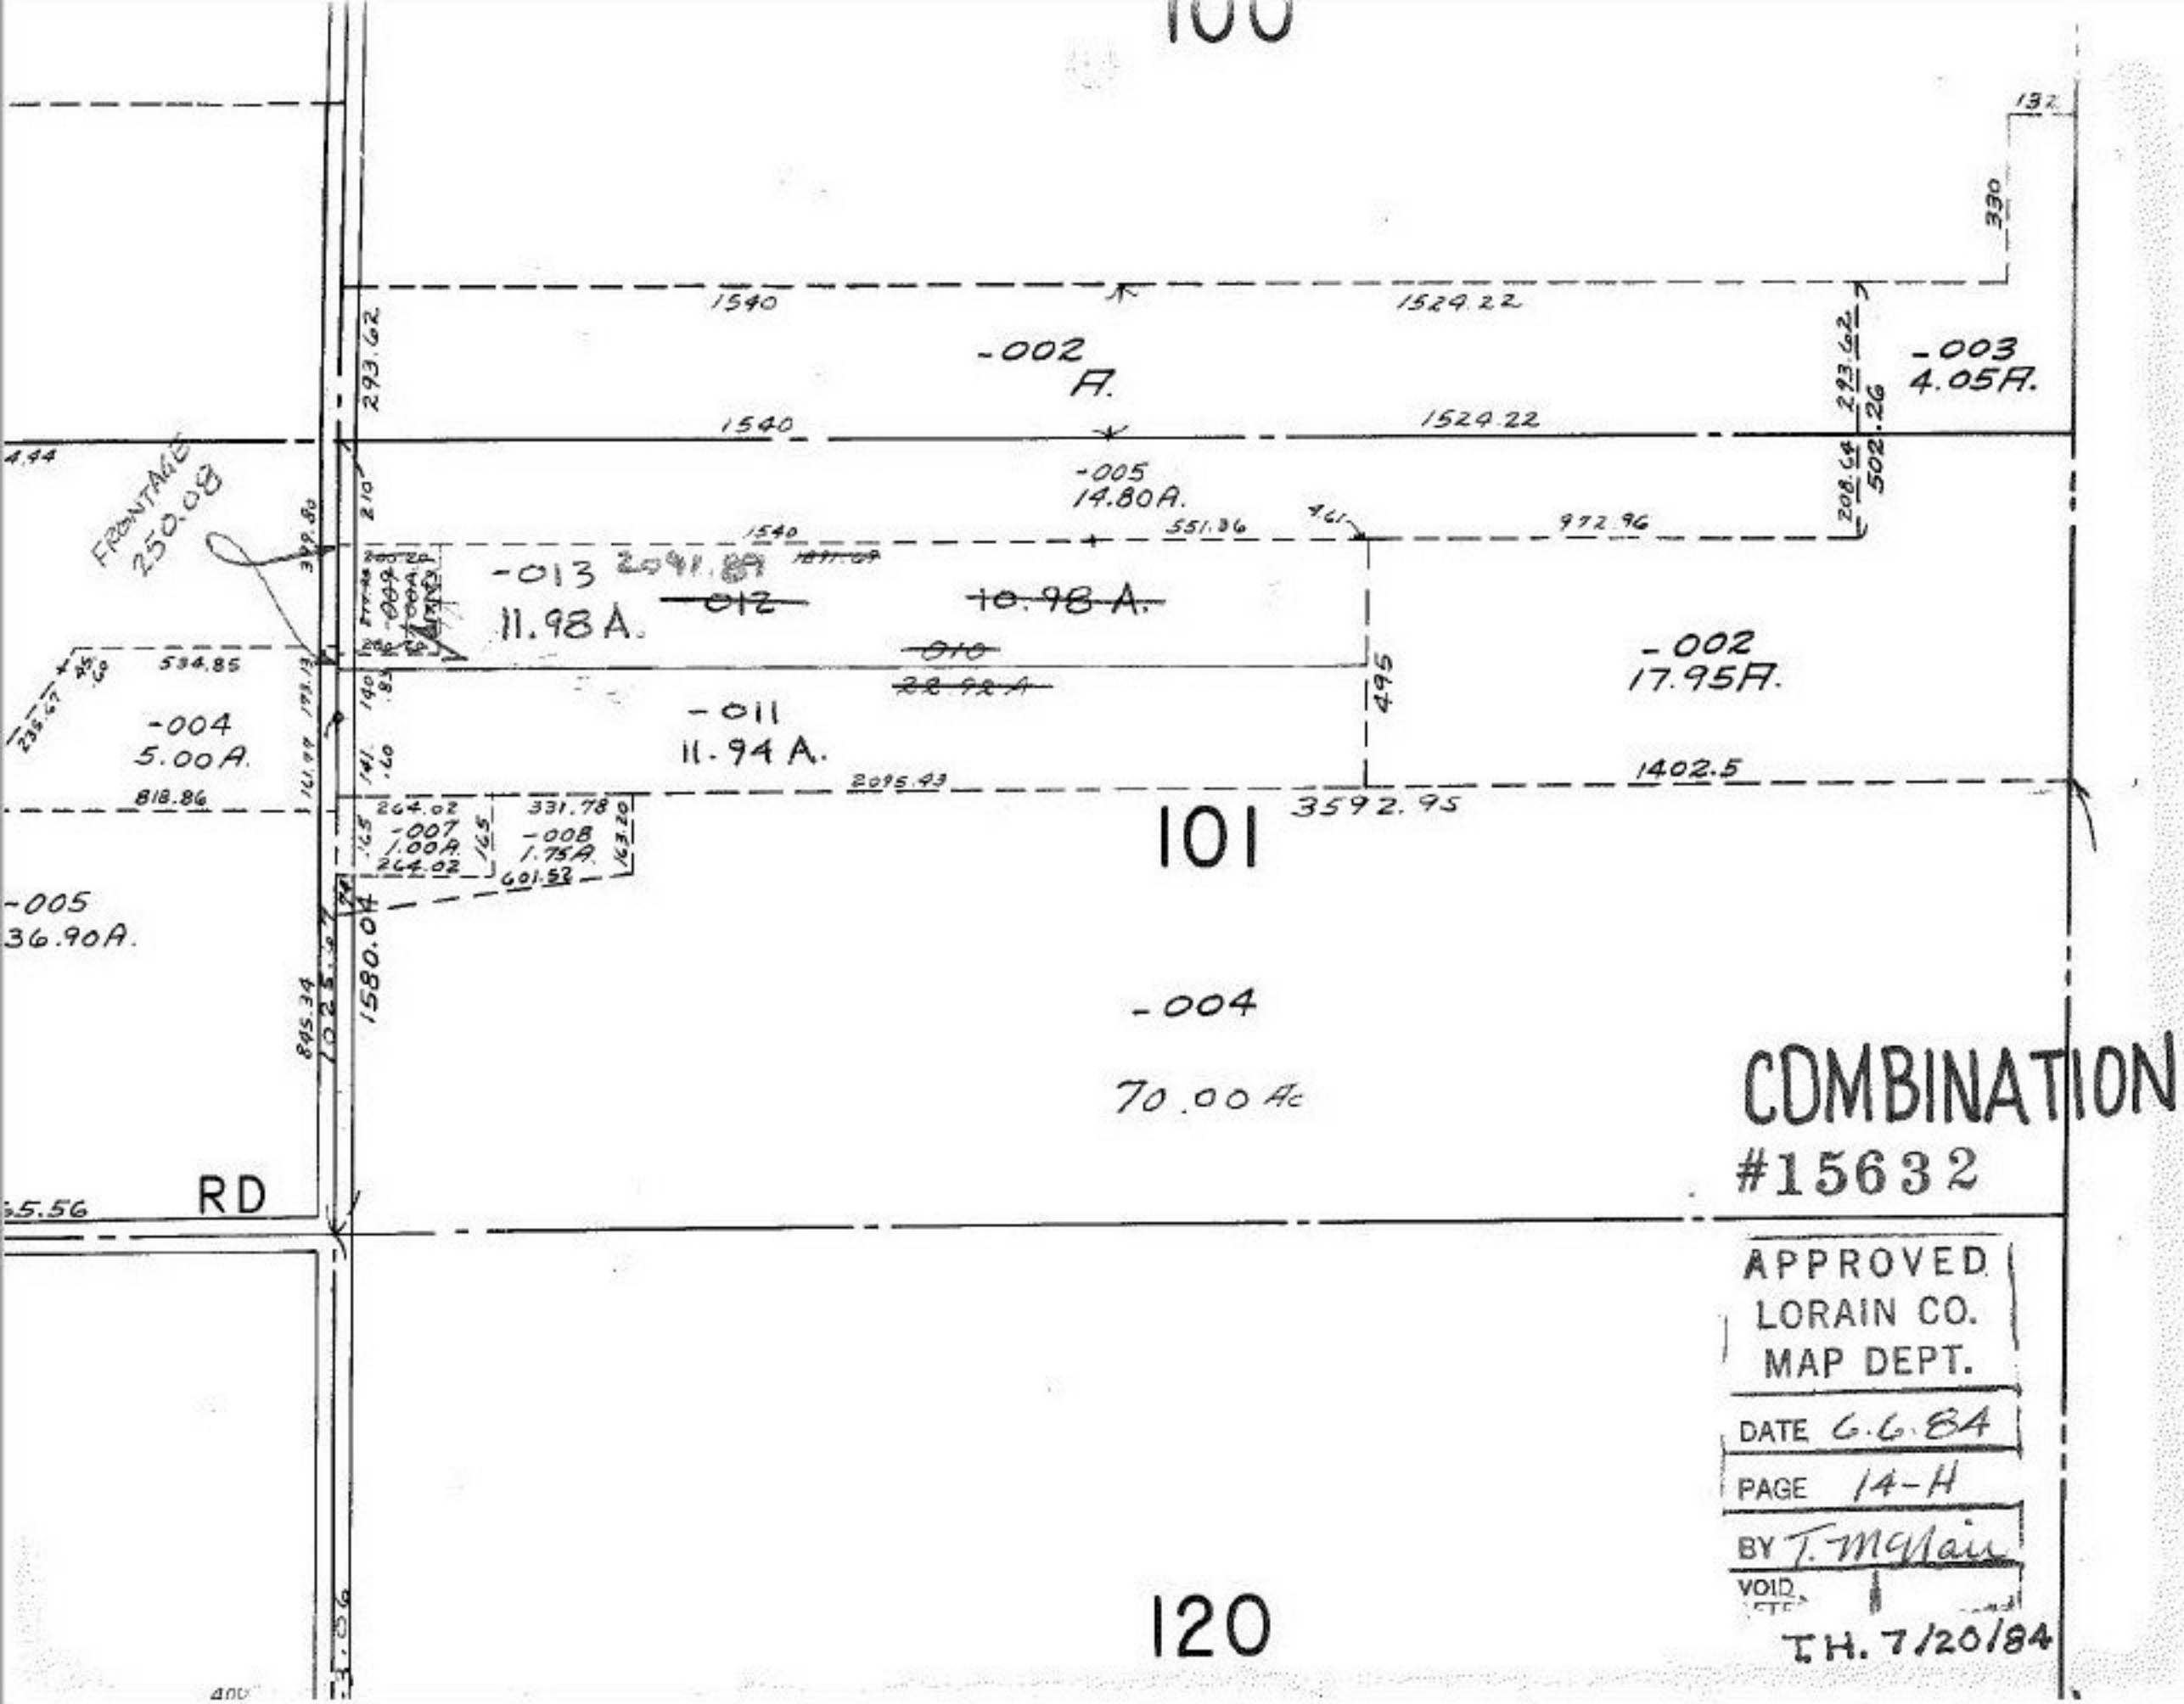
100
101
120
RD
-002
A.
-003
4.05A.
-005
14.80A.
-013
11.98A.
~~-012~~
~~10.98 A.~~
~~-010~~
~~22.92 A~~
-011
11.94 A.
-002
17.95A.
-004
5.00A.
-005
36.90A.
-007
1.00A.
-008
1.75A.
-004
70.00 Ac
FRONTAGE
250.08
1540
1524.22
293.62
502.26
208.64
551.36
972.96
495
1402.5
3592.95
2095.43
2091.89
534.85
818.86
264.02
331.78
601.52
1580.04
845.34
330
132
COMBINATION
#15632
APPROVED
LORAIN CO.
MAP DEPT.
DATE 6.6.84
PAGE 14-H
BY T. McNair
VOID
T.H. 7/20/84