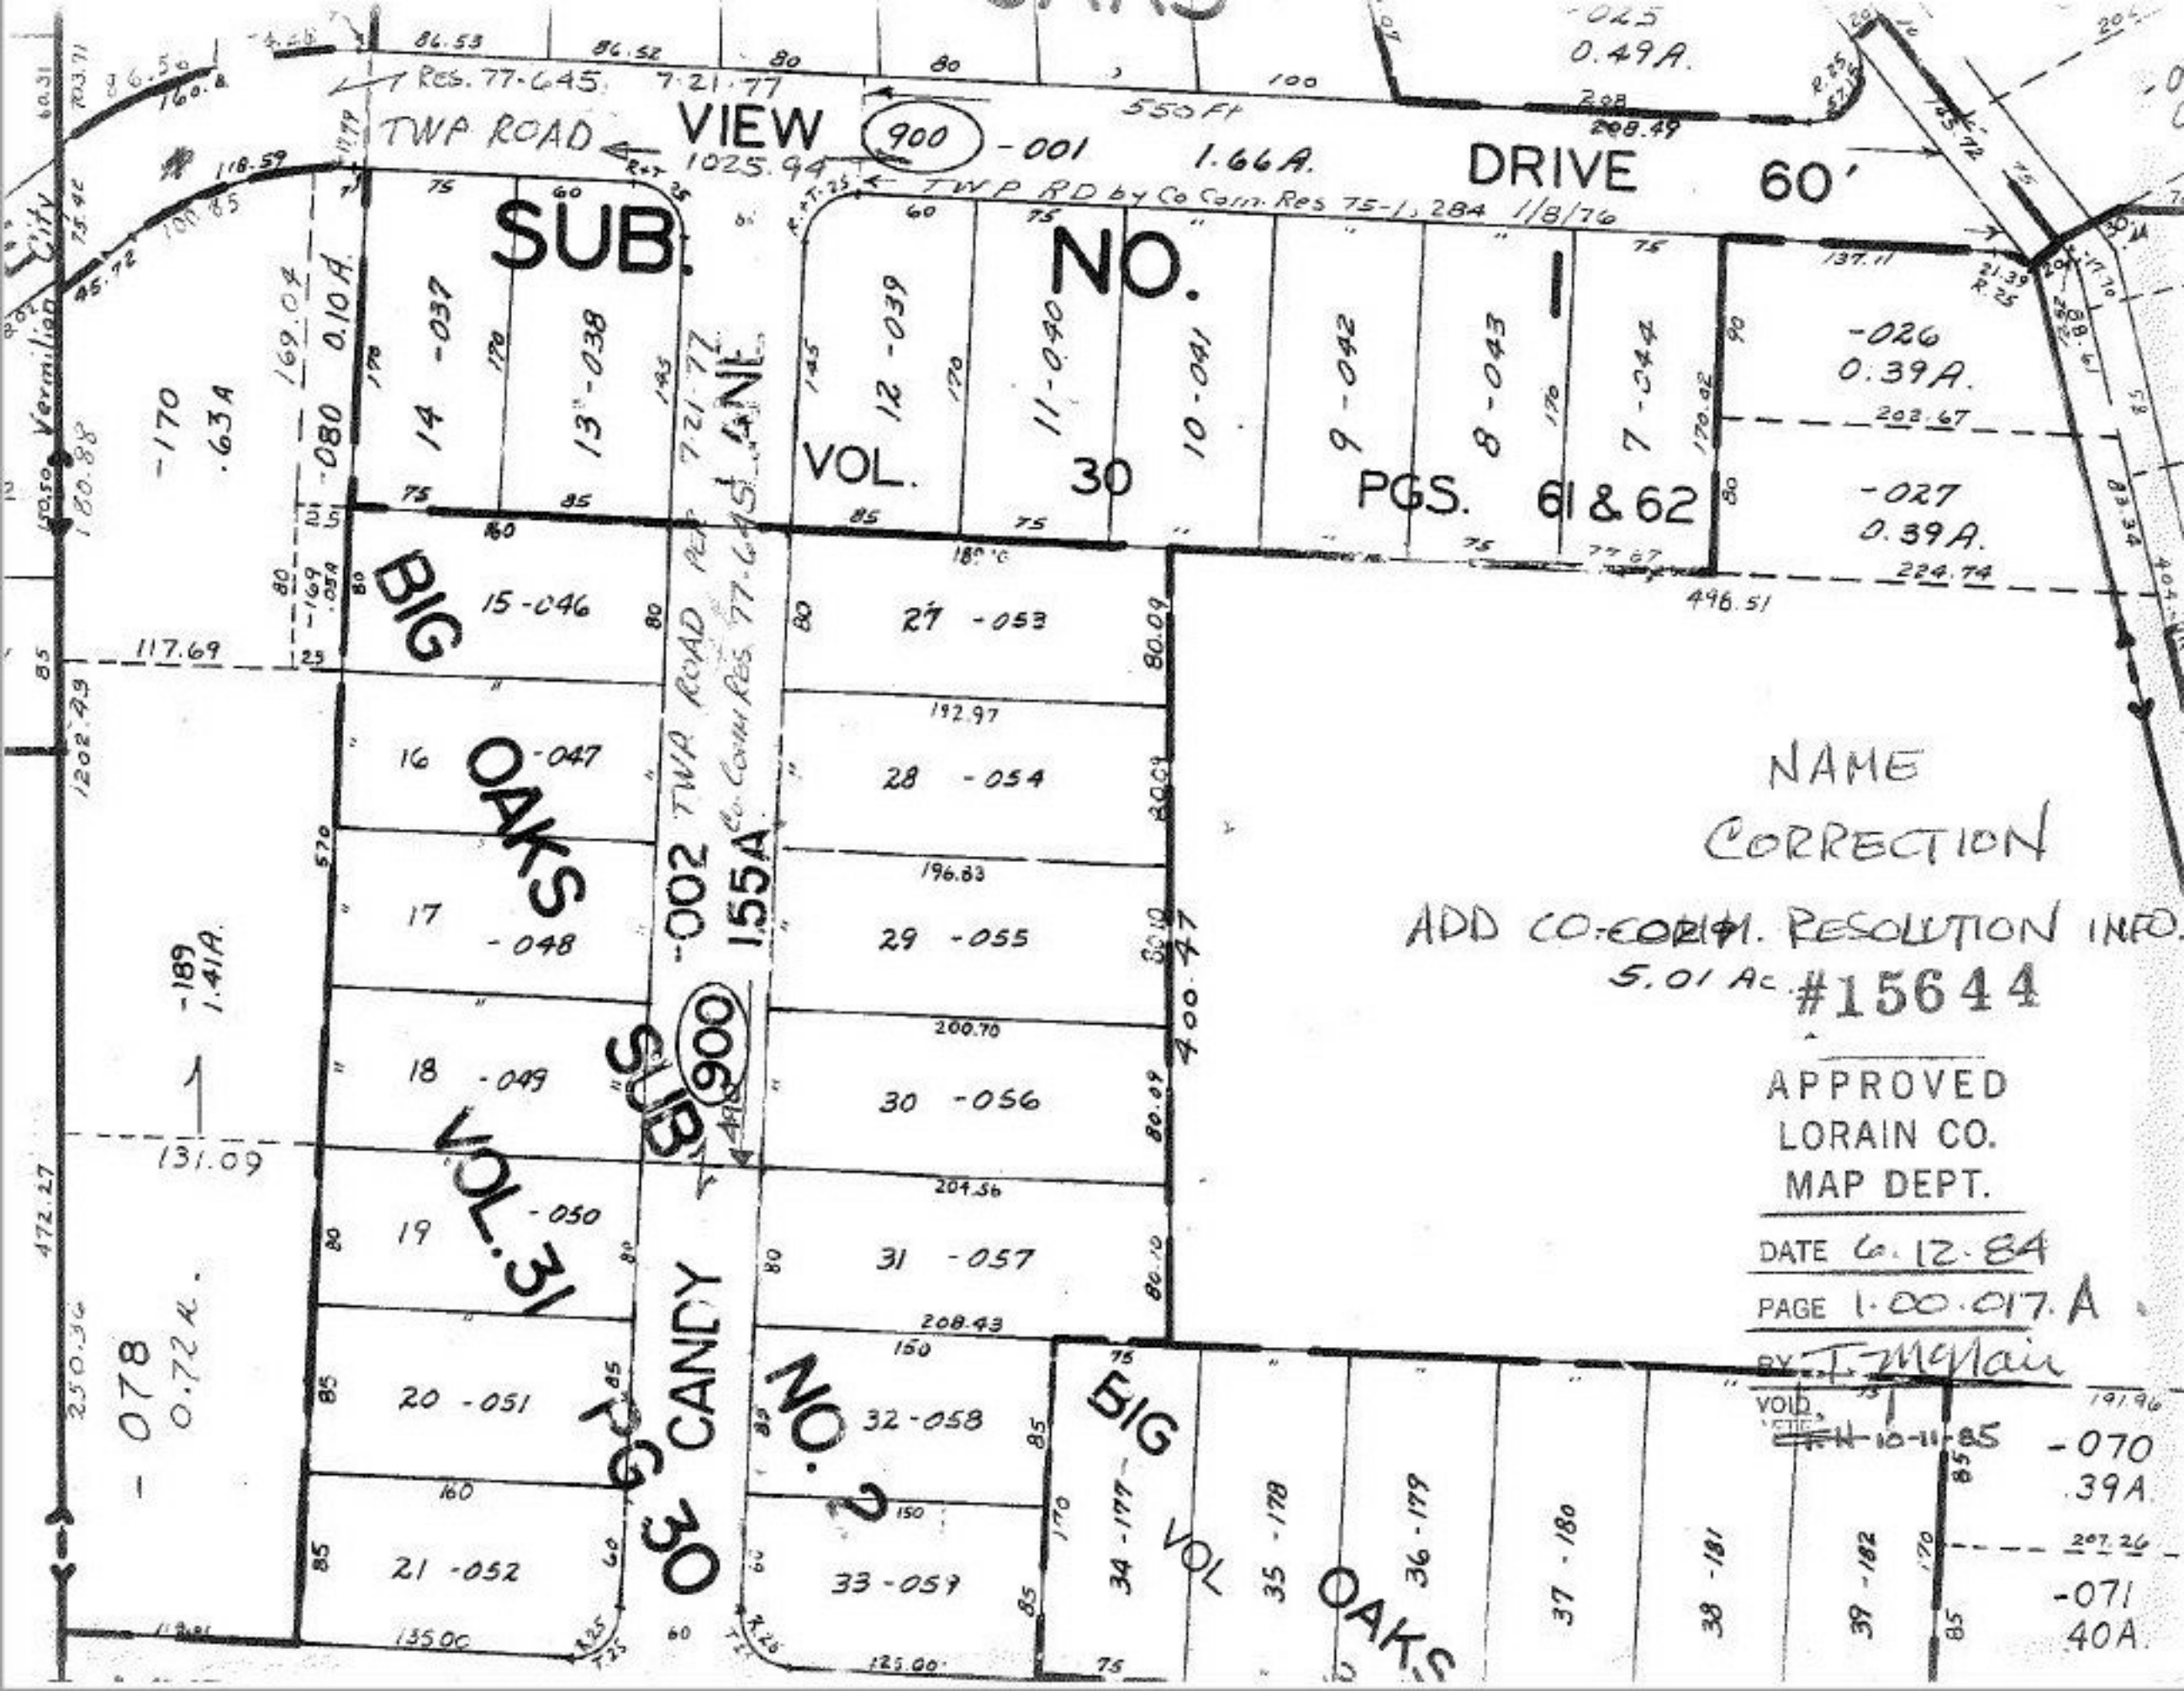

VIEW
900
-001
1.66A.
DRIVE
60'
TWP ROAD
1025.94
TWP RD by Co Com. Res 75-1,284 1/8/76
Res. 77-645 7-21-77
550 Ft
SUB.
NO.
1
VOL.
30
PGS.
61 & 62
-026
0.39A.
-027
0.39A.
-025
0.49A.
BIG
OAKS
VOL. 31
PG 30
CANDY
NO. 2
SUB
900
-002
1.55A
TWP ROAD PER 7-21-77
Co. Com. Res. 77-645
15-046
16 -047
17 -048
18 -049
19 -050
20 -051
21 -052
27 -053
28 -054
29 -055
30 -056
31 -057
32 -058
33 -059
34 -177
35 -178
36 -179
37 -180
38 -181
39 -182
-170
.63A
-080
0.10A.
-189
1.41A.
-078
0.72A.
-070
.39A.
-071
40A.
NAME
CORRECTION
ADD CO-COM. RESOLUTION INFO.
5.01 Ac.
#15644
APPROVED
LORAIN CO.
MAP DEPT.
DATE 6.12.84
PAGE 1.00.017.A
BY T. McNair
VOID
10-11-85