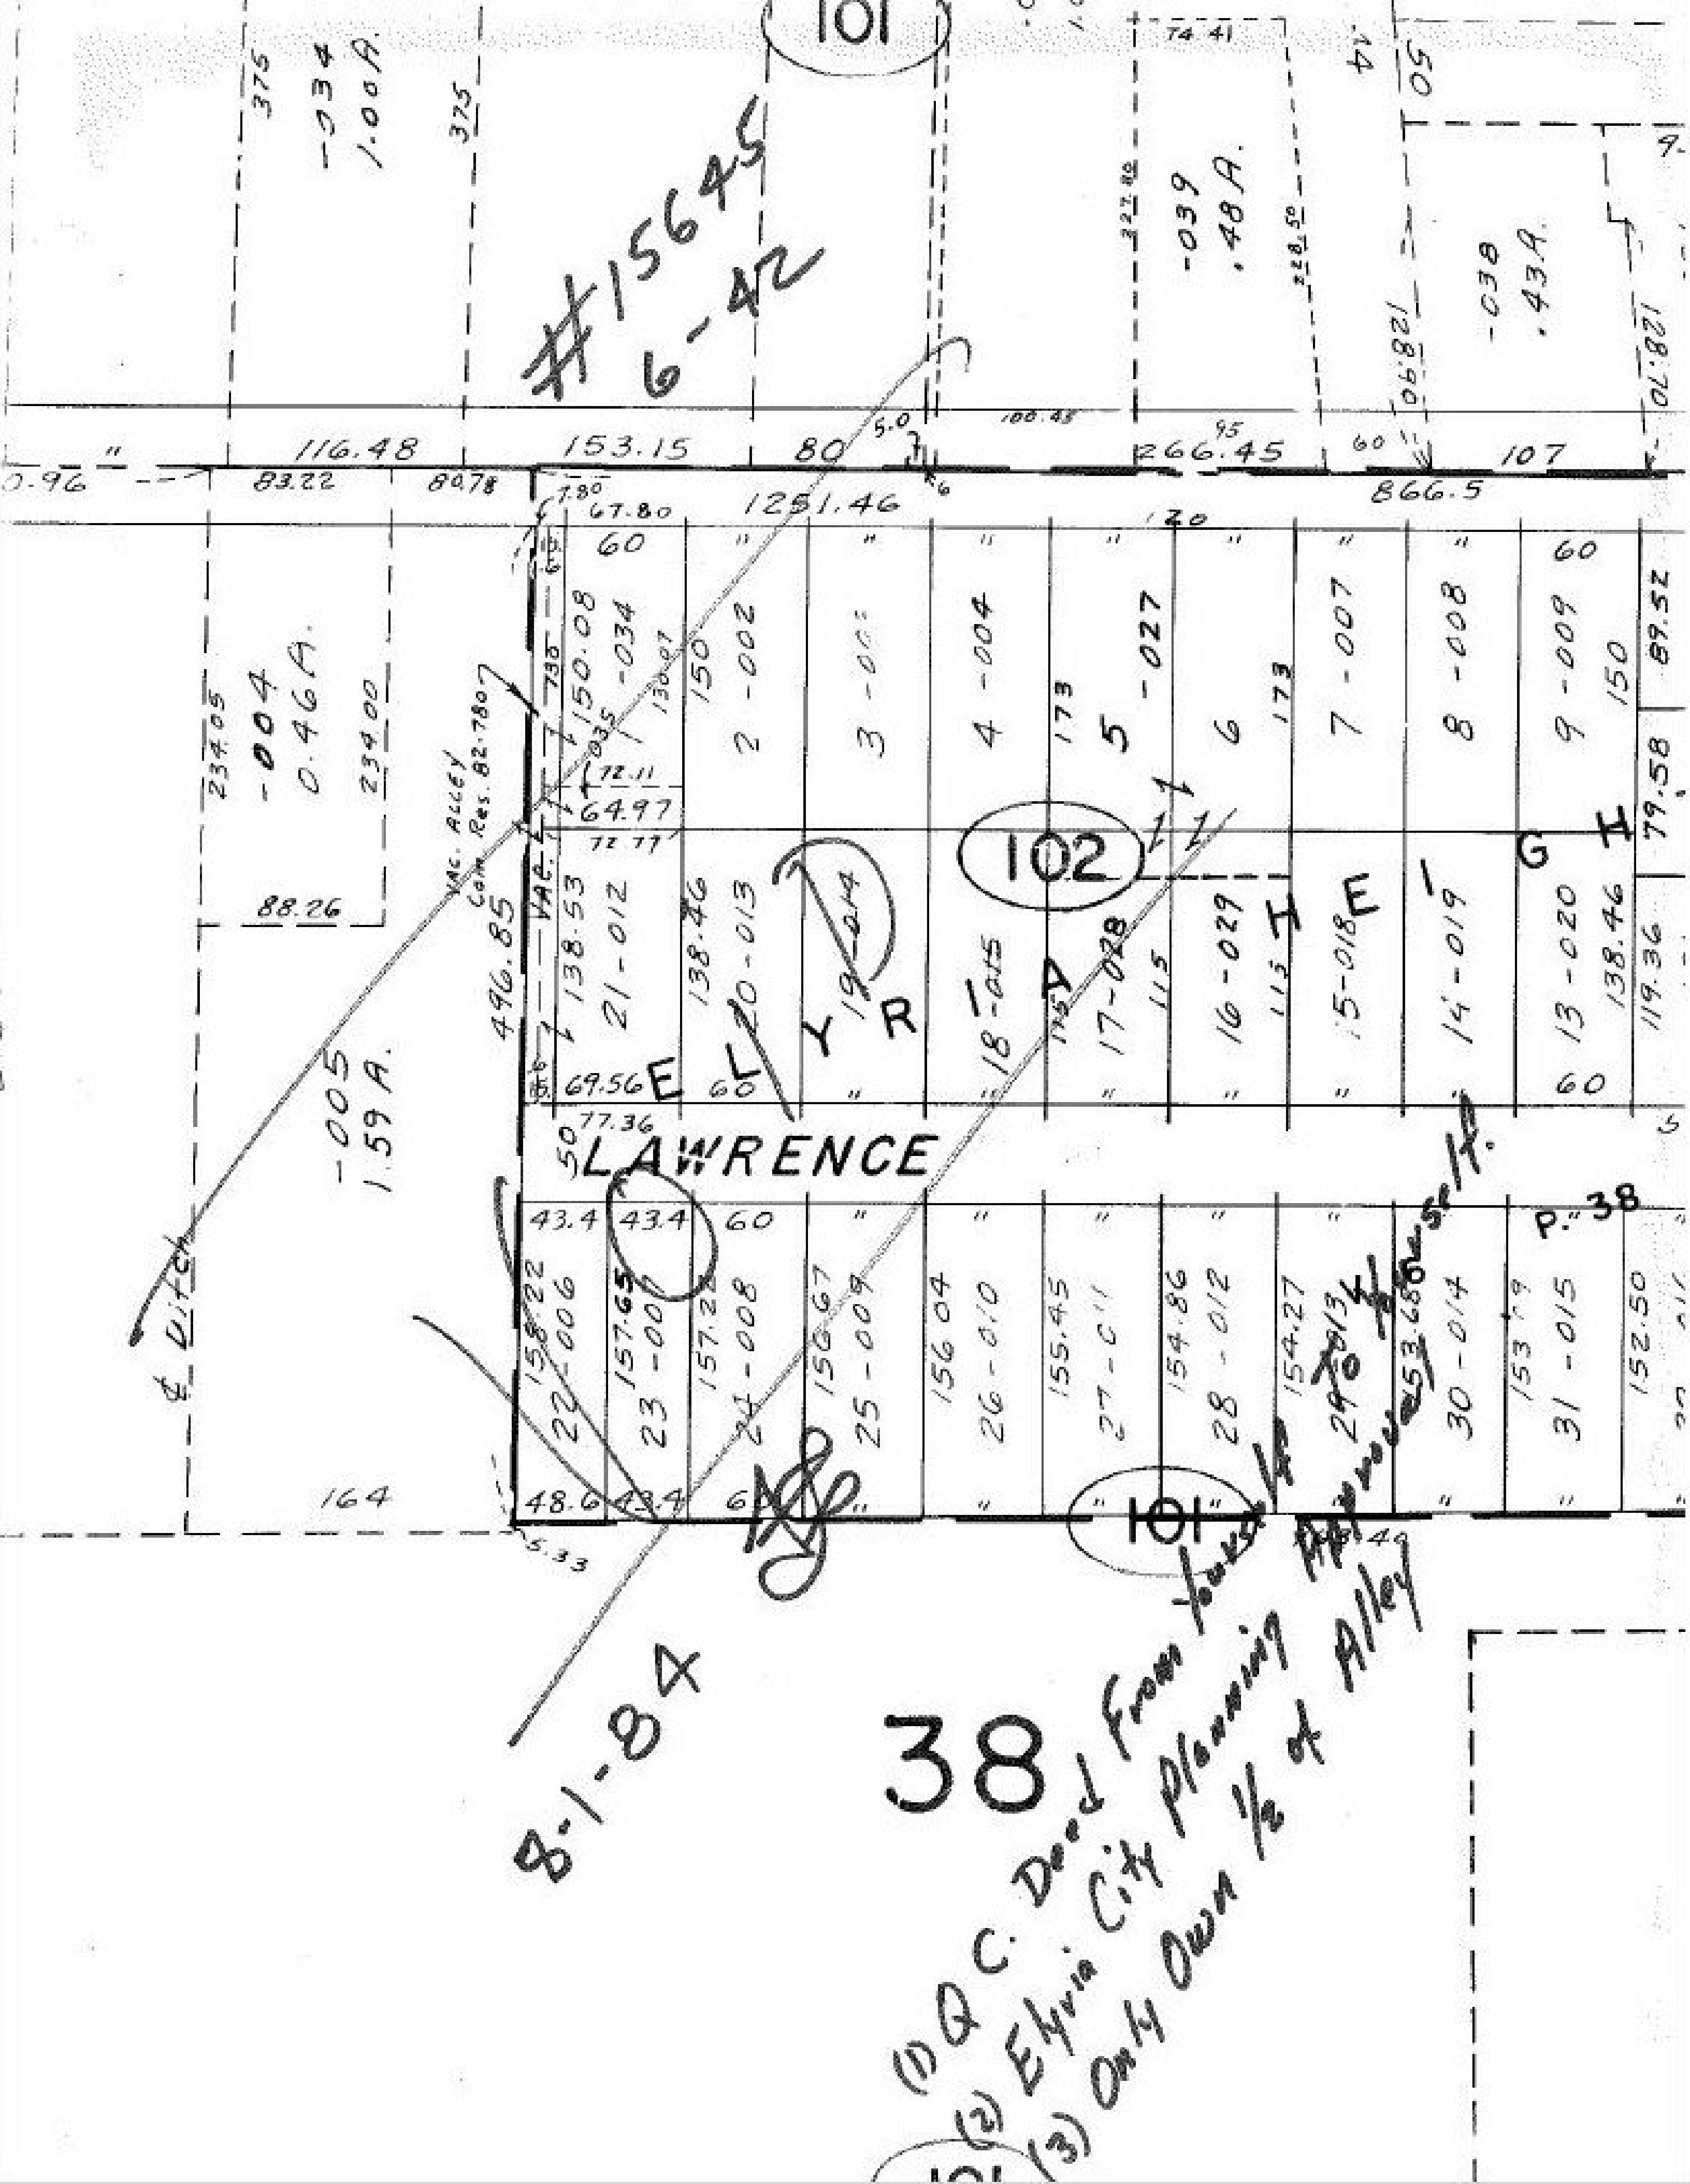

#15645
6-42
101
102
101
ELYRIA HEIGHTS
LAWRENCE
P. 38
38
-034 1.00 A.
-039 .48 A.
-038 .43 A.
-004 0.46 A.
-005 1.59 A.
VAC. ALLEY Com. Res. 82-780
VAC.
℄ Ditch
116.48
153.15
266.45
866.5
1251.46
496.85
8-1-84
(1) Q.C. Deed From Township to Himself.
(2) Elyria City Planning Approval
(3) Only Own 1/2 of Alley